

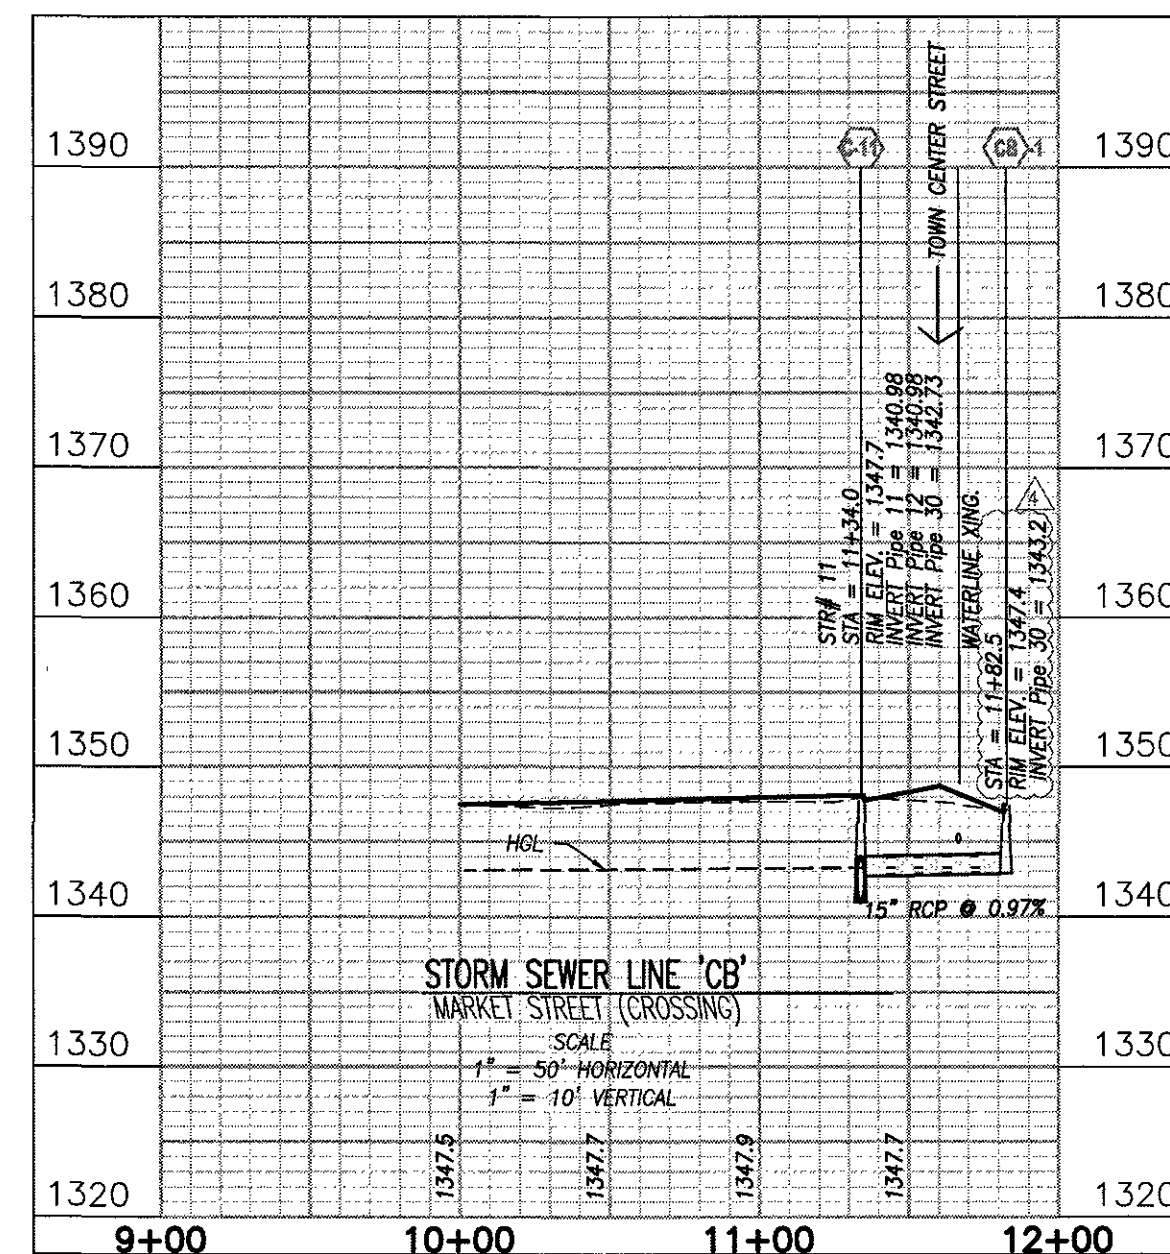
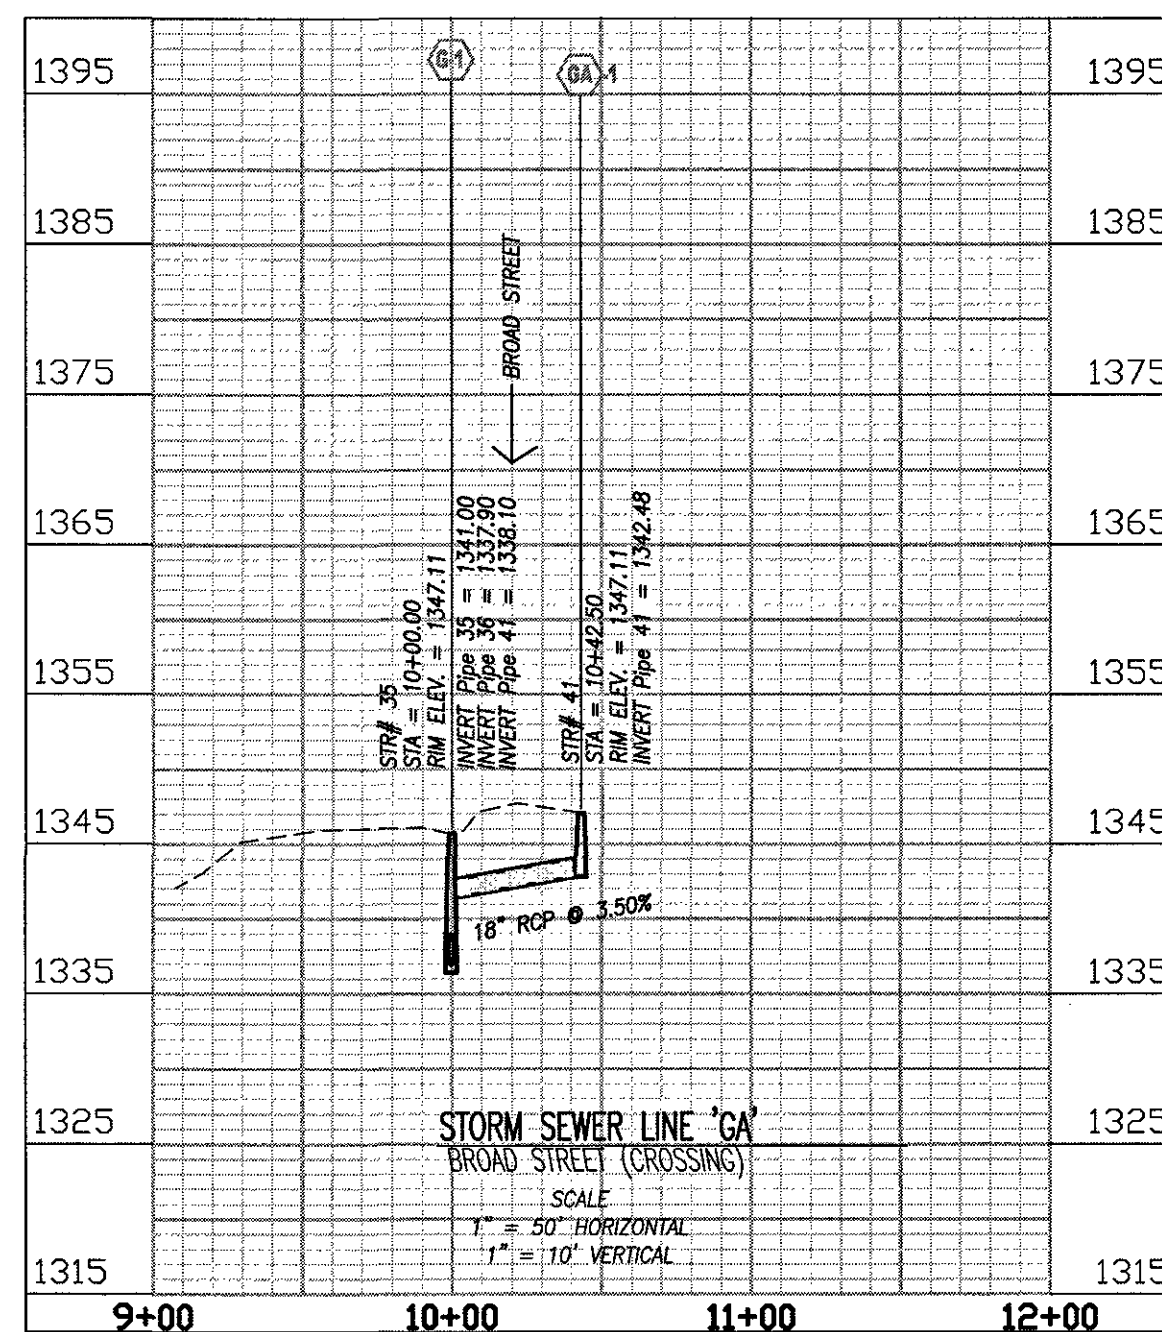
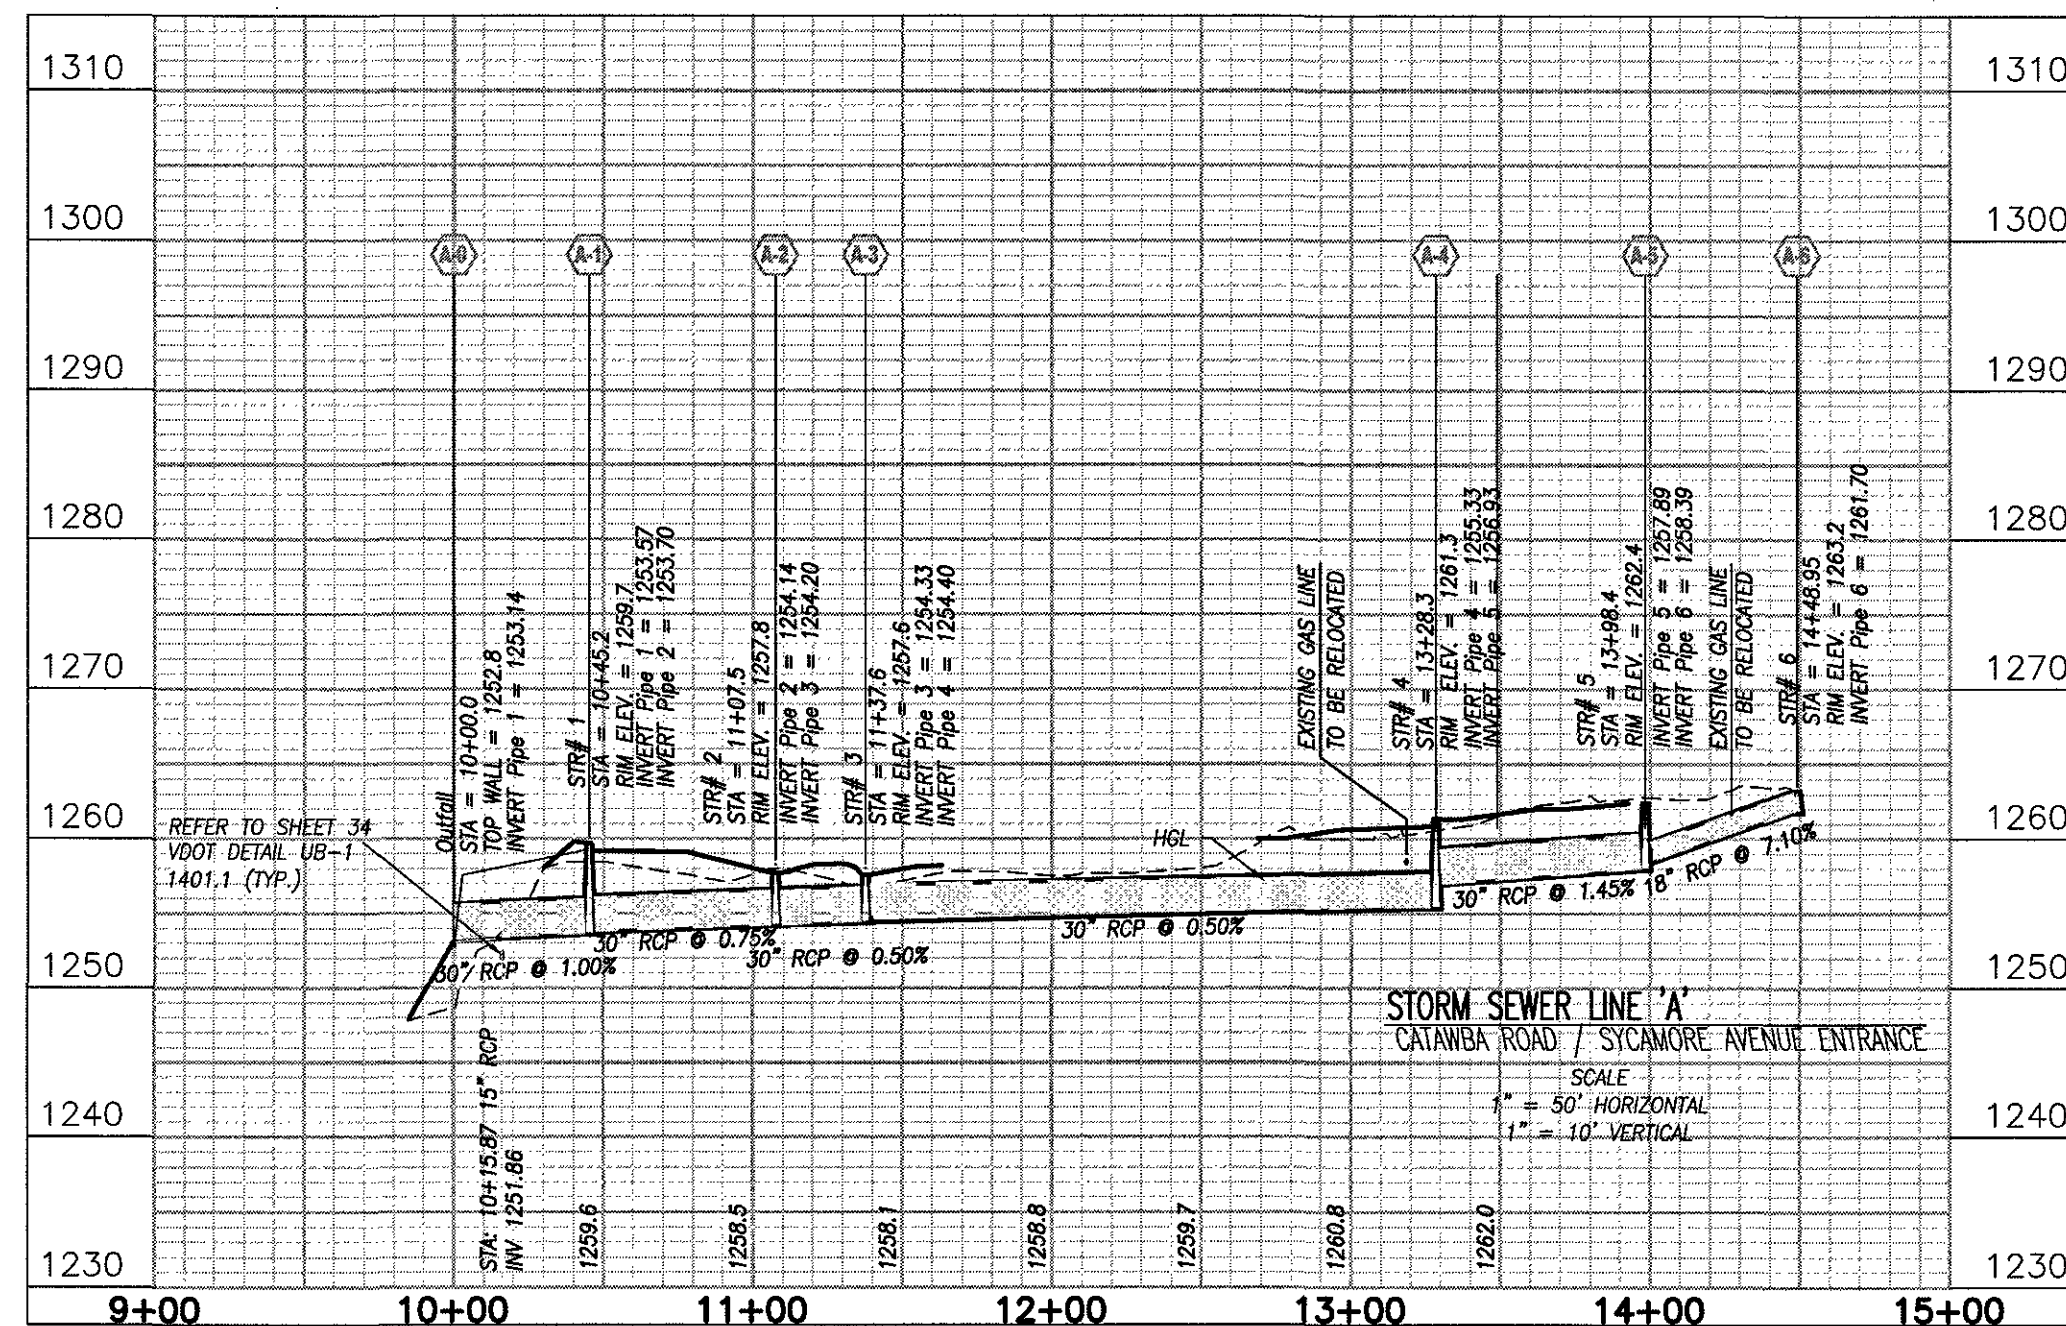


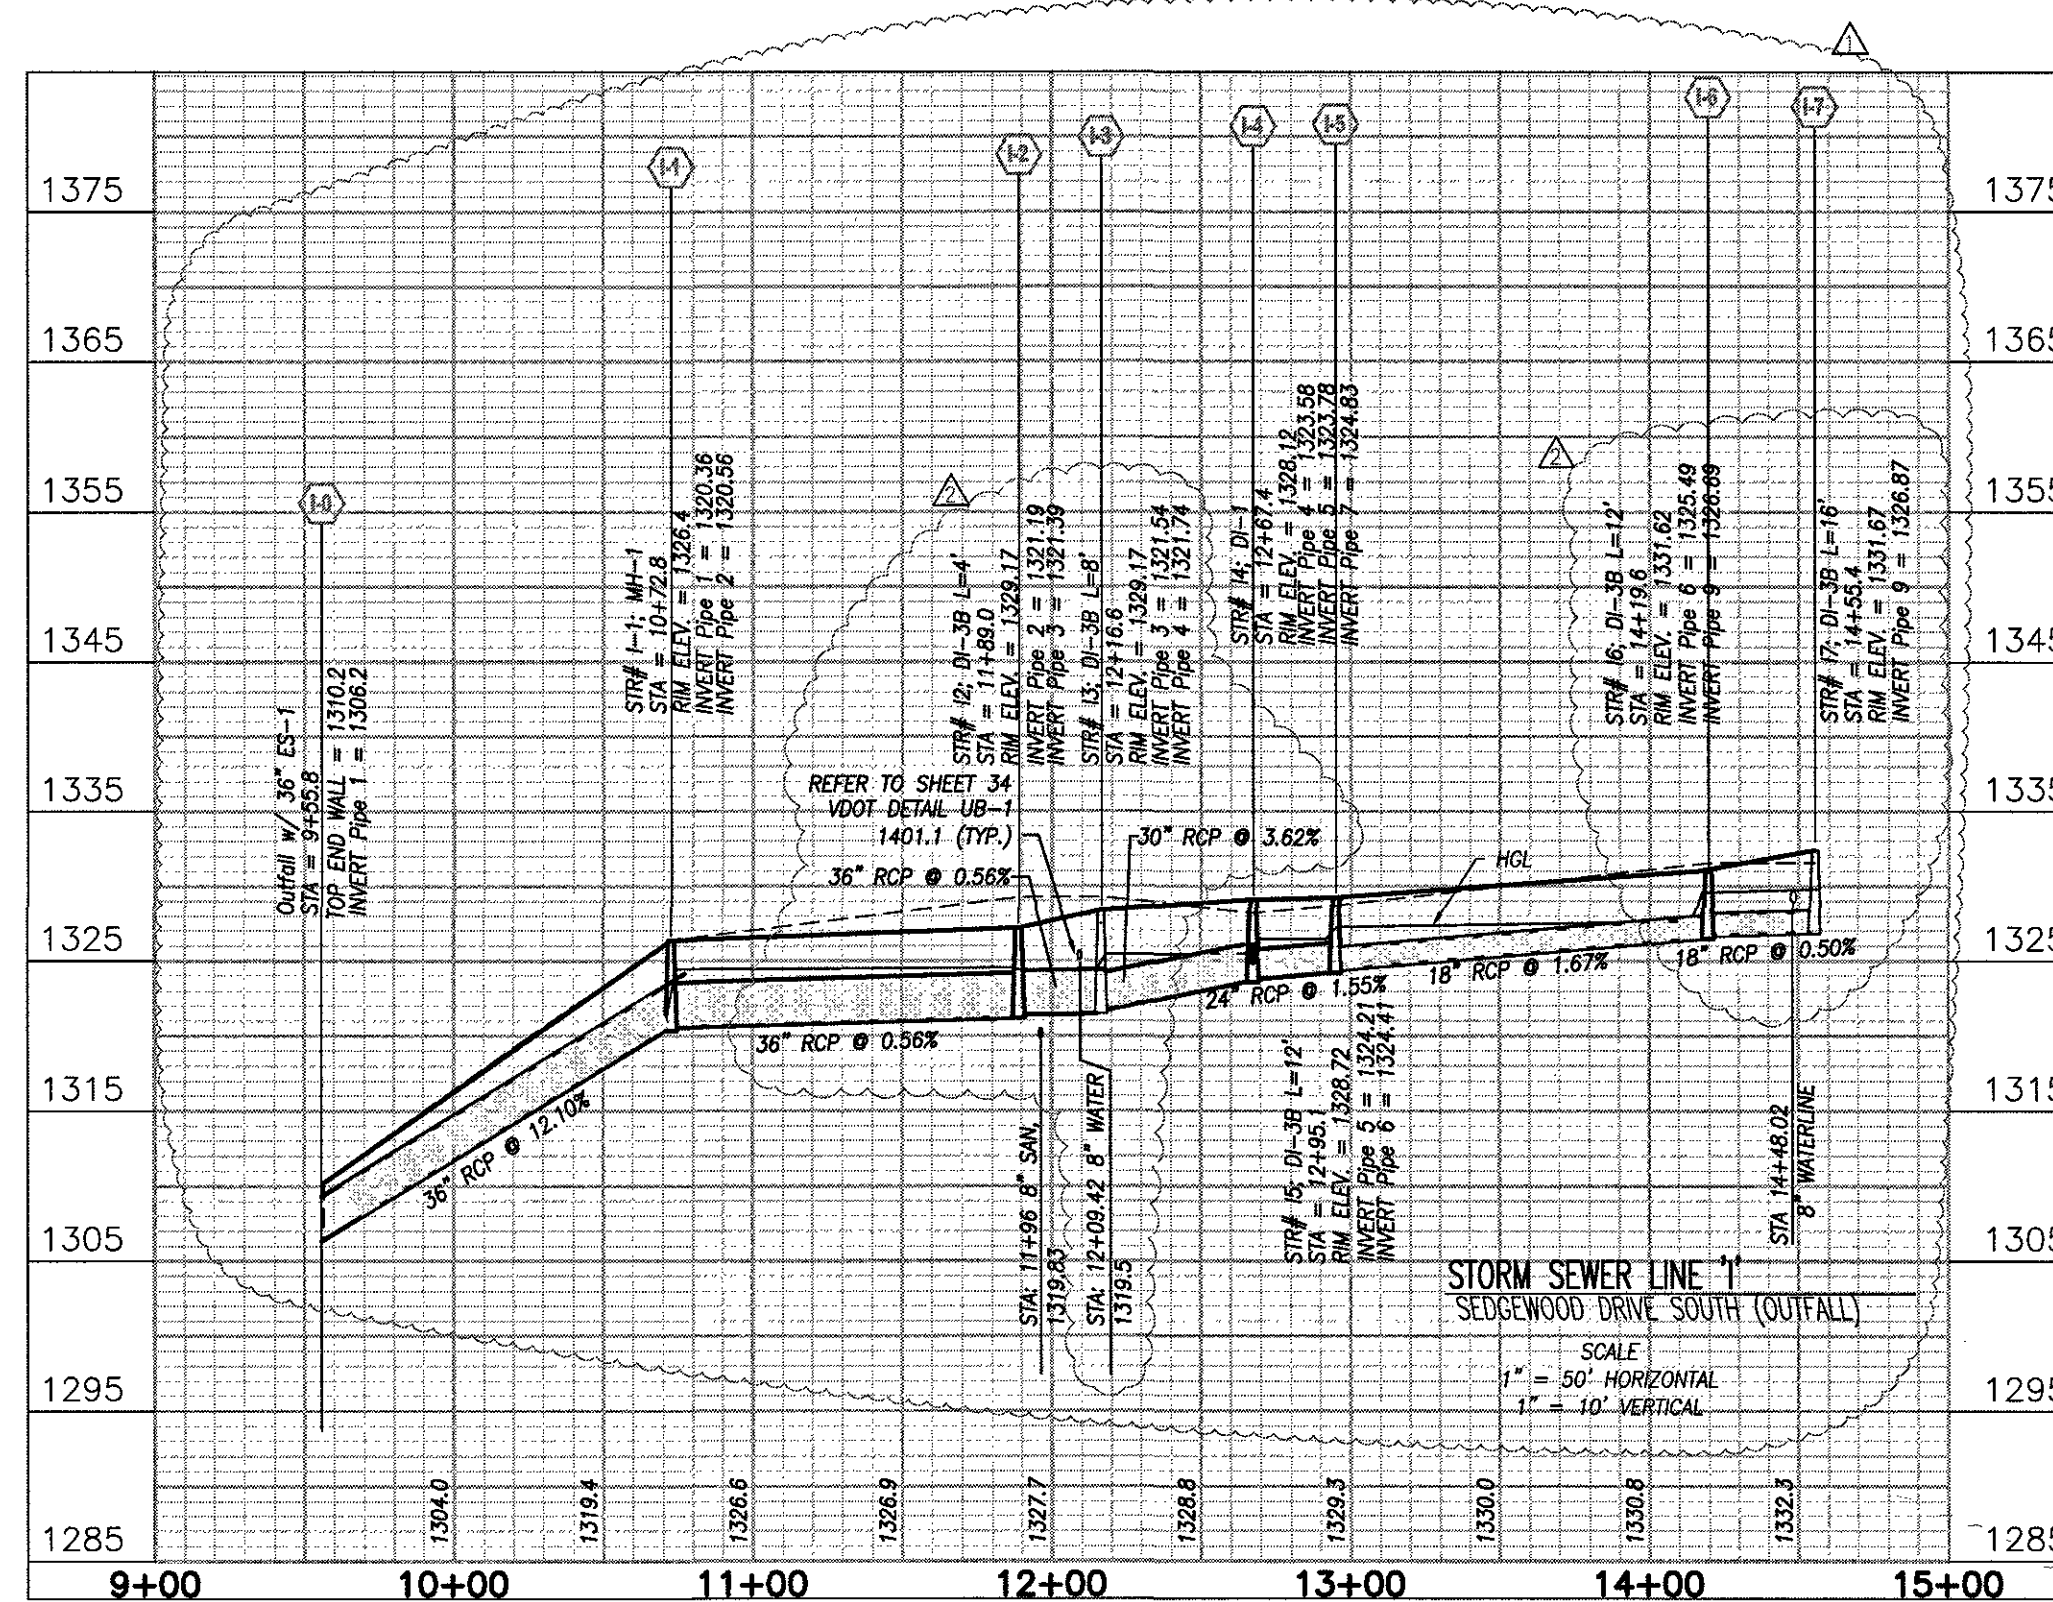

CONTRACTOR TO COORDINATE
WITH MANHOLE MANUFACTURER
FOR THE PROPER DIAMETER
FOR ALL MANHOLES (TYP.)


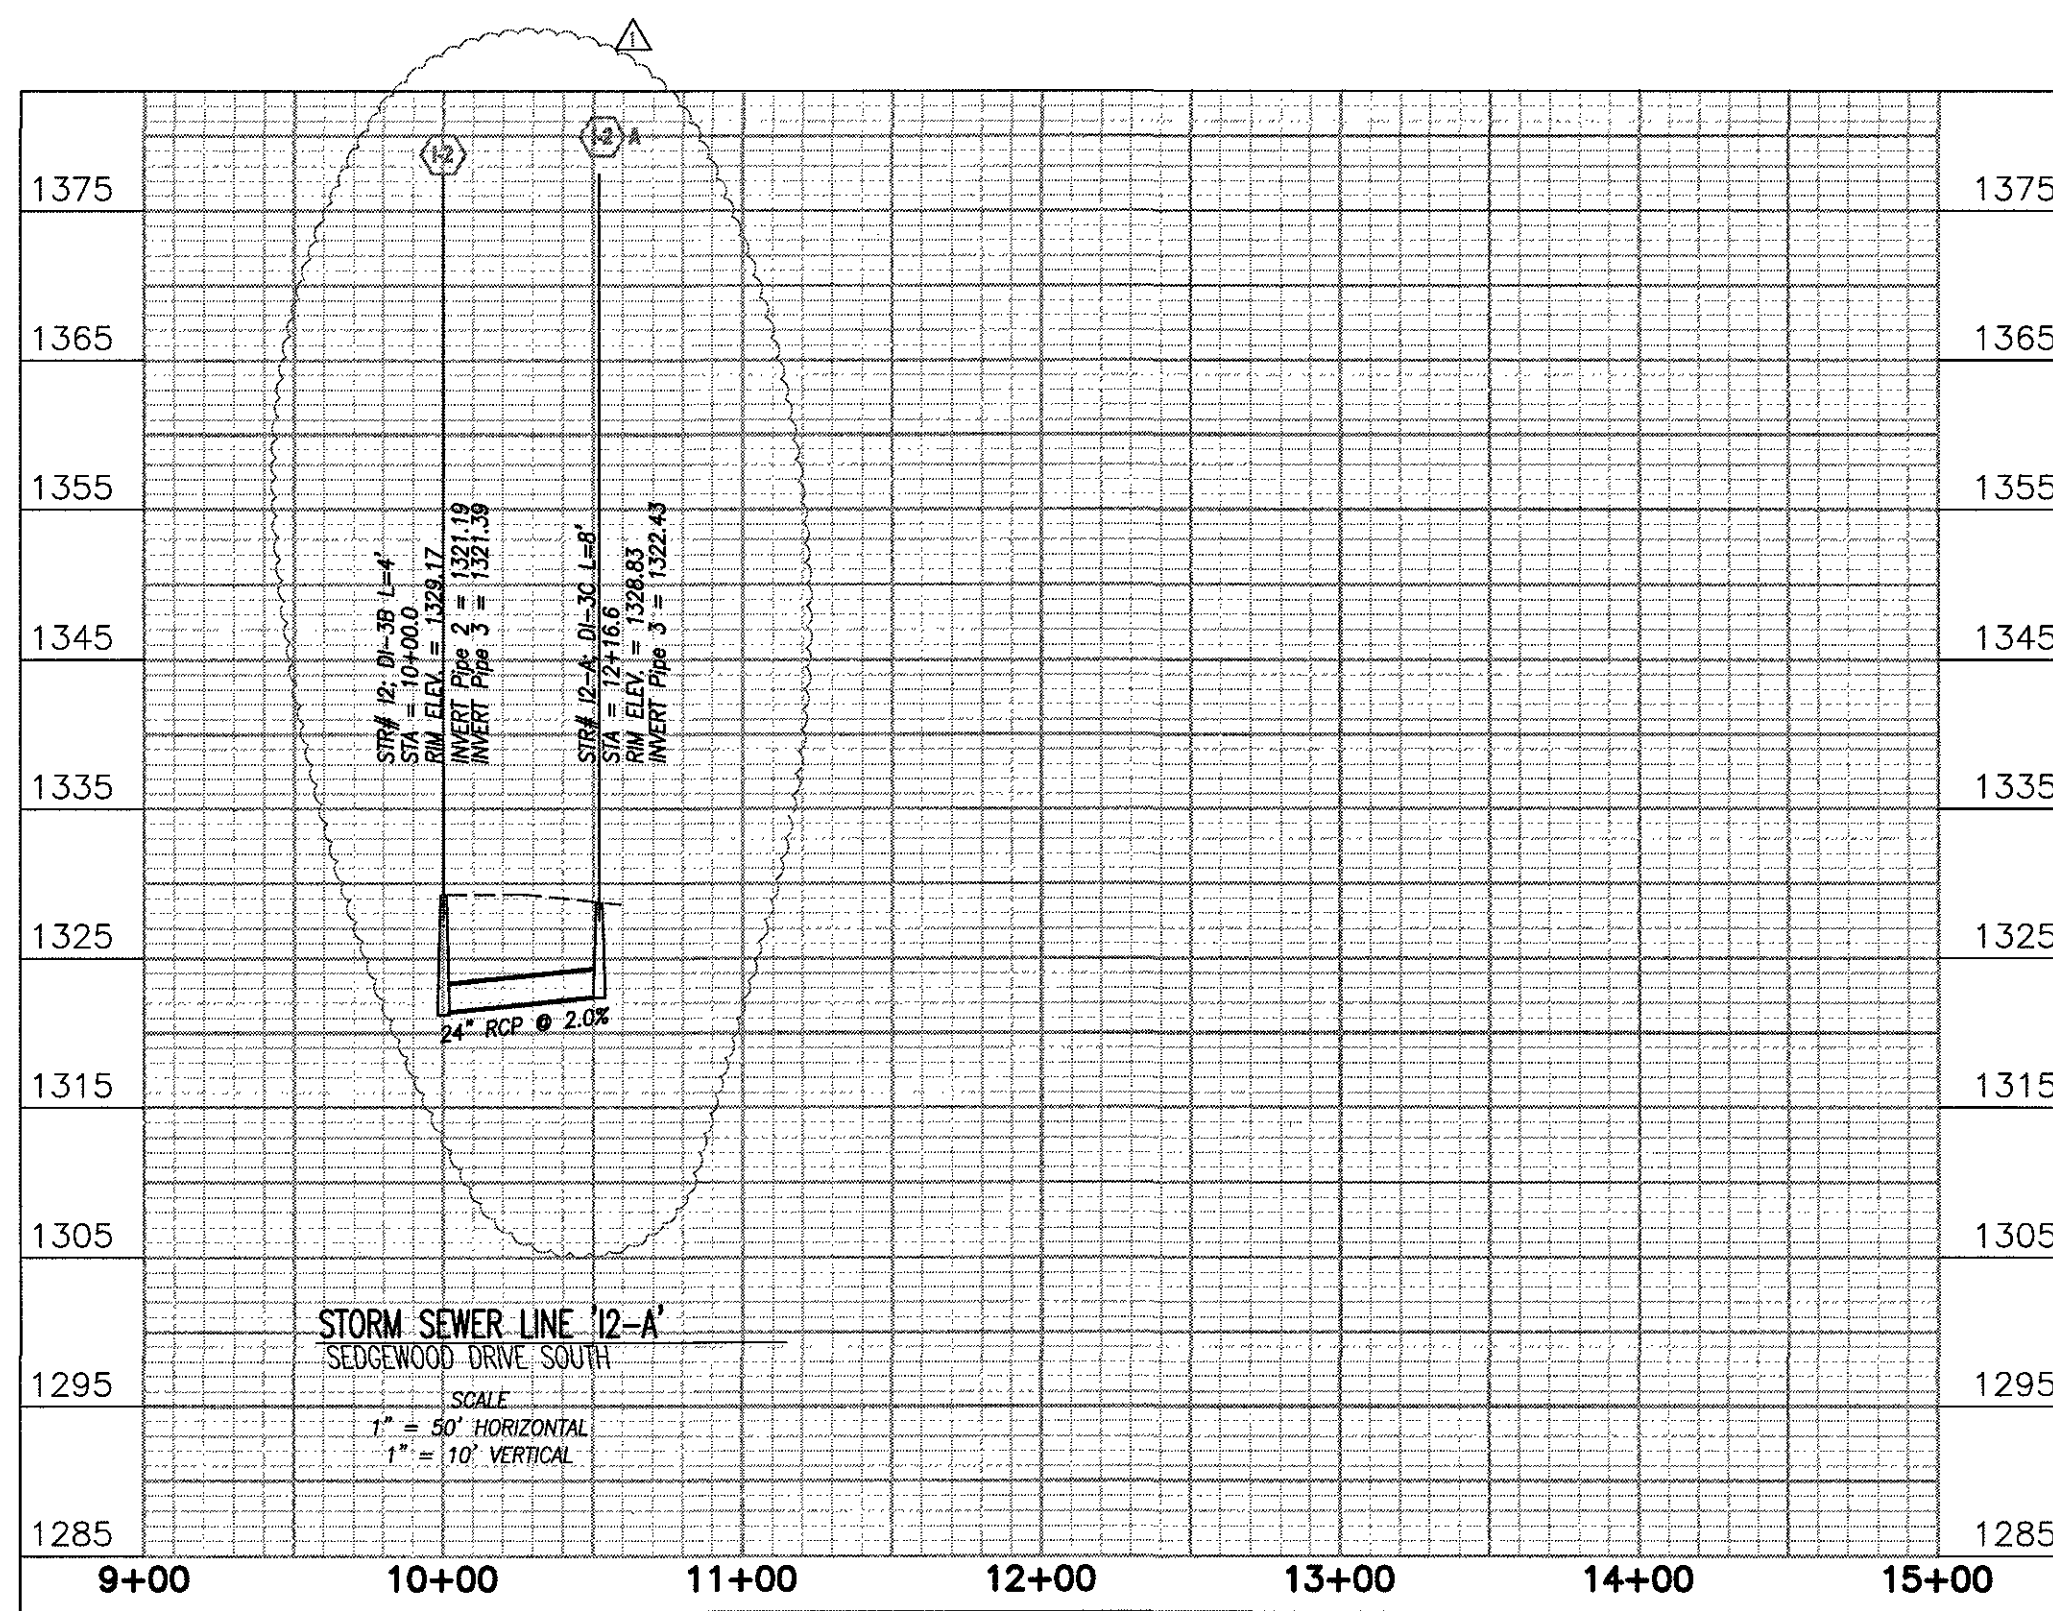


**PROJECT FRALIN AND WALDRON
DALEVILLE TOWN CENTER**

DRAWING STORM DRAIN PROFILES

SHEET

C-19

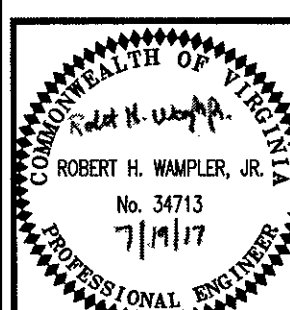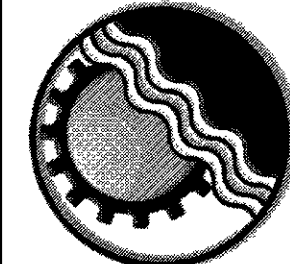[illegible]