

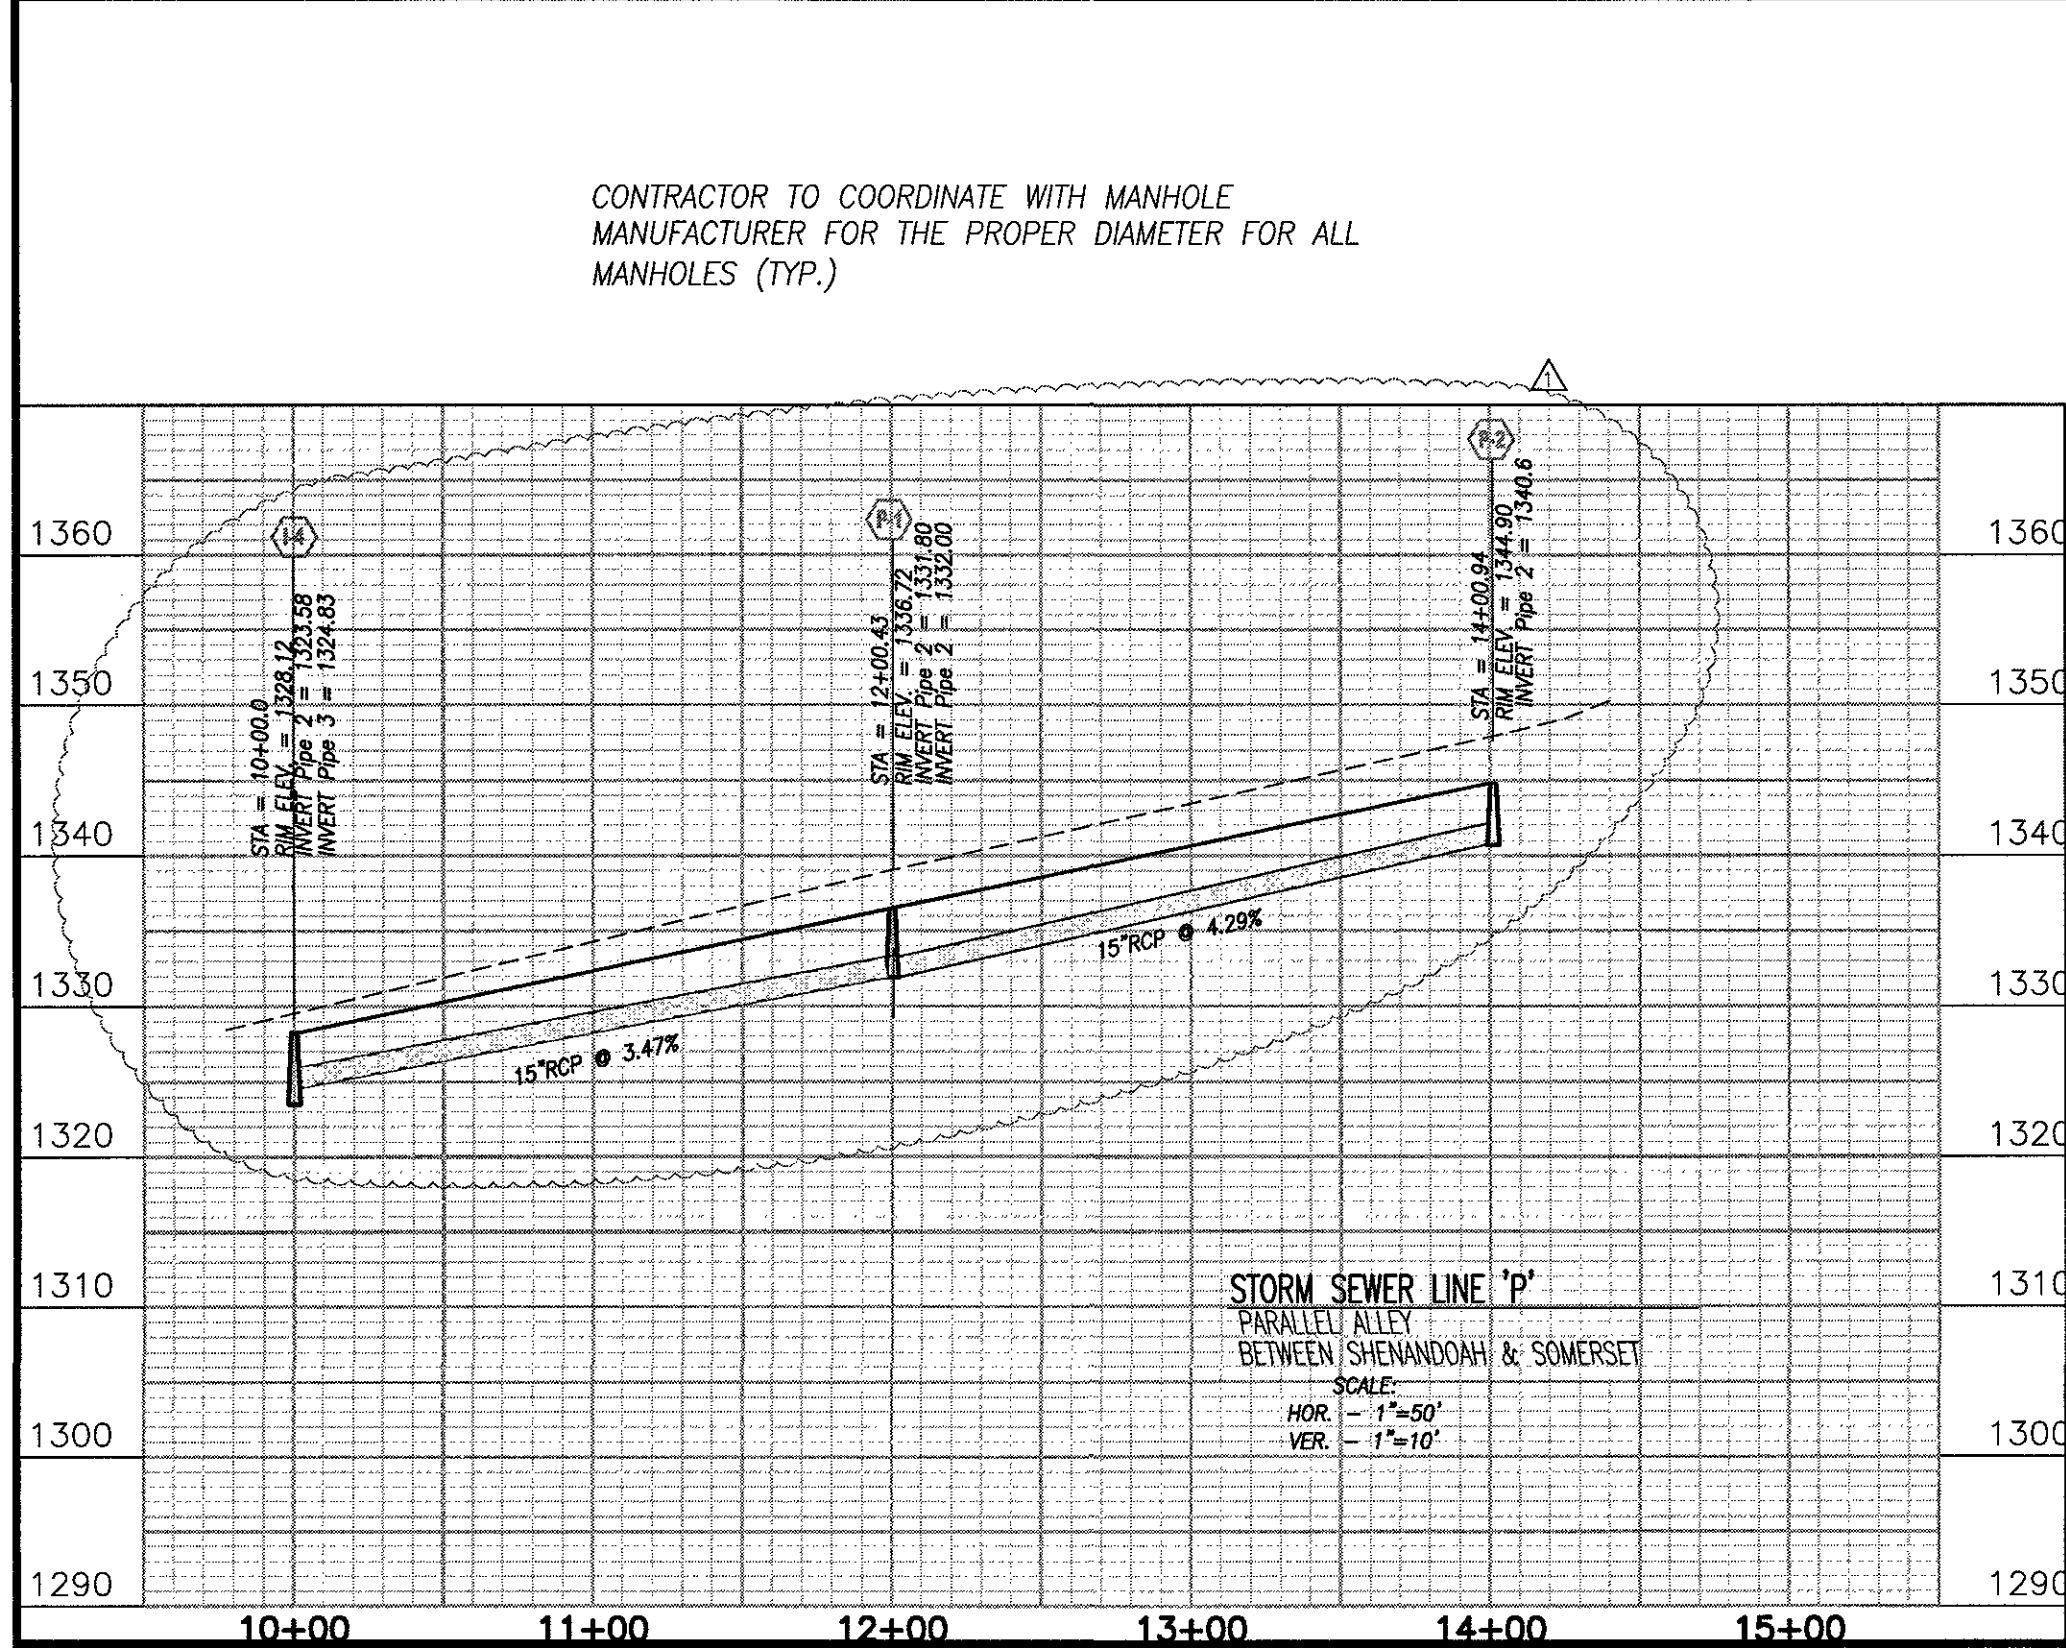
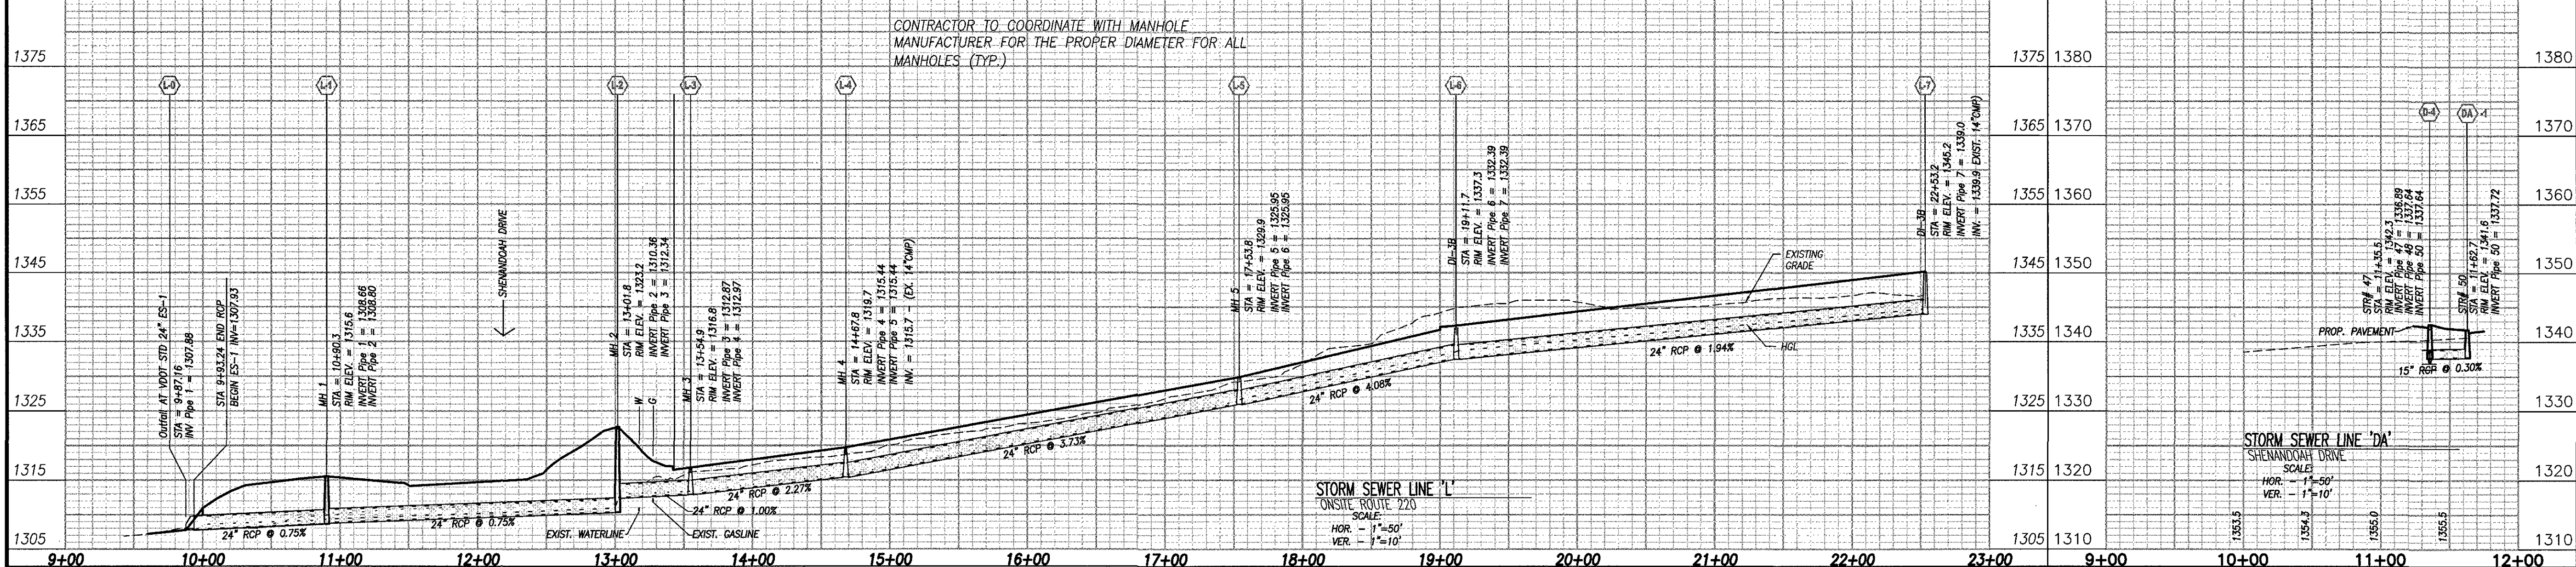


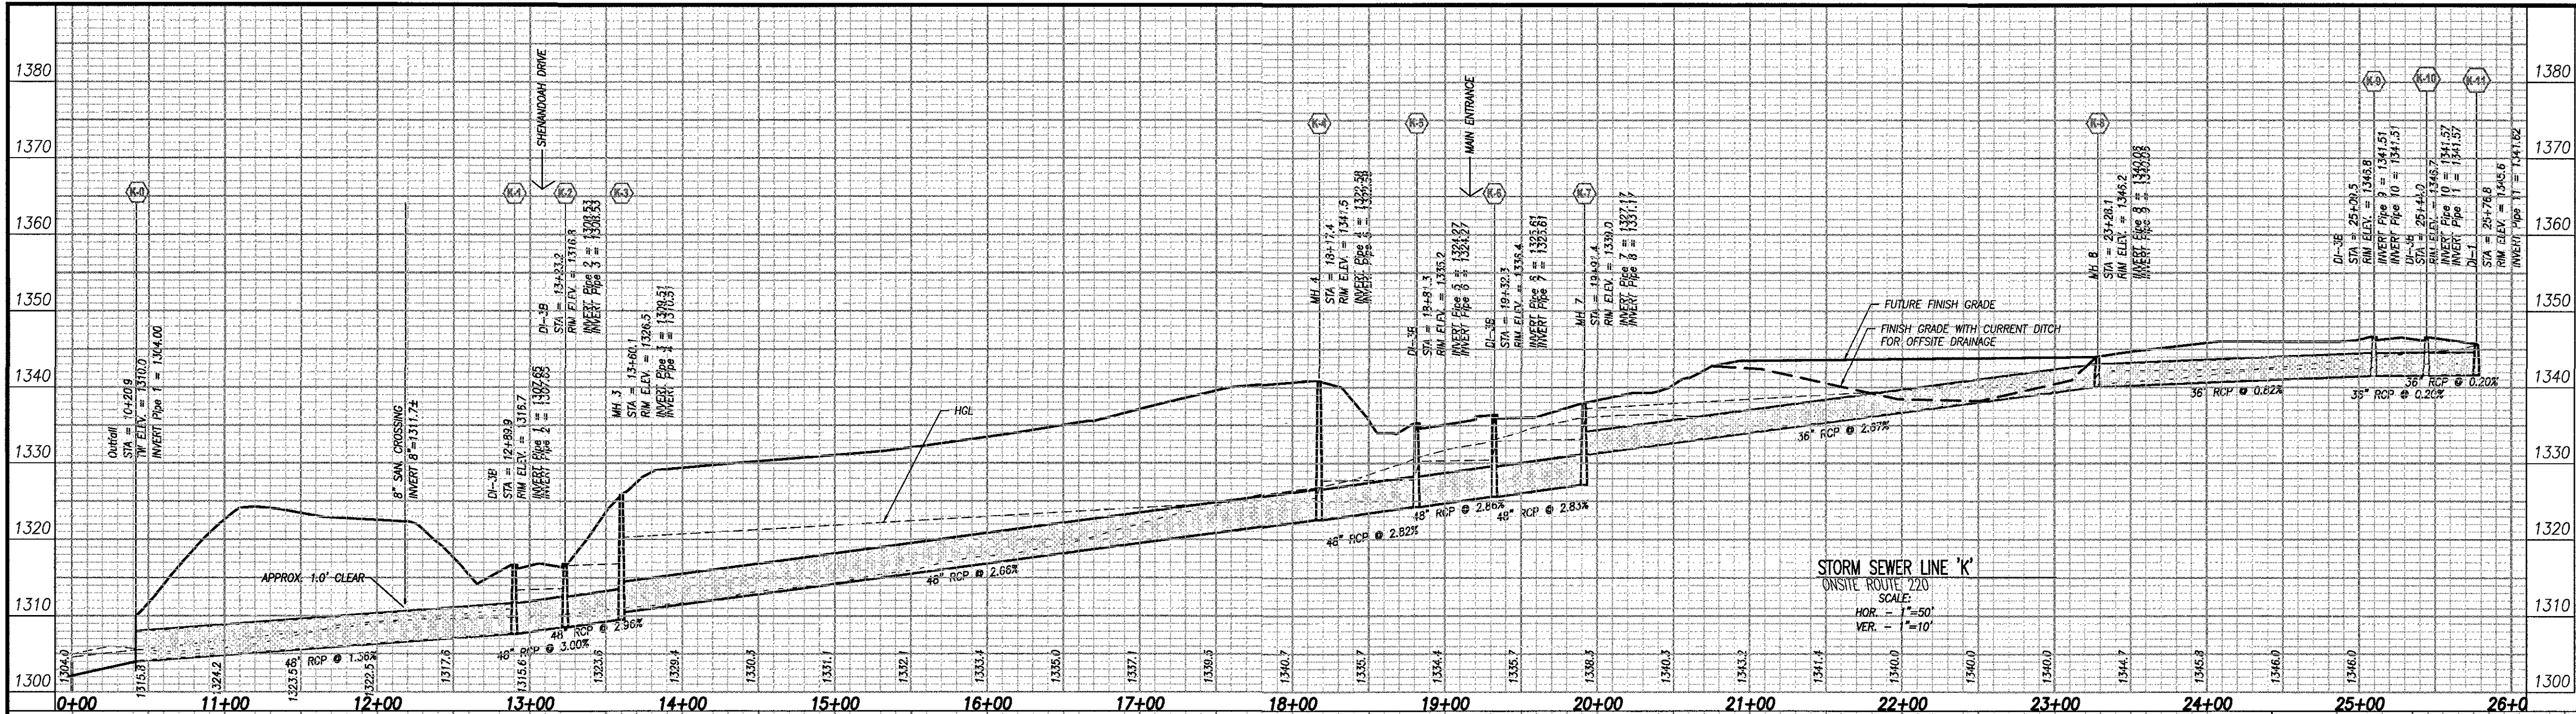

STORM STRUCTURE CHART

STATION	PIPE DIAMETER	PIPE TYPE	PIPE SLOPE	MANHOLE	MANHOLE TYPE	MANHOLE DIAMETER	MANHOLE ELEVATION	PIPE ELEVATION	PIPE LENGTH

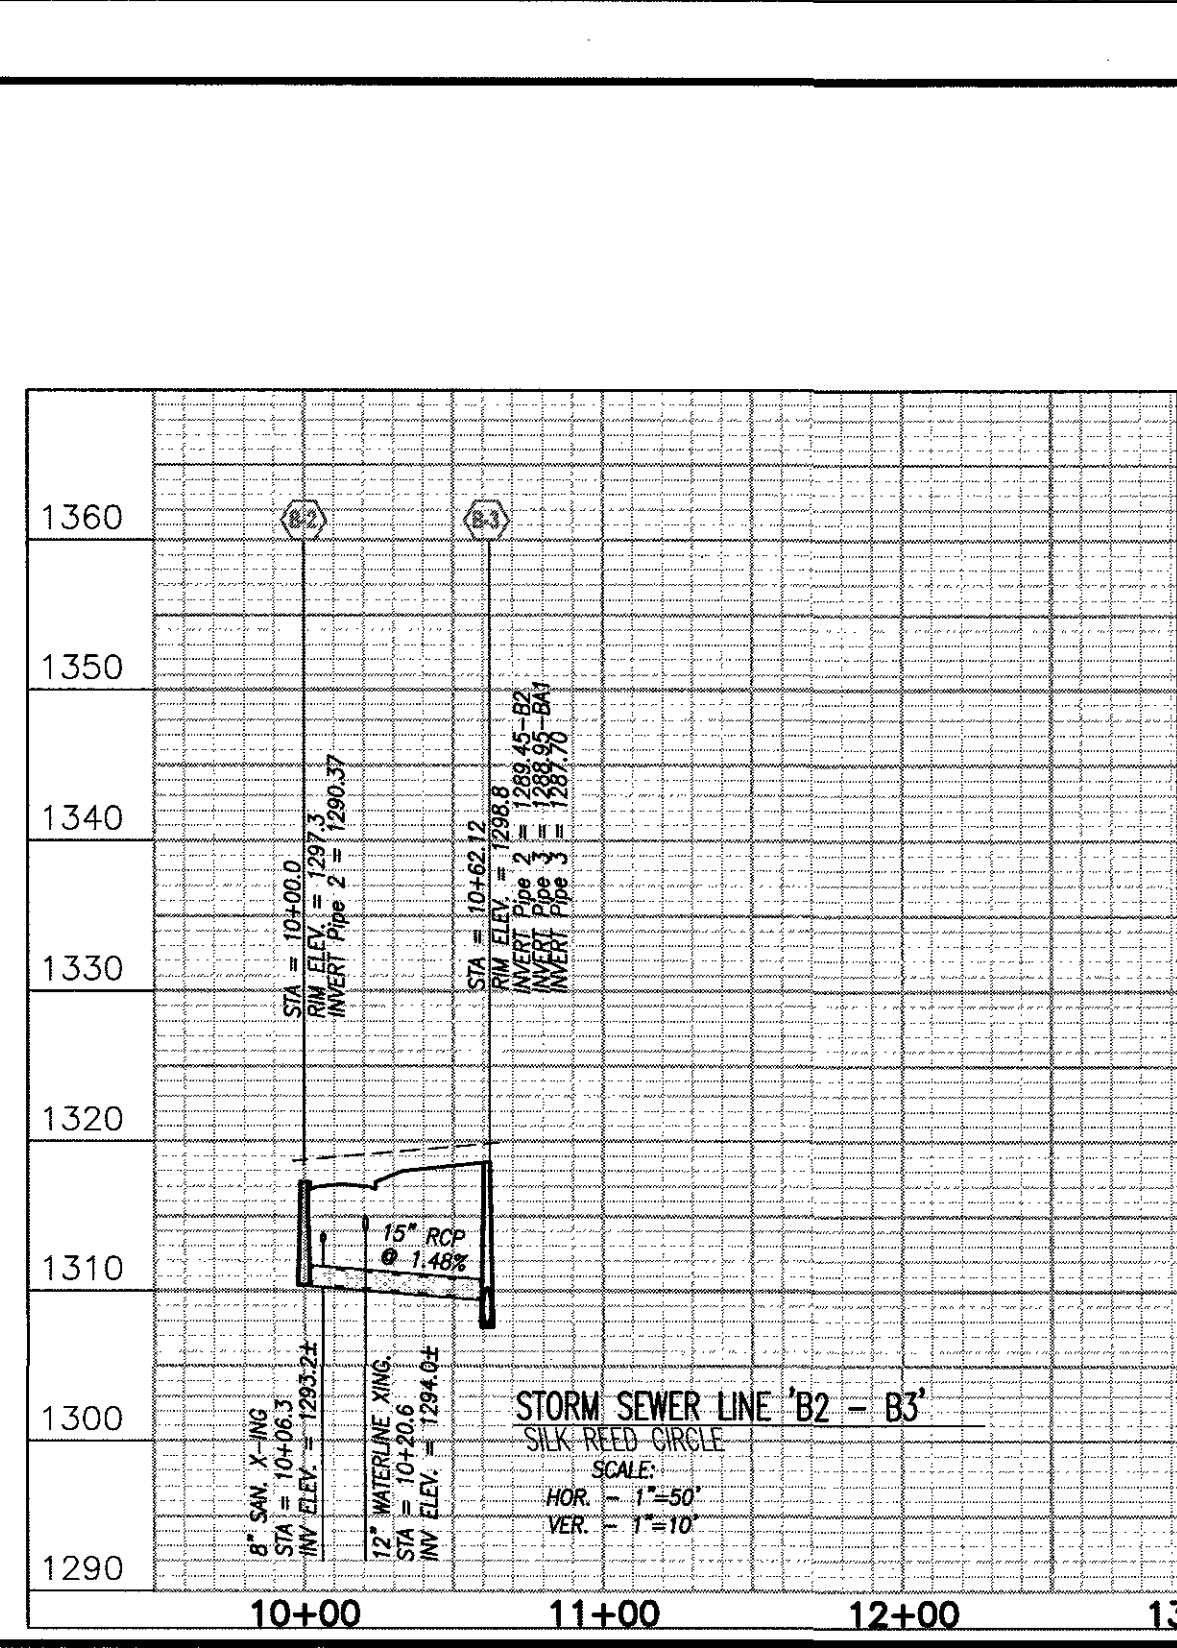

DATE: 5/8/08

PROJECT: 03083

DESIGNED: RHW

DRAWN: MSJ

CHECKED: RHW

WMA COMMENTS: VARIOUS DEVELOPMENT REVISIONS

MSJ

7/19/17

5/24/17

MARK DATE

REVISIONS

ENGINEERING CONCEPTS, INC.

"Creating Success"



ROBERT H. WAMPLER, JR.

No. 34713

7/11/17


PROJECT: FRANK AND WALDRON DALEVILLE TOWN CENTER

DRAWING: STORM DRAIN PROFILES

SHEET: C-22