
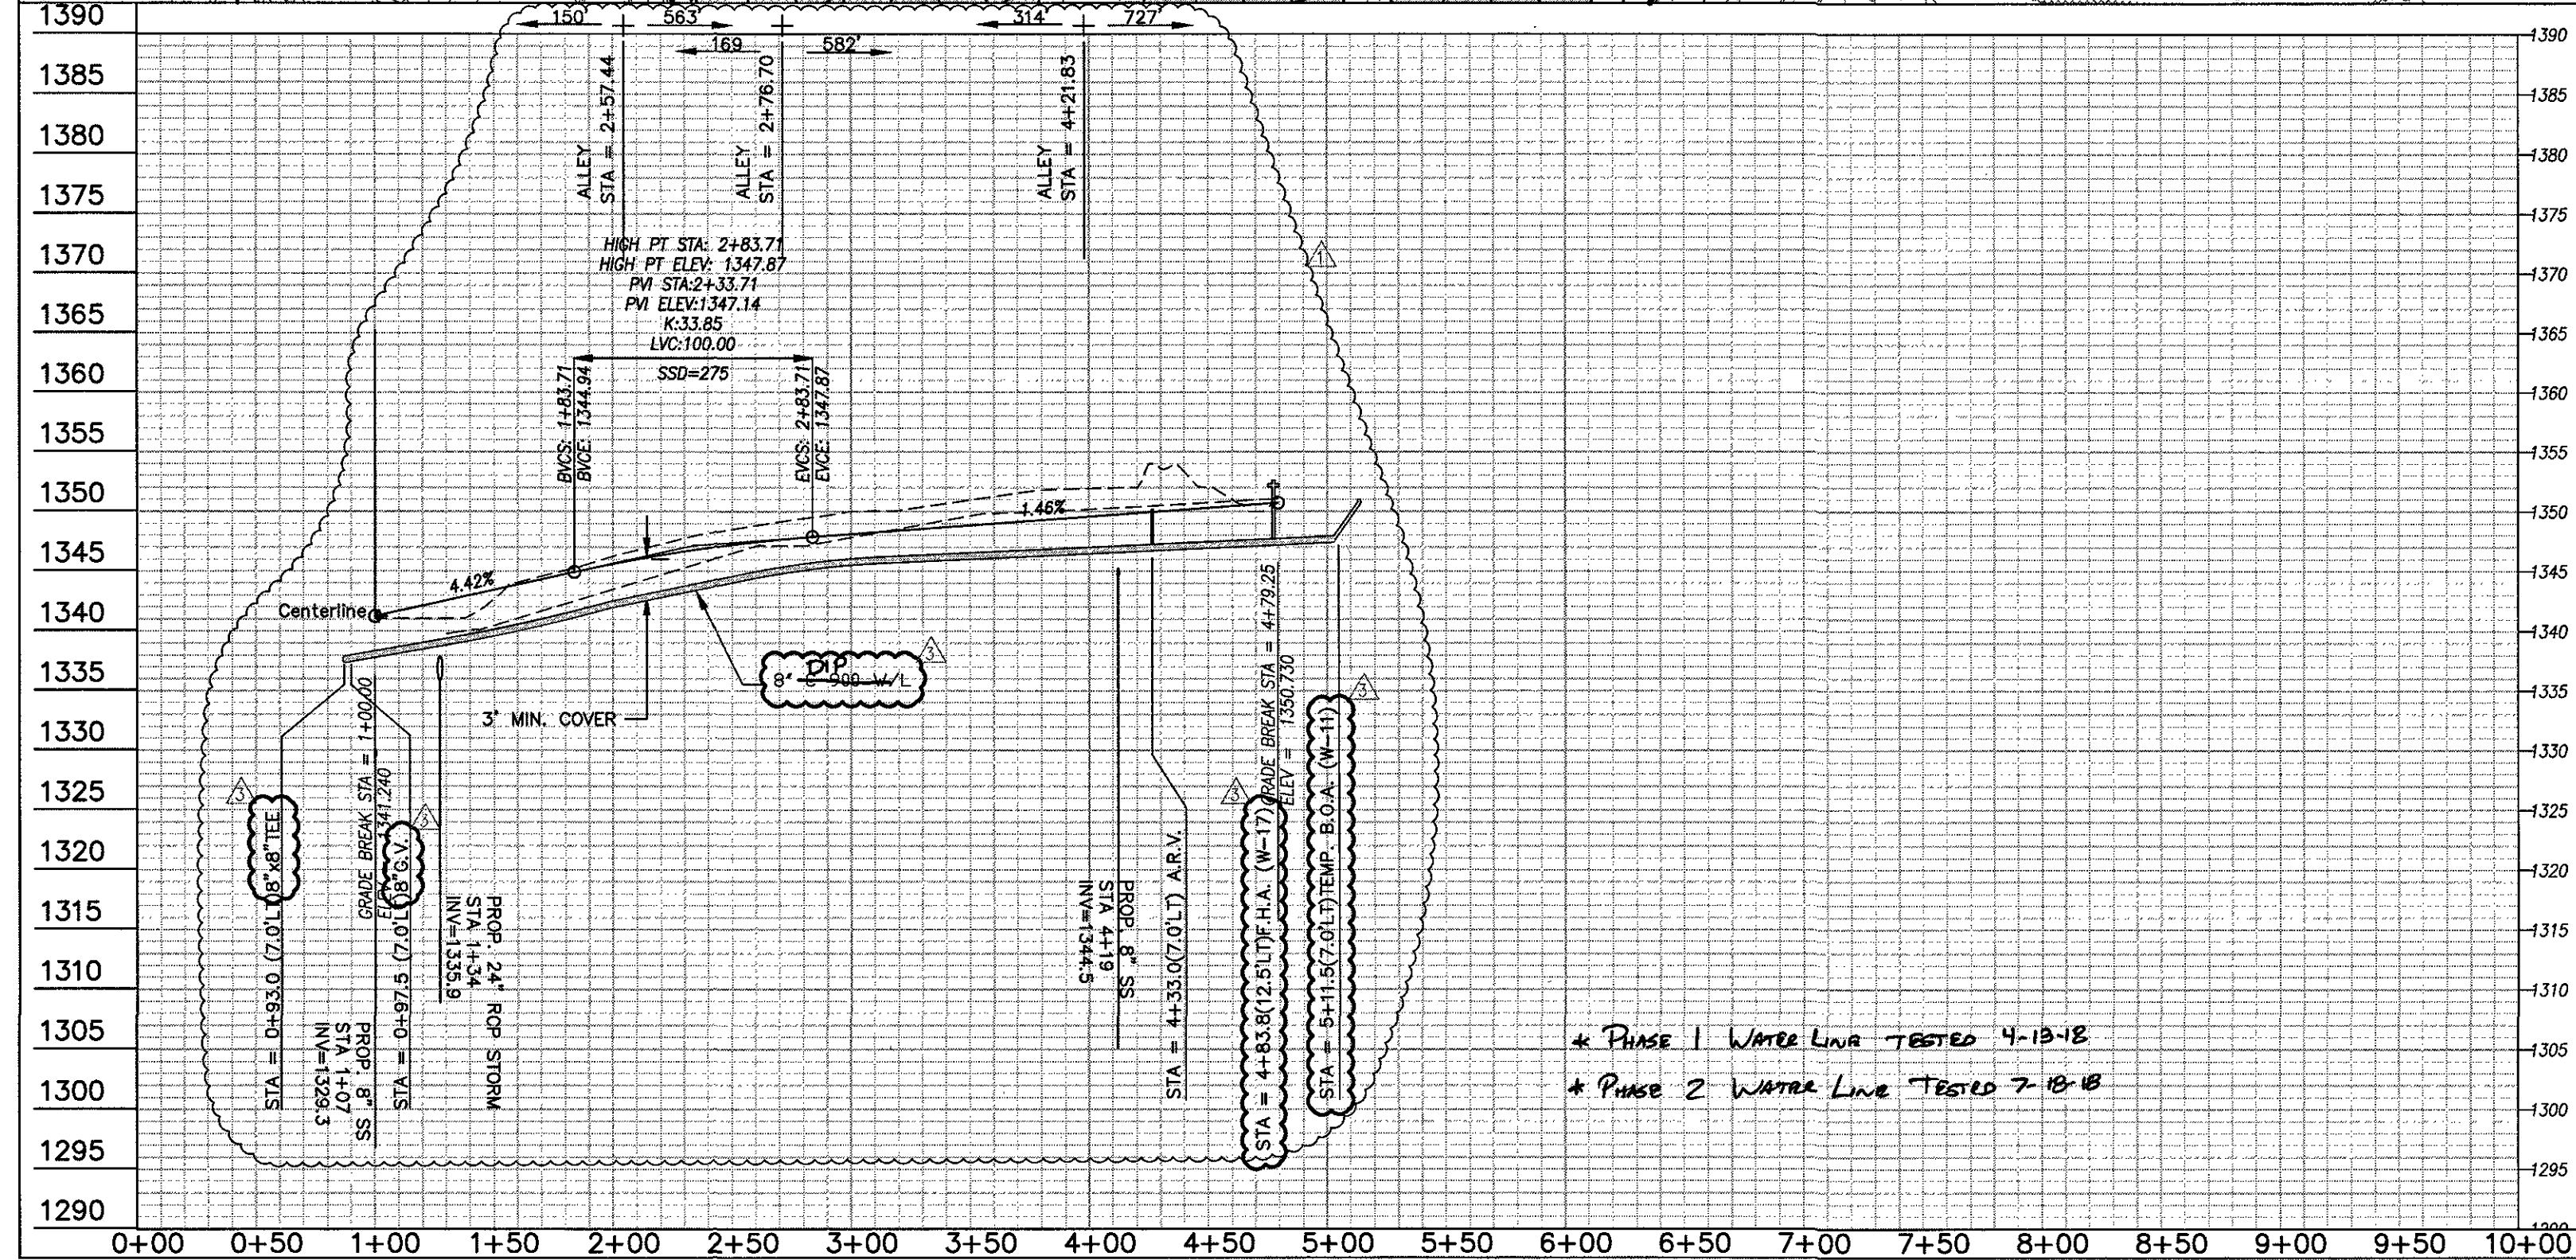



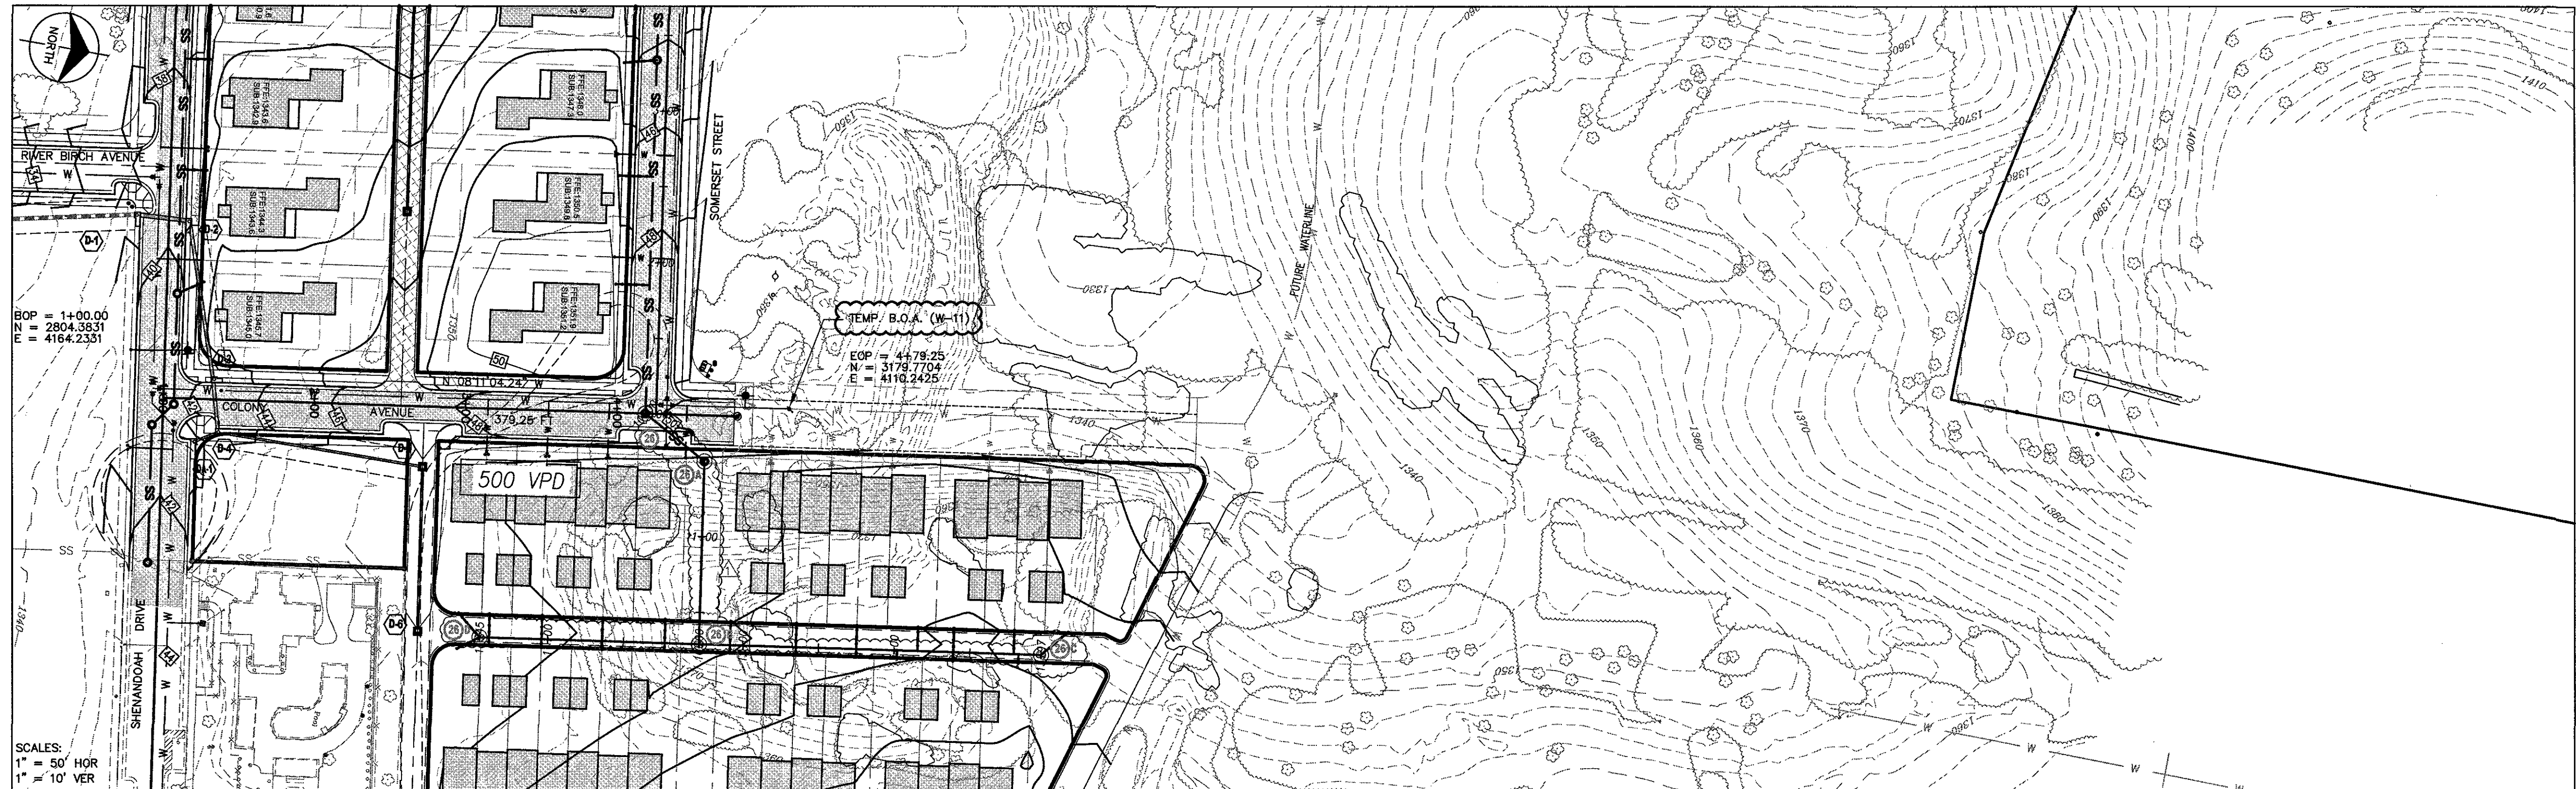


PROJECT FRALIN AND WALDRON
DALEVILLE TOWN CENTER

DRAWING COLONY AVENUE PLAN / PROFILE

SHEET

C-30

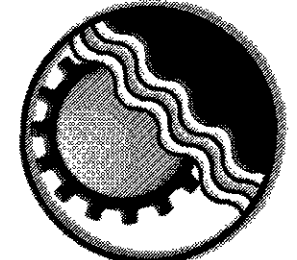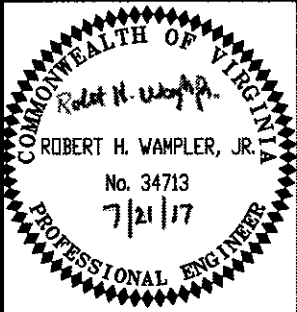

ENGINEERING
CONCEPTS, INC.
"Creating Success"

34 GREENFIELD STREET

DATE 5/8/08
PROJECT 03083
DESIGNED RHW
DRAWN MSJW
CHECKED RHW

DATE	BY	REVISIONS
7/21/17	MSJW	MARK DATE
7/19/17	MSJW	REVIEW COMMENTS
5/10/08	MSJW	DESCRIPTION

WVA COMMENTS
WVA COMMENTS
WVA COMMENTS