


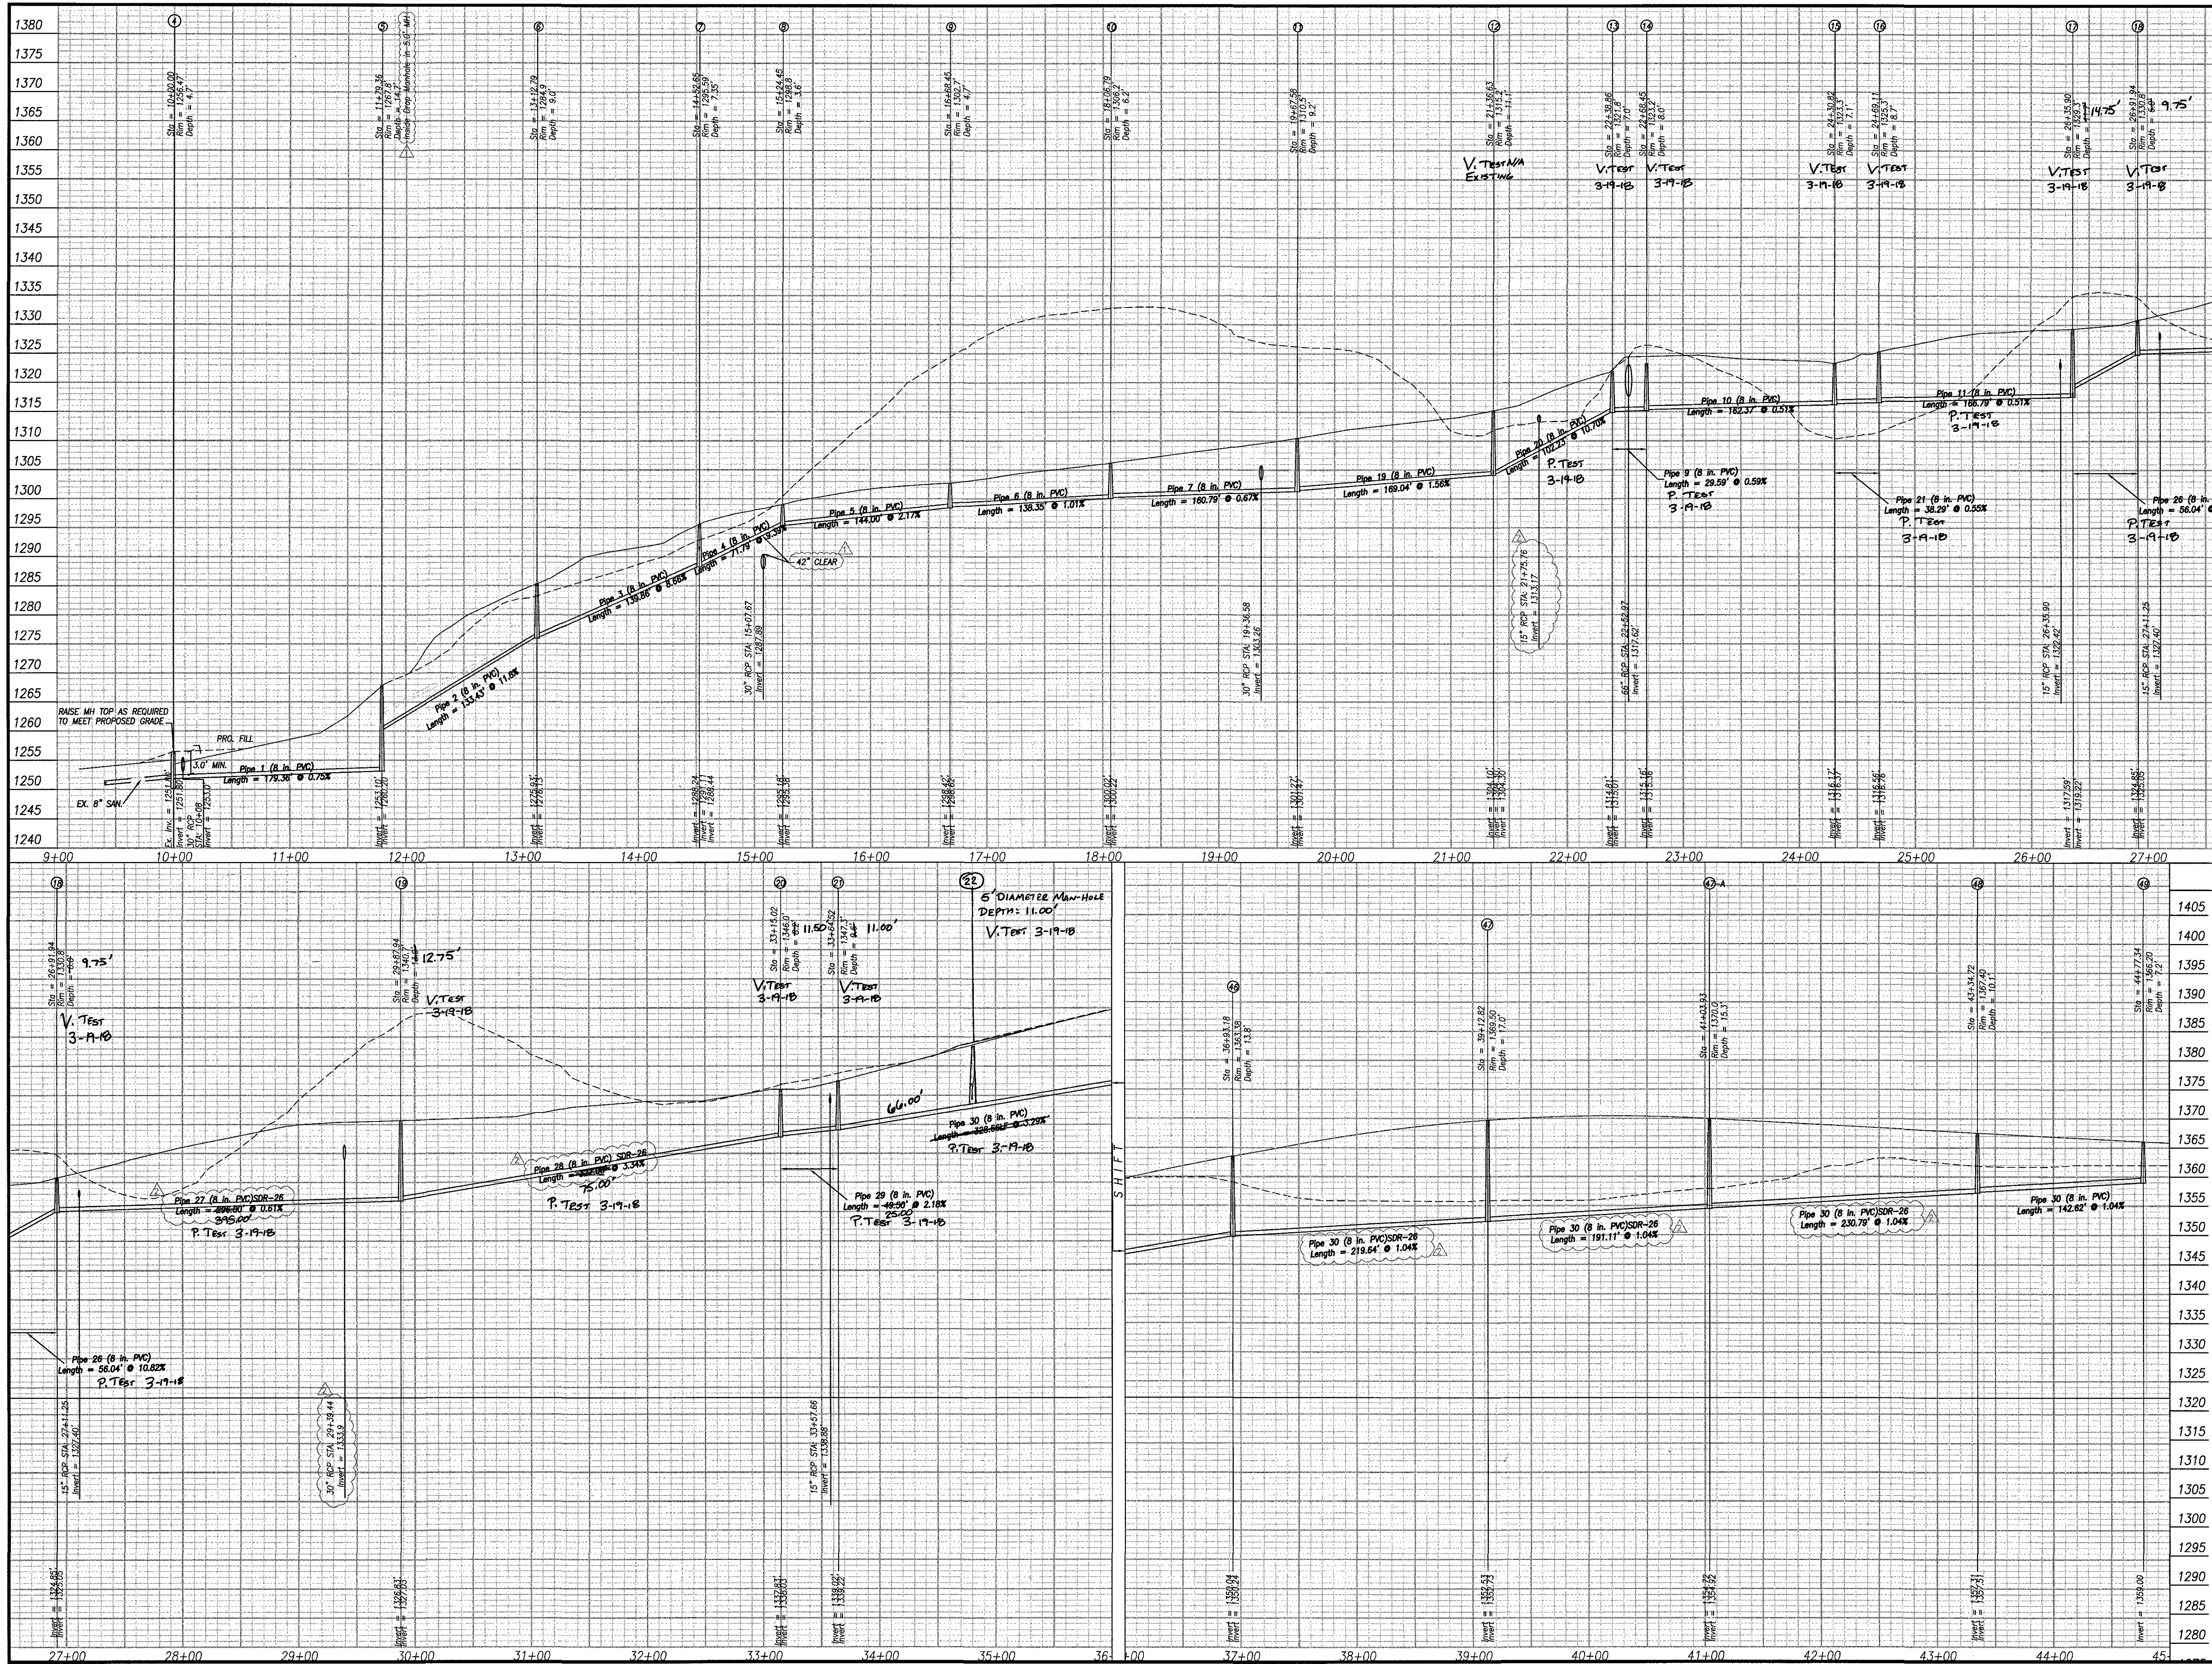

DATE 5/8/08
PROJECT 03083
DESIGNED RHW
DRAWN MSJM
CHECKED RHW

ENGINEERING
CONCEPTS, INC.
"Creating Success"
84 GREENFIELD STREET

ROBERT H. WAMPLER, JR.
No. 34713
7/11/17
PROFESSIONAL ENGINEER

PROJECT FRALIN AND WALDRON
DALEVILLE TOWN CENTER

DRAWING SANITARY SEWER PROFILES

SHEET
C-38

DATE	BY	REVISIONS
7/19/17	MSJM	MARK DATE
5/10/08	MSJM	DESCRIPTION

WMA COMMENTS
VARIOUS COUNTY REVIEW COMMENTS