

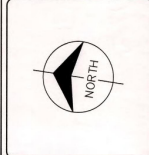
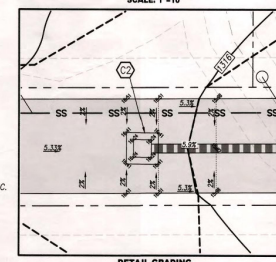
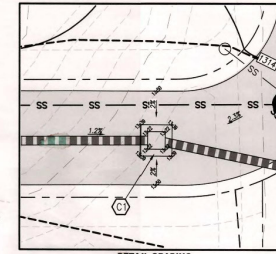


This document, together with the contracts and design professional herein, is an integral part of the project. It is to be used in conjunction with the project.

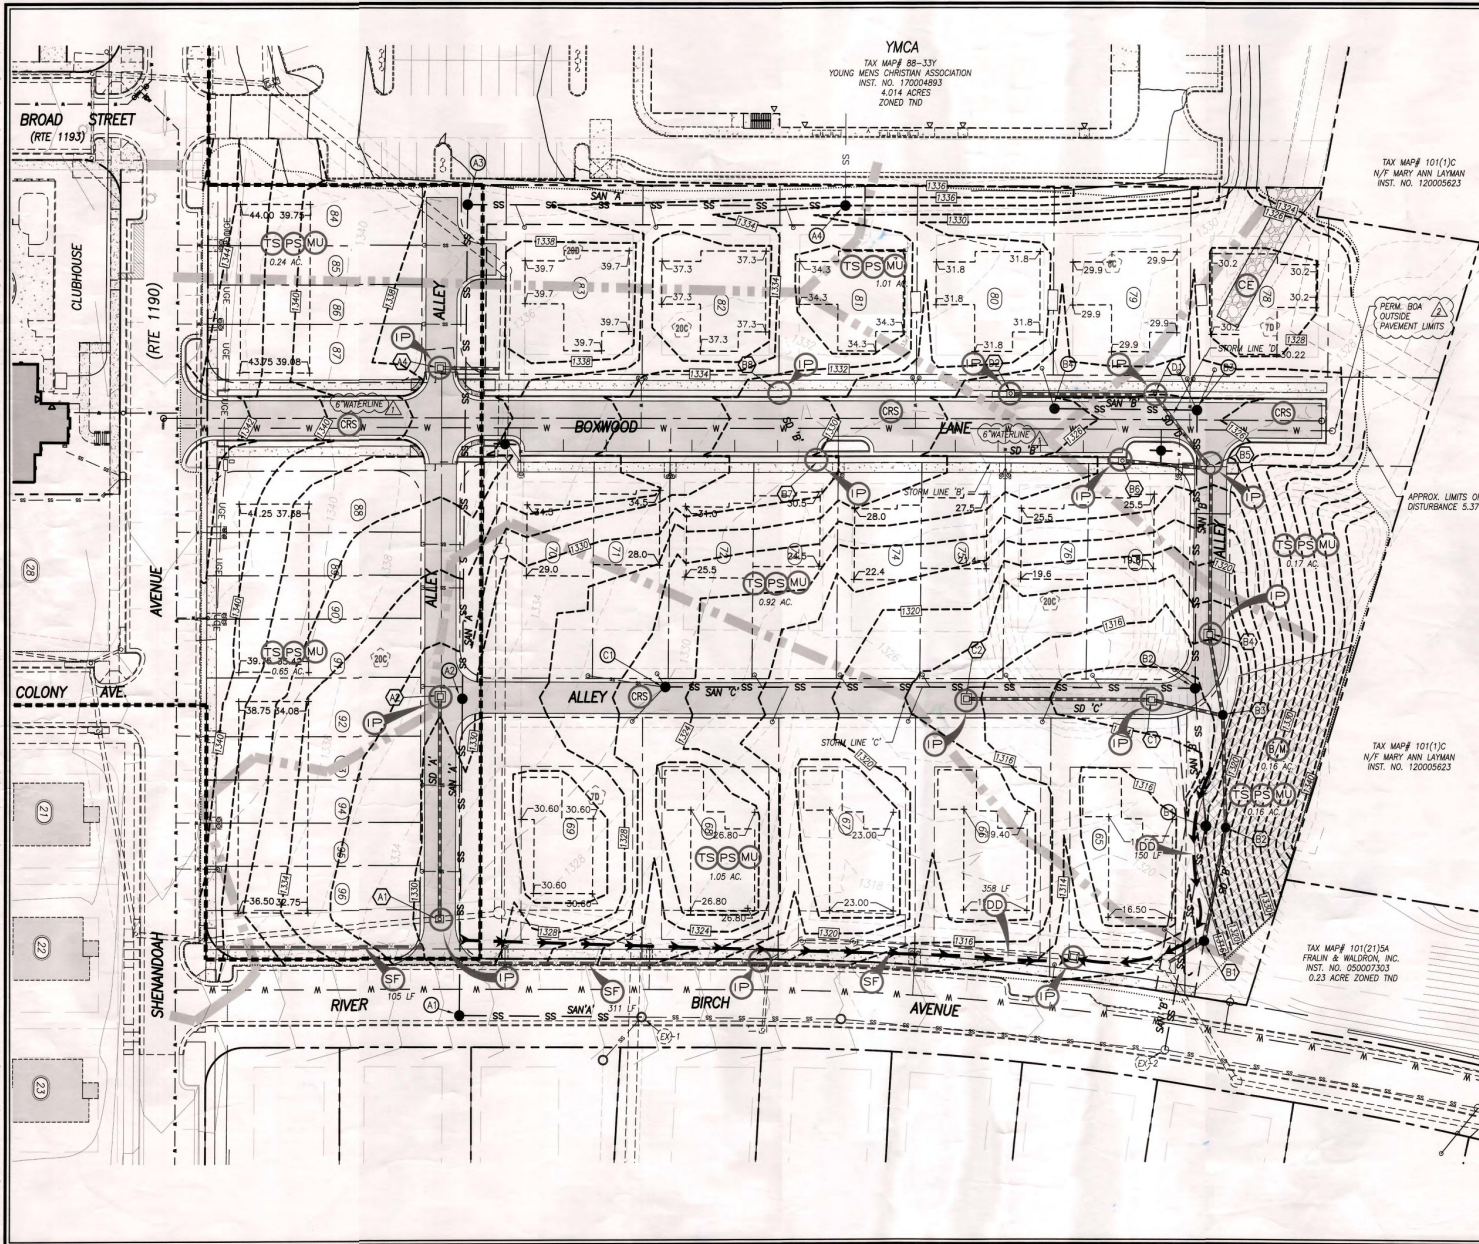

No.	Description	Date
1	WWW 7/2/19 COMMENTS	7/23/19
2	VOOT COMMENTS 08/28/19	09/06/19
3	ADJUST LOT GRADES	02/22/20
4	ADJUST LOT GRADES	04/15/20

DALEVILLE TOWN CENTER PH 3
BOTETOURT CO. - VIRGINIA
BOXWOOD LANE
GRADING & EROSION CONTROL PLAN

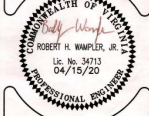

0 30 60
GRAPHIC SCALE
PROJECT: 18038
C05