

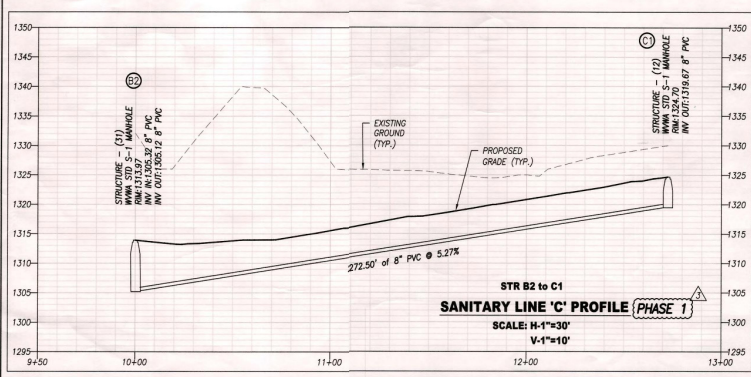


This document, together with the associated design, is the property of the Engineer. It is to be used only for the project and site for which it was prepared. No part of this document is to be reproduced or transmitted in any form or by any means electronic or mechanical, including photocopying, recording, or by any information storage or retrieval system, without the prior written permission of the Engineer.

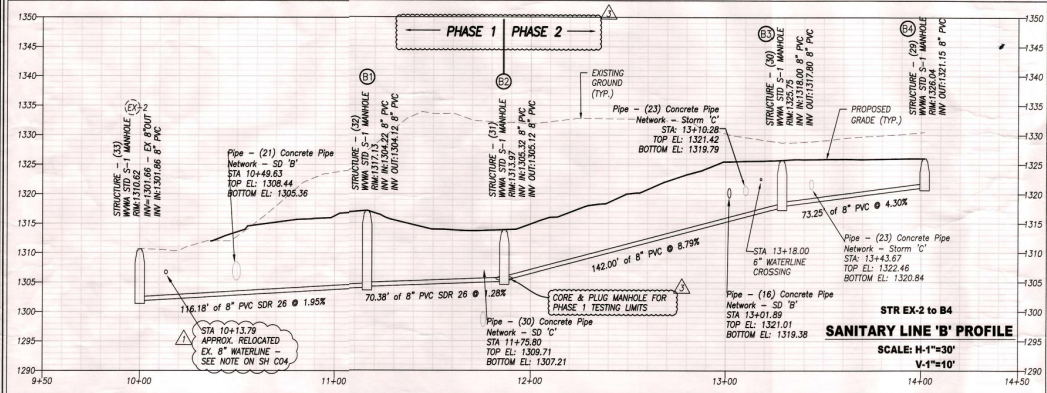

NOTE: ALL SANITARY PIPES TO BE PVC
 SDR-35 UNLESS OTHERWISE NOTED
 ON PROFILES

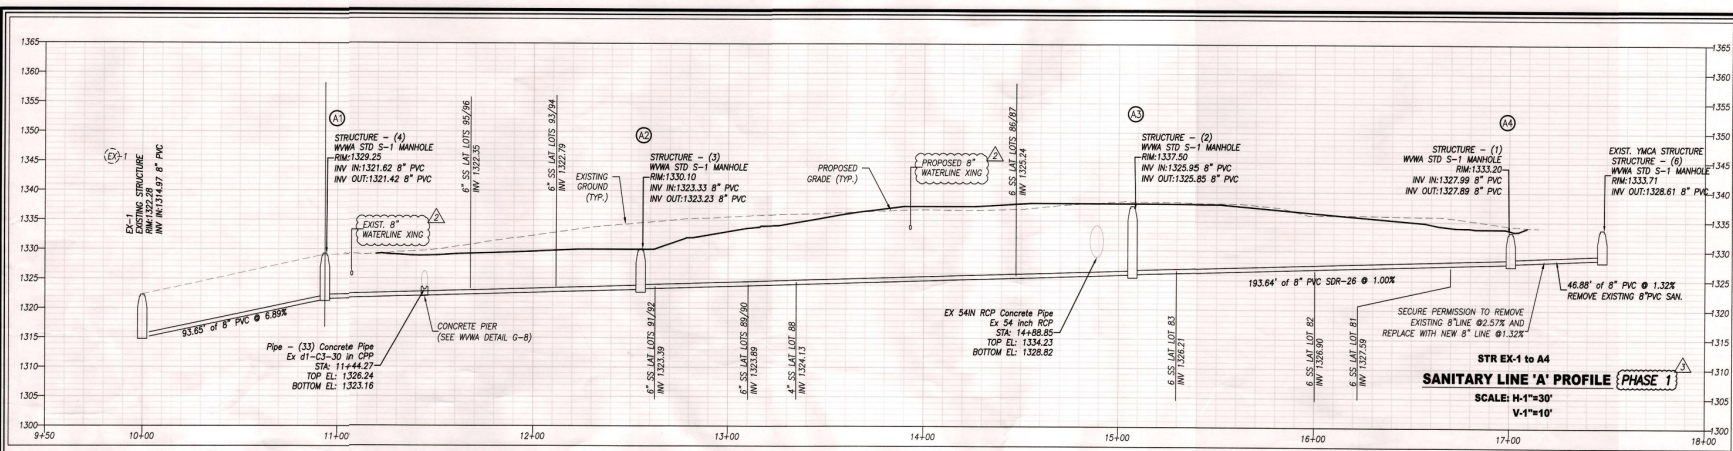

DALEVILLE TOWN CENTER PH 3
BOTETOURT CO. - VIRGINIA
 BOXWOOD LANE
 SANITARY SEWER PROFILES

Professional Engineer
 Robert A. Wampler, Jr.
 License No. 36711
 3/30/20

GRAPHIC SCALE
 PROJECT: 18038
C08

No.	Description	Date
1	WVA 7/27/19 COMMENTS	7/23/19
2	VDOT COMMENTS 12/13/19	12/16/19
3	WVA PHASING	3/30/20