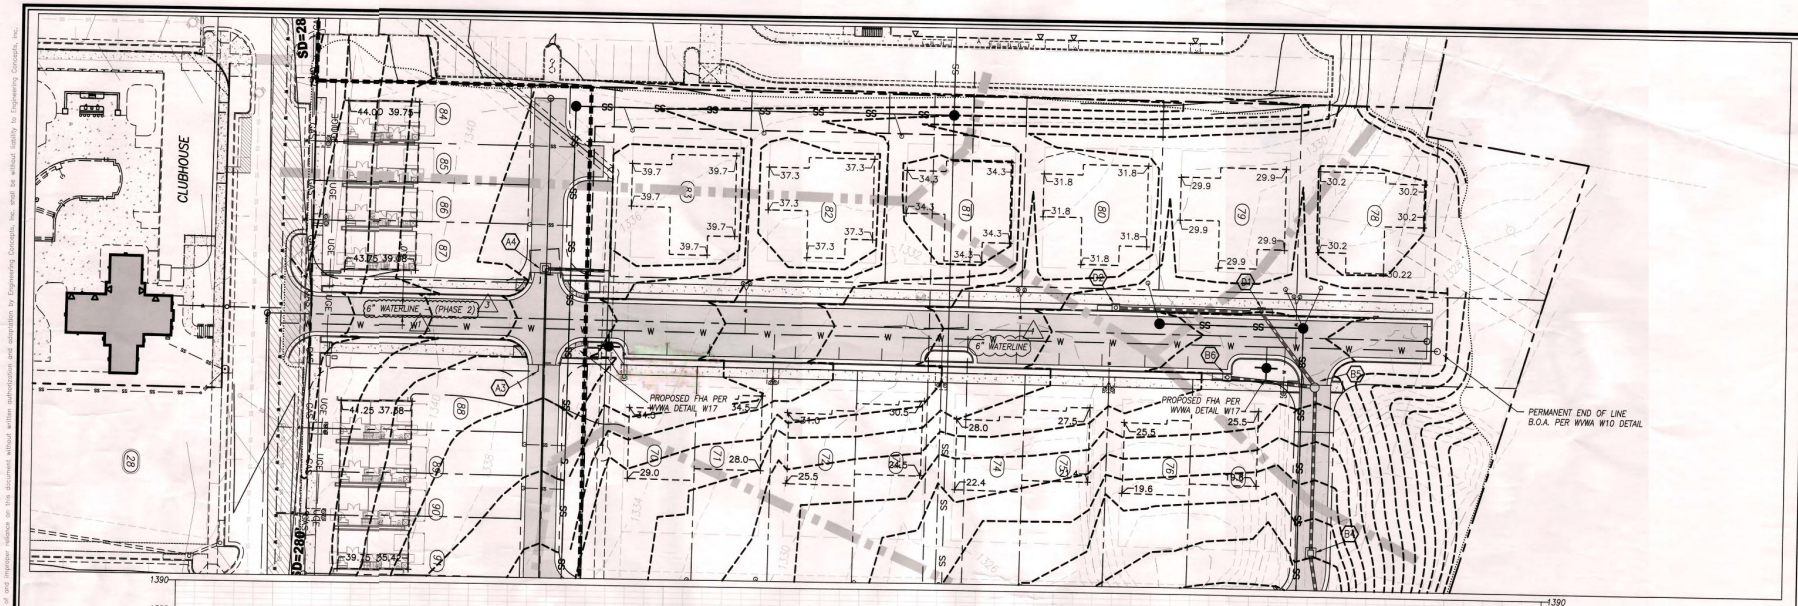

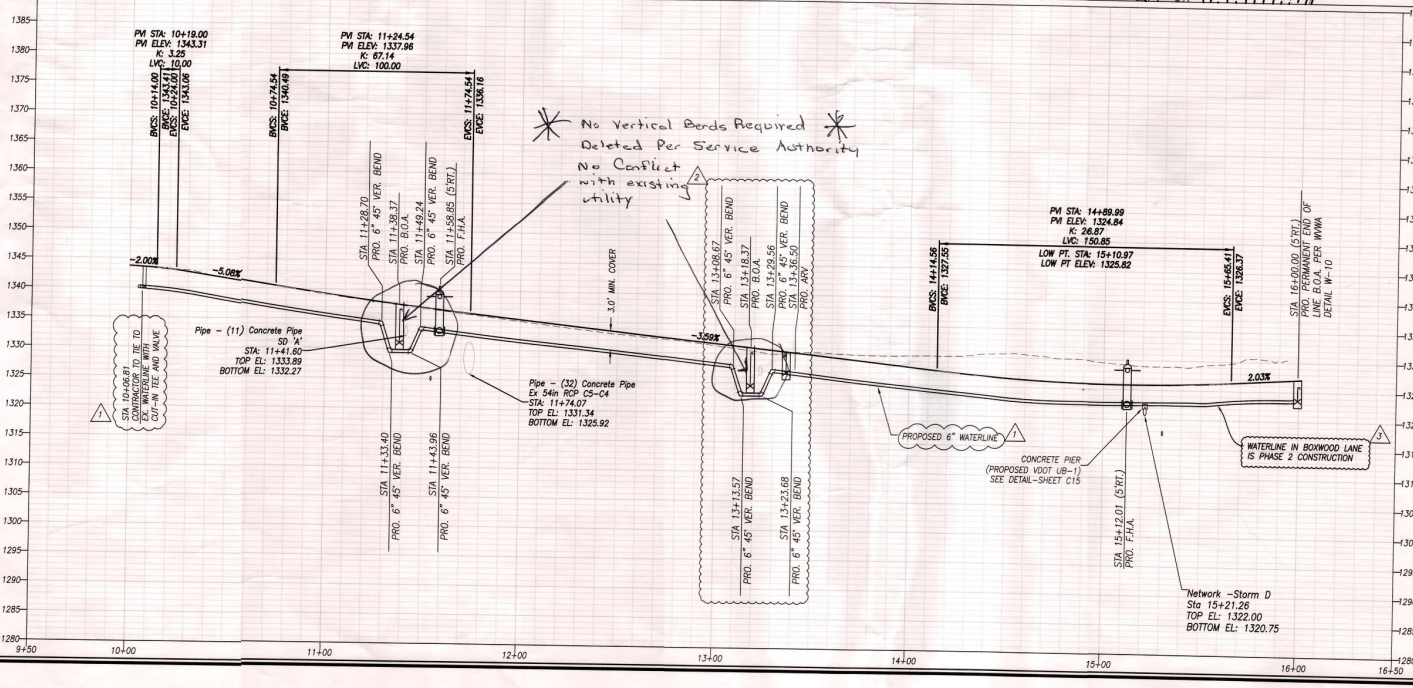

ENGINEERING CONCEPTS, INC.
94 GREENFIELD STREET
DALEVILLE, VIRGINIA 24083
540.473.1253

NORTH

No.	Description	Date
1	WVWA 7/2/19 COMMENTS	7/23/19
2	VDOT COMMENTS 12/13/19	12/16/19
3	WVWA PHASING	3/30/20
4	ADJUST LOT GRADES	04/15/20

DALEVILLE TOWN CENTER PH 3
BOTETOURT CO. VIRGINIA
BOXWOOD LANE PROFILE
WATERLINE PROFILE

COMMONWEALTH OF VIRGINIA
ROBERT H. WAMPLER, JR.
Lic. No. 34713
04/15/20
PROFESSIONAL ENGINEER

0 1 2
GRAPHIC SCALE

PROJECT: 18038

C13

This document, together with the concepts and designs presented herein, as an instrument of service, is intended only for the specific purpose and client for which it was prepared. Reuse of and improper reliance on this document without written authorization and adaptation by Engineering Concepts, Inc. shall be deemed risky by Engineering Concepts, Inc.