


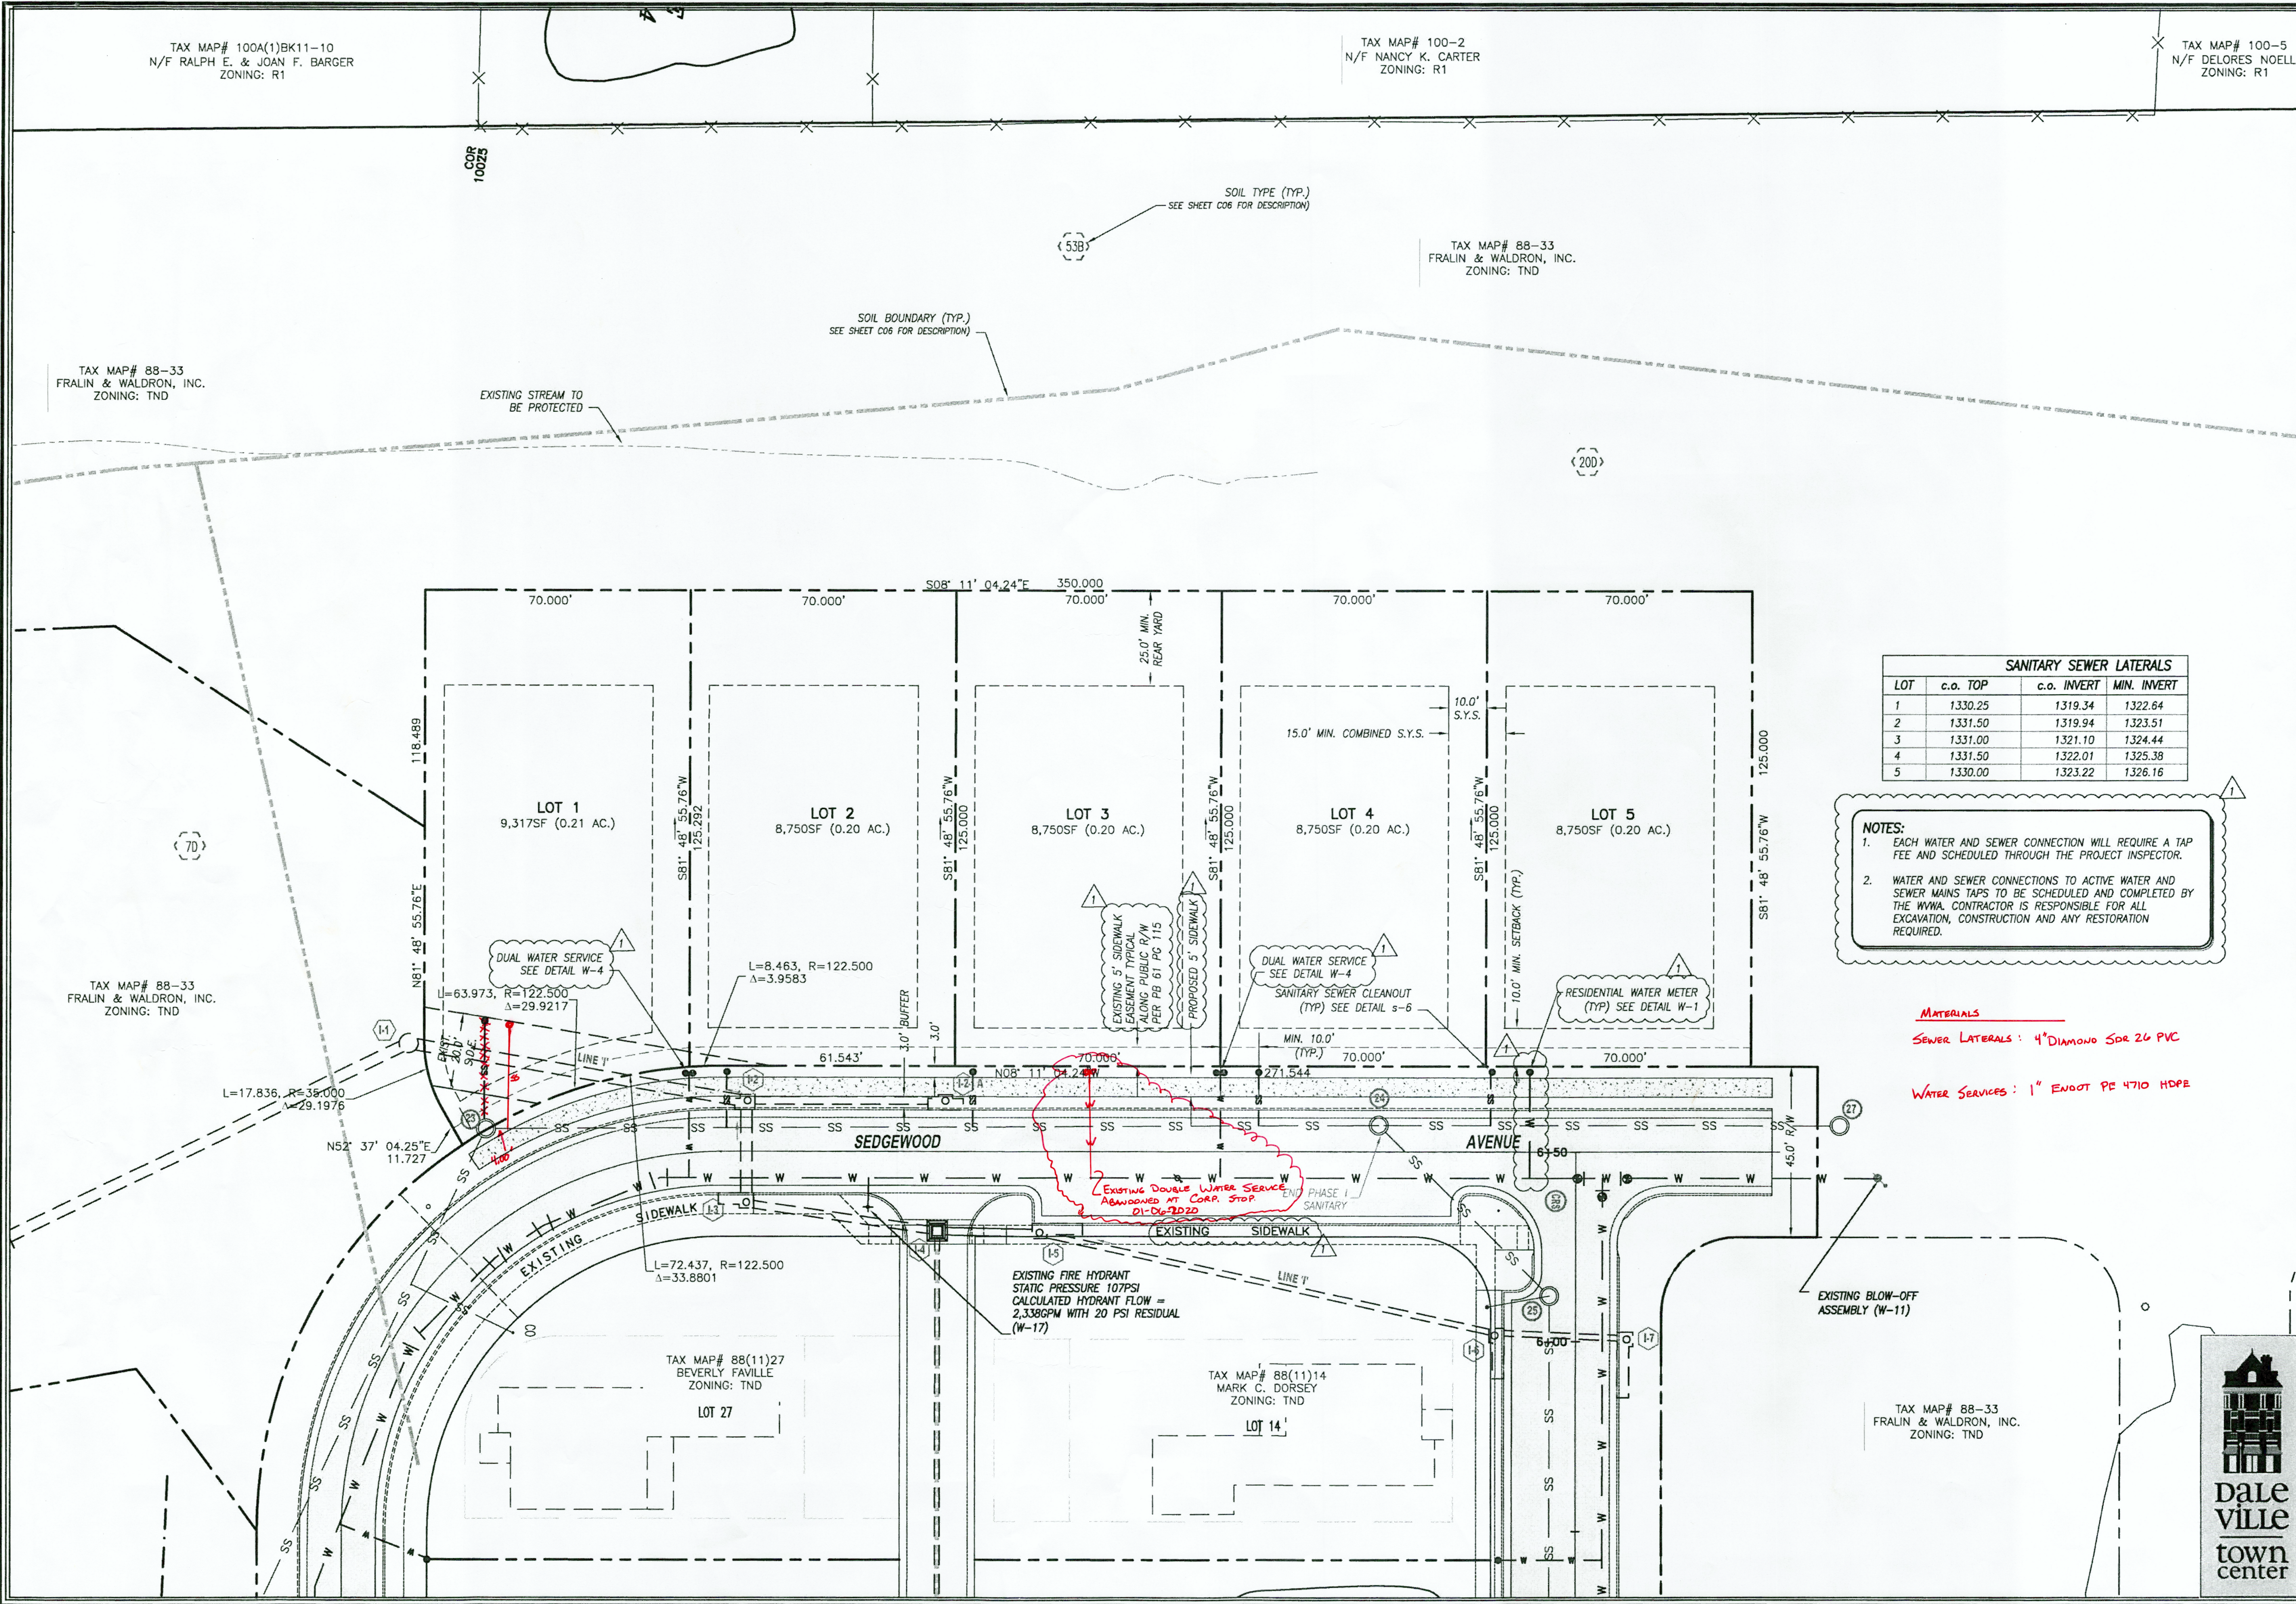


SANITARY SEWER LATERALS			
LOT	c.o. TOP	c.o. INVERT	MIN. INVERT
1	1330.25	1319.34	1322.64
2	1331.50	1319.94	1323.51
3	1331.00	1321.10	1324.44
4	1331.50	1322.01	1325.38
5	1330.00	1323.22	1326.16

- NOTES:
1. EACH WATER AND SEWER CONNECTION WILL REQUIRE A TAP FEE AND SCHEDULED THROUGH THE PROJECT INSPECTOR.
 2. WATER AND SEWER CONNECTIONS TO ACTIVE WATER AND SEWER MAINS TAPS TO BE SCHEDULED AND COMPLETED BY THE WMA. CONTRACTOR IS RESPONSIBLE FOR ALL EXCAVATION, CONSTRUCTION AND ANY RESTORATION REQUIRED.

MATERIALS


SEWER LATERALS : 4" DIAMOND SDR 26 PVC

WATER SERVICES : 1" ENJOOT PE 4710 HDPE

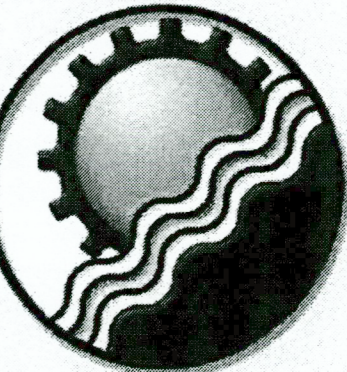

**ENGINEERING
CONCEPTS, INC.**

94 GREENFIELD STREET
DALEVILLE, VIRGINIA 24083
540.473.1253

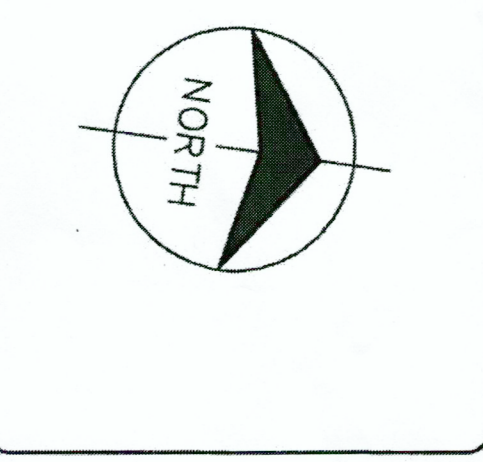


No.	Description	Date
1	P&Z & WMA	10/07/19
2		
3		
4		
5		

DALEVILLE TOWN CENTER-PH 2C


BOTETOURT COUNTY - VA

SEDGEWOOD AVENUE

SITE DIMENSIONAL PLAN

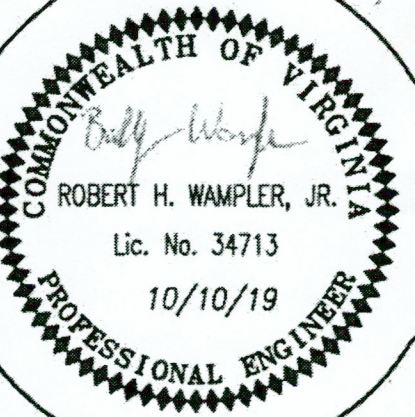

COMMONWEALTH OF VIRGINIA
ROBERT H. WAMPLER, JR.
Lic. No. 34713
10/10/19
PROFESSIONAL ENGINEER

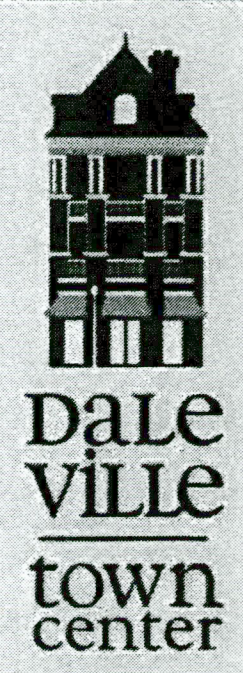

**DALEVILLE
town center**

0 20 40
GRAPHIC SCALE

PROJECT: 18038

C04