




El Rodeo Restaurant

At Daleville Town Center



Botetourt County - Virginia

April 19, 2016

RENAMED RODEO CHICO

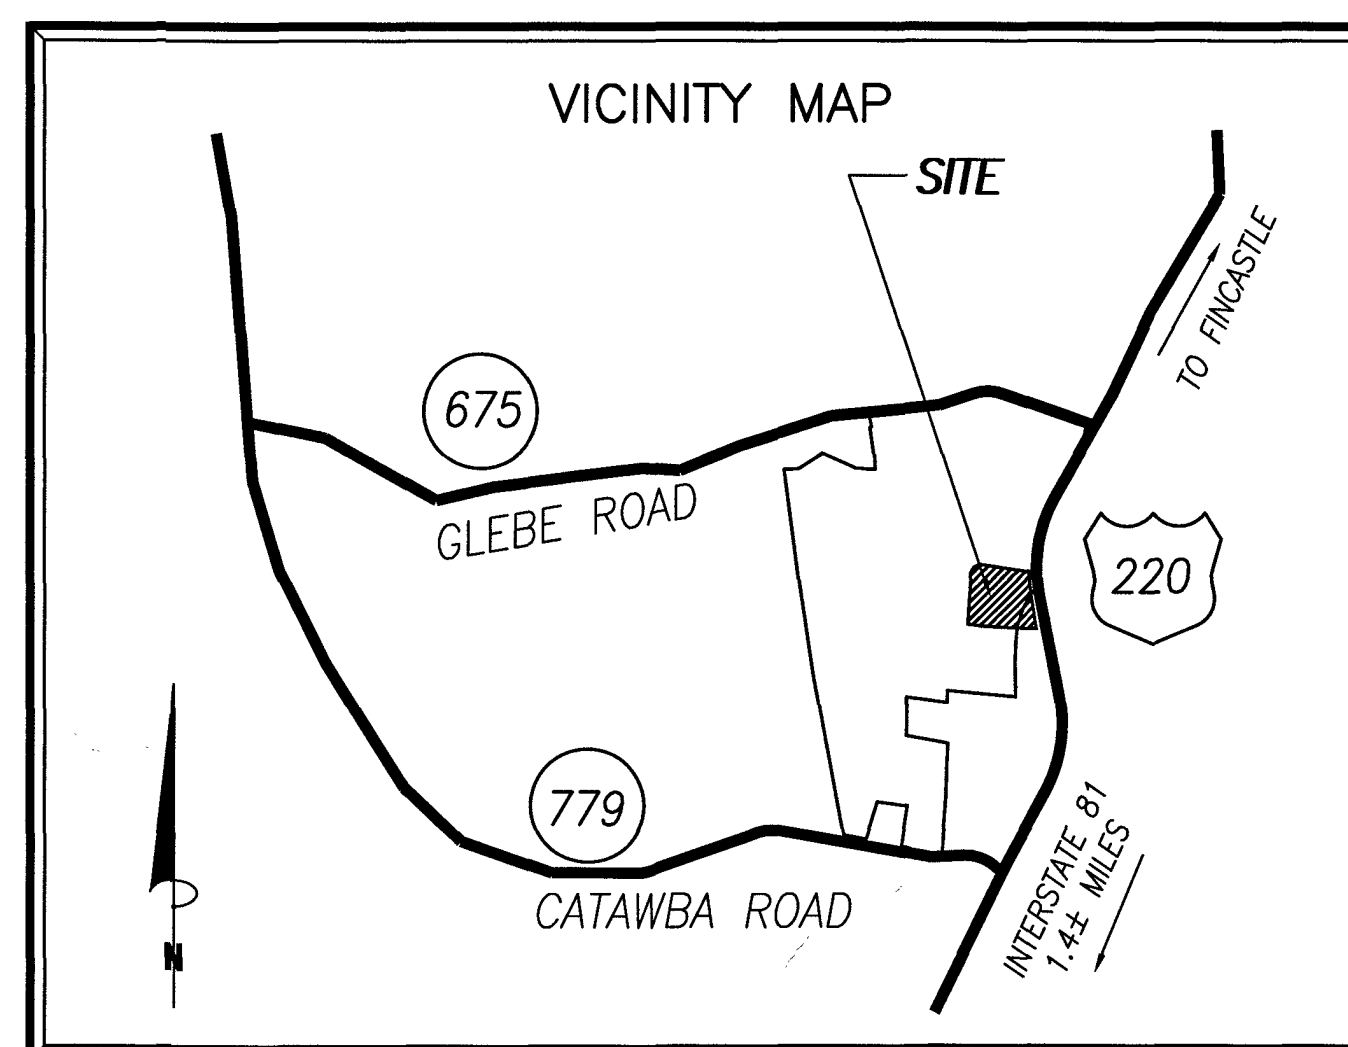

VICINITY MAP
NOT TO SCALE

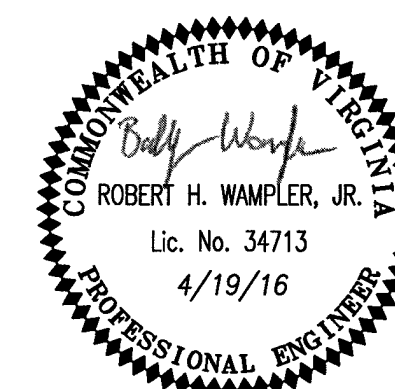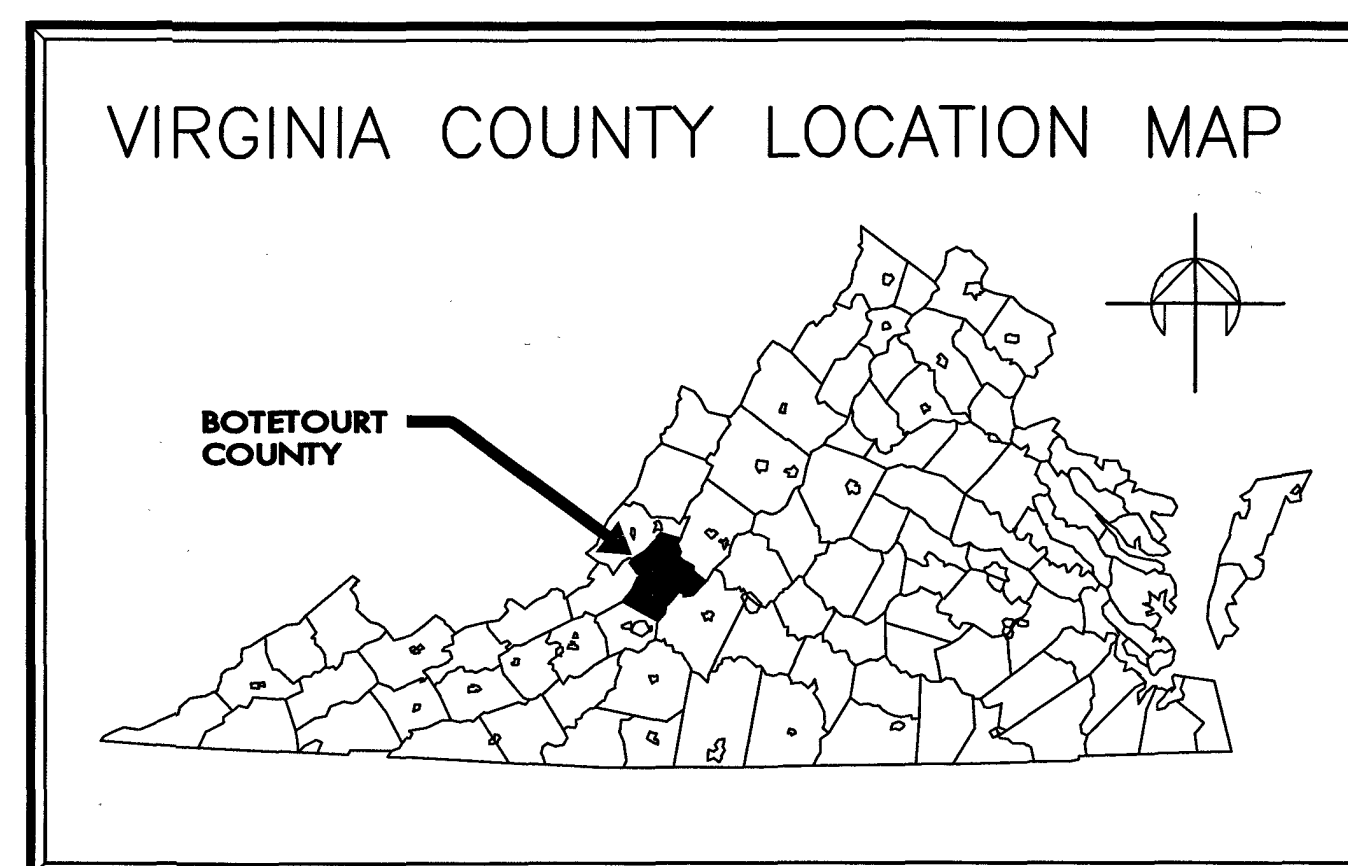


SHEET INDEX

- C1 COVER SHEET
- C2 GENERAL NOTES
- C3 PARKING PLAN
- C4 SITE DIMENSIONAL & UTILITY PLAN
- C5 SITE GRADING & EROSION CONTROL PLAN
- C6 LIGHTING AND PHOTOMETRICS PLAN
- C7 LANDSCAPE PLAN
- C8 UTILITY PROFILES & STORM CALCULATIONS
- C9 DRAINAGE MAP
- C10 SITE DETAILS
- C11 SITE DETAILS
- C12 UTILITY DETAILS
- C13 EROSION CONTROL NARRATIVE & DETAILS

ABBREVIATIONS

WSE	WATER SURFACE ELEVATION	SWM	STORM WATER MANAGEMENT
O.D.	OUTSIDE DIAMETER	ELEC	ELECTRIC (UNDERGROUND)
MH	MANHOLE	SS	SANITARY SEWER
XING	CROSSING	ARV	AIR RELEASE VALVE
GPM	GALLONS PER MINUTE	C.I.	CAST IRON
PSI	POUNDS PER SQUARE INCH	WL	WATERLINE
P.I.V.	POST INDICATOR VALVE	E	ELECTRIC (OVERHEAD)
SDR	STANDARD DIMENSION RATIO	C&P	CHESAPEAKE & POTOMAC
MIN	MINIMUM	STM	STEAM
LAT.	LATERAL	WV	WATER VALVE
ST	STORM DRAIN	CPU	UNDERGROUND COMPUTER CABLE
VERT.	VERTICAL	CONC	CONCRETE
HORIZ.	HORIZONTAL	T.C.	TERRA COTTA
BLDG.	BUILDING	SC	UNDERGROUND SATELLITE
SEP.	SEPARATION	INV	INVERT
D.I.	DROP INLET	V.D.O.T.	VIRGINIA DEPARTMENT OF TRANSPORTATION
C.O.	CLEANOUT	TYP.	TYPICAL
MAX.	MAXIMUM	ELEV.	ELEVATION
F.F.	FINISHED FLOOR	@	AT
FIN.	FINISHED	C	CENTERLINE
FOUND.	FOUNDATION	HD	HIGH DENSITY
O	OUTSIDE DIAMETER	PVC	POLYVINYL CHLORIDE
CLR.	CLEARANCE	F.H.	FIRE HYDRANT
T.O.F.	TOP OF FOOTING	TELE.	TELEPHONE
O.C.	ON CENTER	CMP	CORRUGATED METAL PIPE
REINF.	REINFORCEMENT	H.P.	HIGH POINT
SSMH	SANITARY SEWER MANHOLE	EXIST/EX	EXISTING
L.P.	LOW POINT	HDPE	HIGH DENSITY POLYETHYLENE
F	FOUNDATION DRAIN	V.M.I.	VIRGINIA MILITARY INSTITUTE
D	DOMESTIC SERVICE LINE	A.E.	AIR ENTRAINMENT
		TCxx.xx	TOP OF CURB ELEVATION
		Pxx.xx	PAVEMENT ELEVATION


CONTACTS

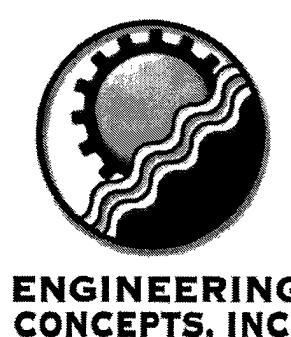

ENGINEERING CONCEPTS, INC.
Robert H. Wampler
President
P.O. Box 619 20 S. Roanoke Street
Fincastle, VA 24090
via e-mail: BWampler@EngineeringConcepts.com




El Rodeo
Elijio Arellano
41 Ashby Drive
Daleville, VA 24083 Ph: (540) 204-8214
elijioarellano@hotmail.com

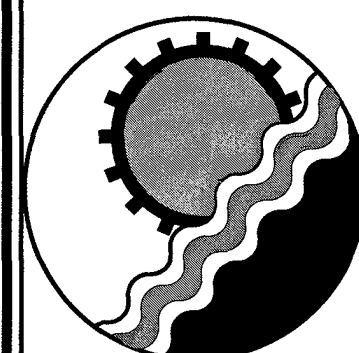

ENGINEERING CONCEPTS, INC.

20 S. ROANOKE ST., PO BOX 619
FINCASTLE, VIRGINIA 24090
540.473.1253 FAX: 540.473.1254

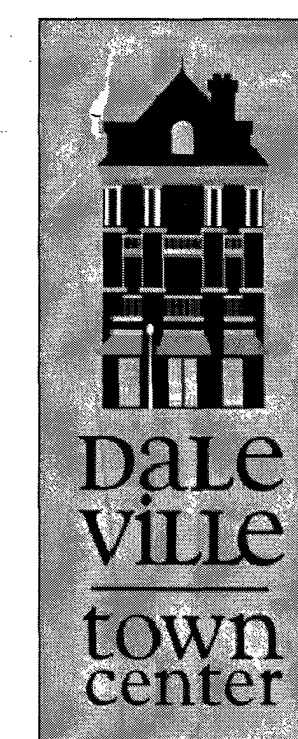

CHARLES CRUSH
AC BUILTS
07-21-17