


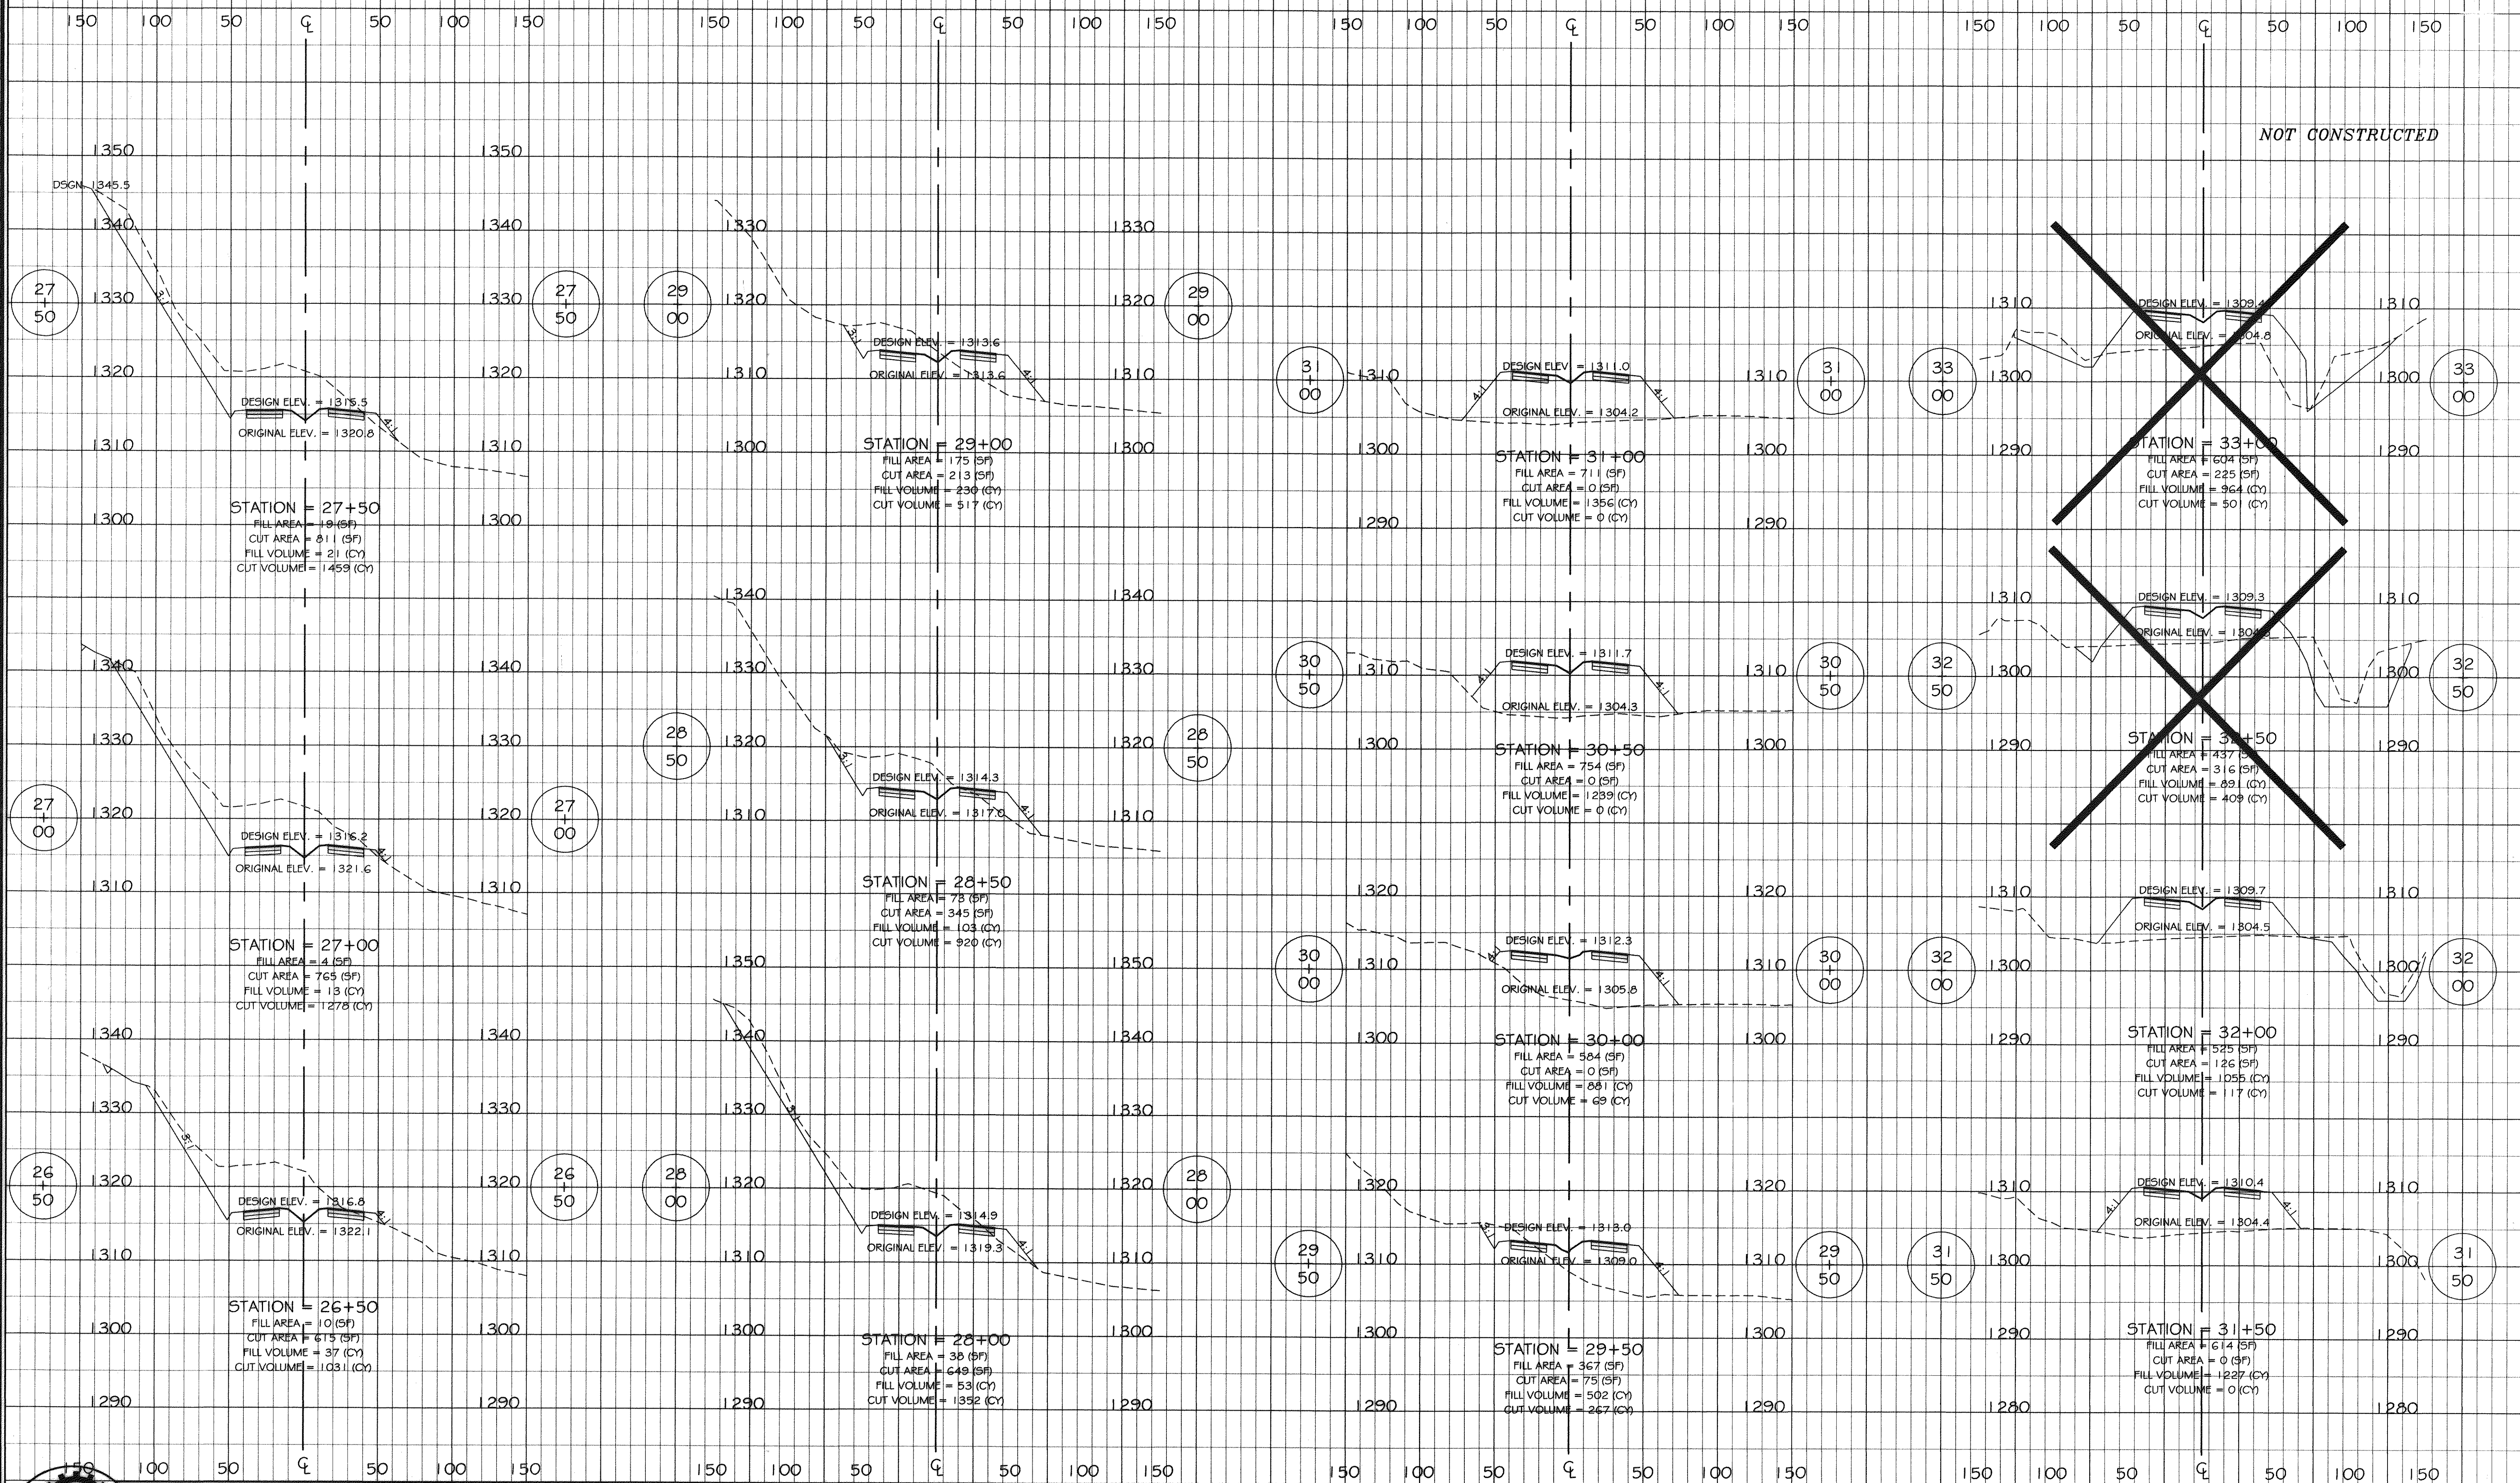

No.	Revision	By	Appd.	Date	Drawn	RHW
01	ADD 2" 21B BASE	RHW	JST	02/20/98	Designed	RHW
					Checked	WPJ
					Approved	JST