

DRAWING INDEX

1. GENERAL NOTES & KEY SHEET
2. SITE PLAN & E & S CONTROL
3. E & S CONTROL & SITE DETAILS
4. PLANTING PLAN
5. CHLORINE CONTACT & SCHOOL WATER LINES
6. WELLS 3 & 4 WATER LINE EXTENSION PLAN & PROFILE
7. WATER SYSTEM DETAILS
8. WELL DEVELOPMENT PLANS
9. SEWAGE FORCE MAIN PLAN & PROFILE & DETAILS
10. FOUNDATION & FLOOR PLAN, DOOR & FINISH SCHEDULE
11. INTERIOR PIPING PLAN
12. INTERIOR PIPING SECTION VIEWS
13. BUILDING ELEVATIONS
14. BUILDING DETAILS & MISC. DETAILS
15. BUILDING DETAILS & TYPICAL WALL SECTIONS
16. P & ID SCHEMATIC
17. PLUMBING
18. MECHANICAL
19. ELECTRICAL

GENERAL NOTES

1. INFORMATION ON THESE DRAWINGS CONCERNING THE LOCATION AND ELEVATION OF EXISTING UTILITIES, STRUCTURES, AND OBSTRUCTIONS HAS BEEN PREPARED FROM THE MOST RELIABLE INFORMATION AVAILABLE TO THE ENGINEER. THE ACCURACY AND COMPLETENESS OF THIS INFORMATION ARE NOT GUARANTEED, HOWEVER, NOR DOES THE ENGINEER ACCEPT ANY RESPONSIBILITY WHATSOEVER FOR DEVIATIONS OF THE EXISTING UTILITIES, STRUCTURES, OTHER FACILITIES, AND OBSTRUCTIONS FROM THE LOCATIONS AND ELEVATIONS INDICATED OR FOR THE EXISTENCE OF UTILITIES, STRUCTURES, OTHER FACILITIES, AND OBSTRUCTIONS NOT INDICATED ON THESE DRAWINGS.
2. THE CONTRACTOR SHALL EXERCISE EXTREME CAUTION TO ELIMINATE ANY POSSIBILITY OF ANY DISTURBANCE OF OR DAMAGE TO PUBLIC AND PRIVATELY-OWNED UTILITIES, STRUCTURES, OTHER FACILITIES, AND OBSTRUCTIONS RESULTING FROM HIS ACTIVITIES. TO THIS END, CONTRACTOR SHALL, AT NO ADDITIONAL COST TO THE OWNER, TAKE ALL MEASURES NECESSARY TO PROVIDE, AND SHALL BE SOLELY RESPONSIBLE FOR, TEMPORARY SUPPORT AND SHORING, ADEQUATE PROTECTION, AND MAINTENANCE OF CONTINUOUS OPERATION OF ALL UNDERGROUND AND ABOVEGROUND WATER, SEWER, AND GAS MAINS AND SERVICE LINES, PETROLEUM LINES, TELEPHONE, TELEVISION, AND ELECTRICAL LINES, CABLES, AND POLES; EQUIPMENT CABLES AND CONDUITS; STORM SEWERS; BUILDINGS; TANKS; FENCES; AND ALL OTHER UTILITIES, STRUCTURES, FACILITIES, AND OBSTRUCTIONS, WHETHER OR NOT INDICATED ON THESE DRAWINGS. ALL DISTURBED OR DAMAGED UTILITIES, STRUCTURES, OTHER FACILITIES, AND OBSTRUCTIONS SHALL BE IMMEDIATELY REPAIRED, REPLACED, OR COMPENSATED FOR BY THE CONTRACTOR TO OWNER'S SATISFACTION, AND AT NO ADDITIONAL COST TO THE OWNER.
3. THE CONTRACTOR SHALL BEAR SOLE RESPONSIBILITY FOR THE CHARACTER AND ACTUAL LOCATIONS AND ELEVATIONS OF ALL EXISTING UTILITIES, STRUCTURES, OTHER FACILITIES, AND OBSTRUCTIONS WITHIN THE PROJECT AREA. THE CONTRACTOR SHALL, AT NO ADDITIONAL COST TO THE OWNER, CONTACT THE OWNERS/OPERATORS OF ALL UTILITIES AND ARRANGE FOR THE VERIFICATION AND MARKING OF UTILITY LOCATIONS BY SAID OWNERS/OPERATORS. THE CONTRACTOR SHALL ASSIST THE UTILITY OWNERS/OPERATORS BY EVERY MEANS POSSIBLE TO DETERMINE THE LOCATION OF UTILITIES. THE CONTRACTOR SHALL BEAR SOLE RESPONSIBILITY FOR ALL DISTURBANCE OF ANY DAMAGE TO UTILITIES RESULTING FROM THE CONTRACTOR'S FAILURE TO ARRANGE FOR THE LOCATION OF UTILITIES BY THE OWNERS/OPERATORS OF THE UTILITIES. CONTACT MISS UTILITY (800) 552-7001.
4. SITE CONDITIONS MAY NECESSITATE SLIGHT DEVIATIONS IN ALIGNMENT, GRADE, AND/OR LOCATION OF NEW FACILITIES FROM THE ALIGNMENT, GRADE, AND/OR LOCATION INDICATED ON THESE DRAWINGS. THE CONTRACTOR SHALL CONSTRUCT THE NEW FACILITIES TO SUCH DEVIATIONS AS DIRECTED BY THE ENGINEER WITHOUT INCREASE IN THE CONTRACT PRICE.
5. THE CONTRACTOR SHALL MAINTAIN A CLEAR FLOW PATH TO AND THROUGH ALL SURFACE WATER AND STORM WATER DRAINAGE FACILITIES AT ALL TIMES.
6. THE CONTRACTOR SHALL GRADE, SEED, AND/OR SOD, AND MULCH THE ENTIRE AREA(S) DISTURBED BY CONSTRUCTION ACTIVITIES.
7. CONSTRUCTION AND START-UP OF ALL WORK SHALL NOT INTERFERE WITH THE OPERATION OF WATER AND SEWERAGE FACILITIES. THE CONTRACTOR SHALL COORDINATE AND SCHEDULE ALL WORK WITH THE OWNERS AS REQUIRED.
8. MINIMUM COVER ON ALL PIPE SHALL BE 3 FEET, UNLESS OTHERWISE SPECIFICALLY INDICATED ON THESE DRAWINGS. ALL PVC PIPE SHALL BE INSTALLED WITH COATED TRACER WIRE TO FACILITATE FUTURE LOCATION OF PIPE AFTER CONSTRUCTION IS COMPLETED.
9. WHERE IT IS NECESSARY TO DEFLECT PIPE EITHER HORIZONTALLY OR VERTICALLY, PIPE JOINT DEFLECTION OR BARREL BEND RADIUS SHALL NOT EXCEED 75% OF THE MANUFACTURER'S RECOMMENDED DEFLECTION ANGLE OR BEND RADIUS.
10. ALL PIPING SHALL BE PROPERLY SUPPORTED. ALL PIPING WHICH WILL BE PRESSURIZED DURING OPERATION SHALL BE PROPERLY RESTRAINED.
11. ALL CONSTRUCTION SHALL BE IN COMPLIANCE WITH THE CURRENT BOCA AND/OR STATE AND LOCAL BUILDING CODES AND WITH CURRENT FEDERAL AND STATE OSHA REGULATIONS.
12. CONTRACTOR SHALL MAINTAIN THE CONSTRUCTION AREA IN A MANNER ACCEPTABLE TO OWNER AND SHALL BE RESPONSIBLE FOR REMEDIATING ANY DAMAGES RESULTING FROM FAILURE TO DO SO.
13. CONTRACTOR SHALL MAINTAIN LIMITS OF CONSTRUCTION WITHIN THE BOUNDARIES OF THE PROPERTY AS INDICATED ON THE SITE PLAN.
14. IDENTIFIED PROTECTED WETLAND MUST NOT HAVE ANY DISTURBANCE WITHIN 50 FEET OF THEIR BOUNDARY AS IDENTIFIED ON SITE PLAN.
15. CONTRACTOR SHALL MAINTAIN EXISTING GRAVEL ACCESS ROAD AT PRE-PROJECT CONDITIONS.

SEQUENCING NOTE

CONTINUOUS WATER SERVICE MUST BE MAINTAINED TO BOTETOURT COUNTY RECREATION & MAINTENANCE BUILDING. BUILDING IS CURRENTLY SERVED BY SMALL PUMP IN WELL #3.

KEY CONTACTS

1. BOTETOURT COUNTY
ASSISTANT COUNTY ADMINISTRATOR: KURT HODGEN, 540-473-8316
COUNTY ENGINEER: KEVIN SHEARER, P.E. 540-473-8316
UTILITY SUPERVISOR: PAUL PEERY, 540-473-8316
ASSISTANT COUNTY ENGINEER: JAY KNIGHT, 540-473-8316
2. ENGINEERING CONCEPTS, INC.
PAUL NIEHOFF, E.I.T. 540-473-1253
WILLIAM JOHNSON, P.E. 540-473-1253
JIM TALIAN, P.E. 540-473-1253


ACCESS NOTE

ACCESS TO SITE SHALL BE FROM ETZLER ROAD ONLY. CONTRACTOR MAY NEED TO COORDINATE ACCESS TO SITE WITH PROPOSED VDOT PAVING ON ENTRANCE ROAD.

PARENTHESIS NOTES


TEXT WITHIN PARENTHESIS () IS UPDATED INFORMATION AS OF 2018

(BOTETOURT CENTER AT GREENFIELD)

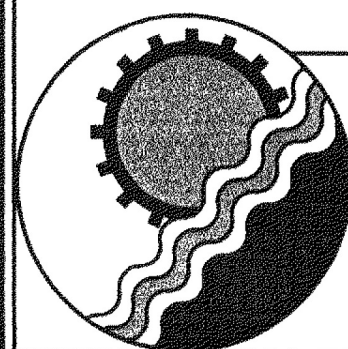

ENGINEERING CONCEPTS, INC.

20 S. ROANOKE ST., PO BOX 619
FINCASTLE, VIRGINIA 24090
540.473.1253 FAX: 540.473.1254

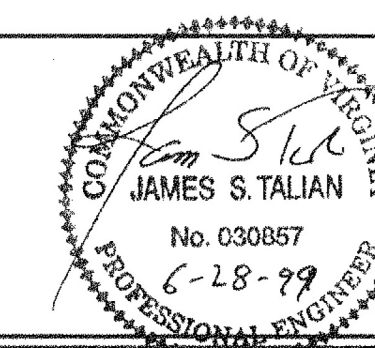

Drawn	PSN	GREENFIELD CHLORINATION FACILITY	1"=500'
Designed	PSN		JUNE 1999
Checked	JST		PROJECT: 97075
Approved	JST		1 of 19

**GENERAL NOTES AND
KEYSHEET**