



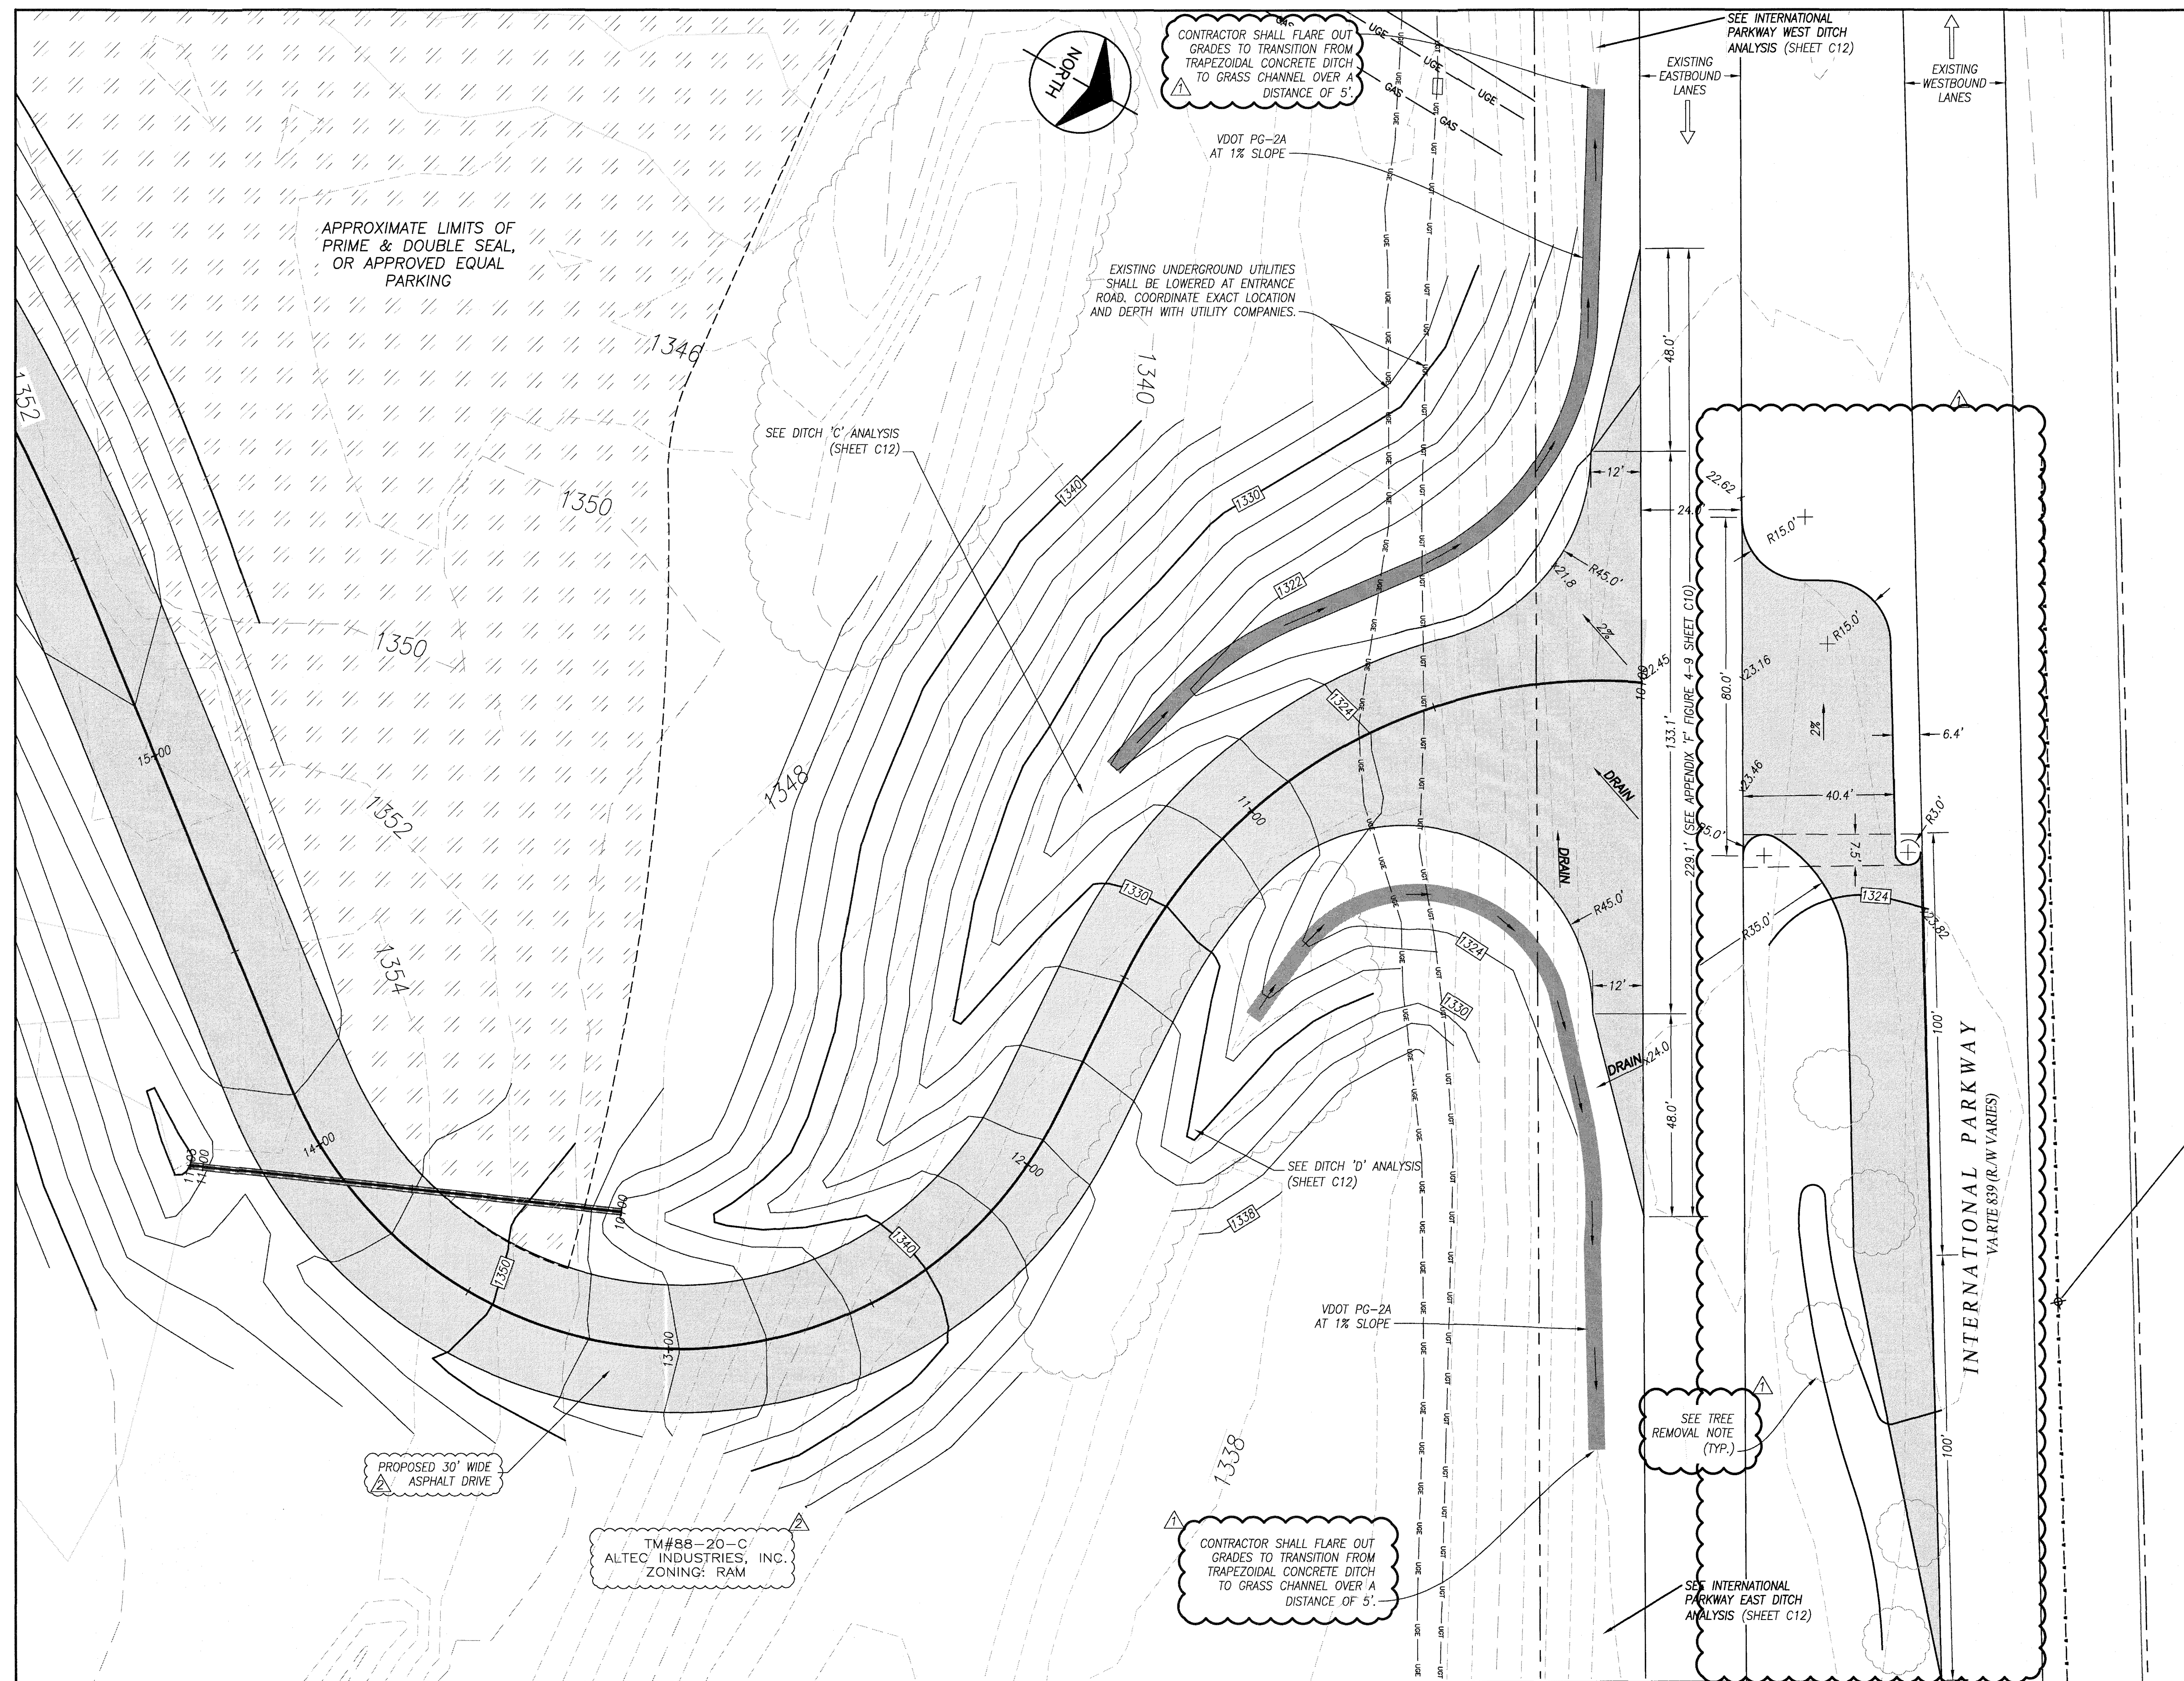


TREE REMOVAL NOTE:
CONTRACTOR SHALL REMOVE EXISTING TREES WITHIN MEDIAN, AS NECESSARY FOR CONSTRUCTION OF CROSS-OVER. ANY TREES WITHIN 12' OF THE NEW EDGE OF PAVEMENT SHALL BE REQUIRED TO BE REMOVED.

ENTRANCE & CROSSOVER DETAIL
SCALE: 1"=20'

NOTE: A VDOT LAND USE PERMIT WILL BE REQUIRED PRIOR TO ANY CONSTRUCTION WITHIN THE VDOT RIGHT-OF-WAY.

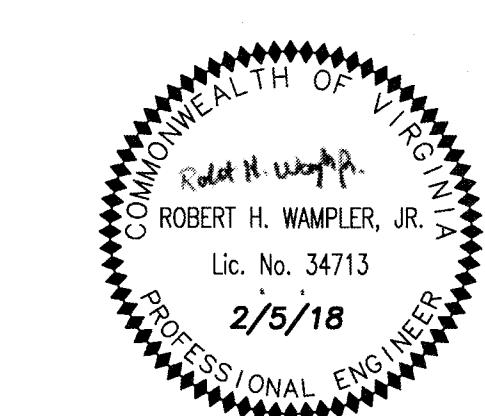

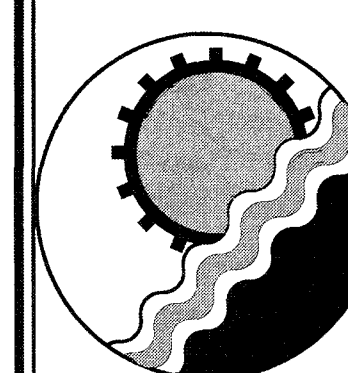

ENGINEERING CONCEPTS, INC.
94 GREENFIELD STREET
DALEVILLE, VIRGINIA 24083
540.473.1253

No.	Revision	By	Appd.	Date	Drawn	MSMJ	ENTRANCE & CROSSOVER DETAIL ACCESS DRIVE & BUILDING EXPANSION ALTEC INDUSTRIES AT GREENFIELD BOTETOURT COUNTY VIRGINIA	SCALE: 1"=30'
1	VDOT COMMENTS	ECI	RHW	2/5/18	Designed	ECI		2/5/18
2	BotCo COMMENTS 2/2/18	ECI	RHW	2/16/18	Checked	ECI		PROJECT: 17058
					Approved	ECI		C04
						RHW		