



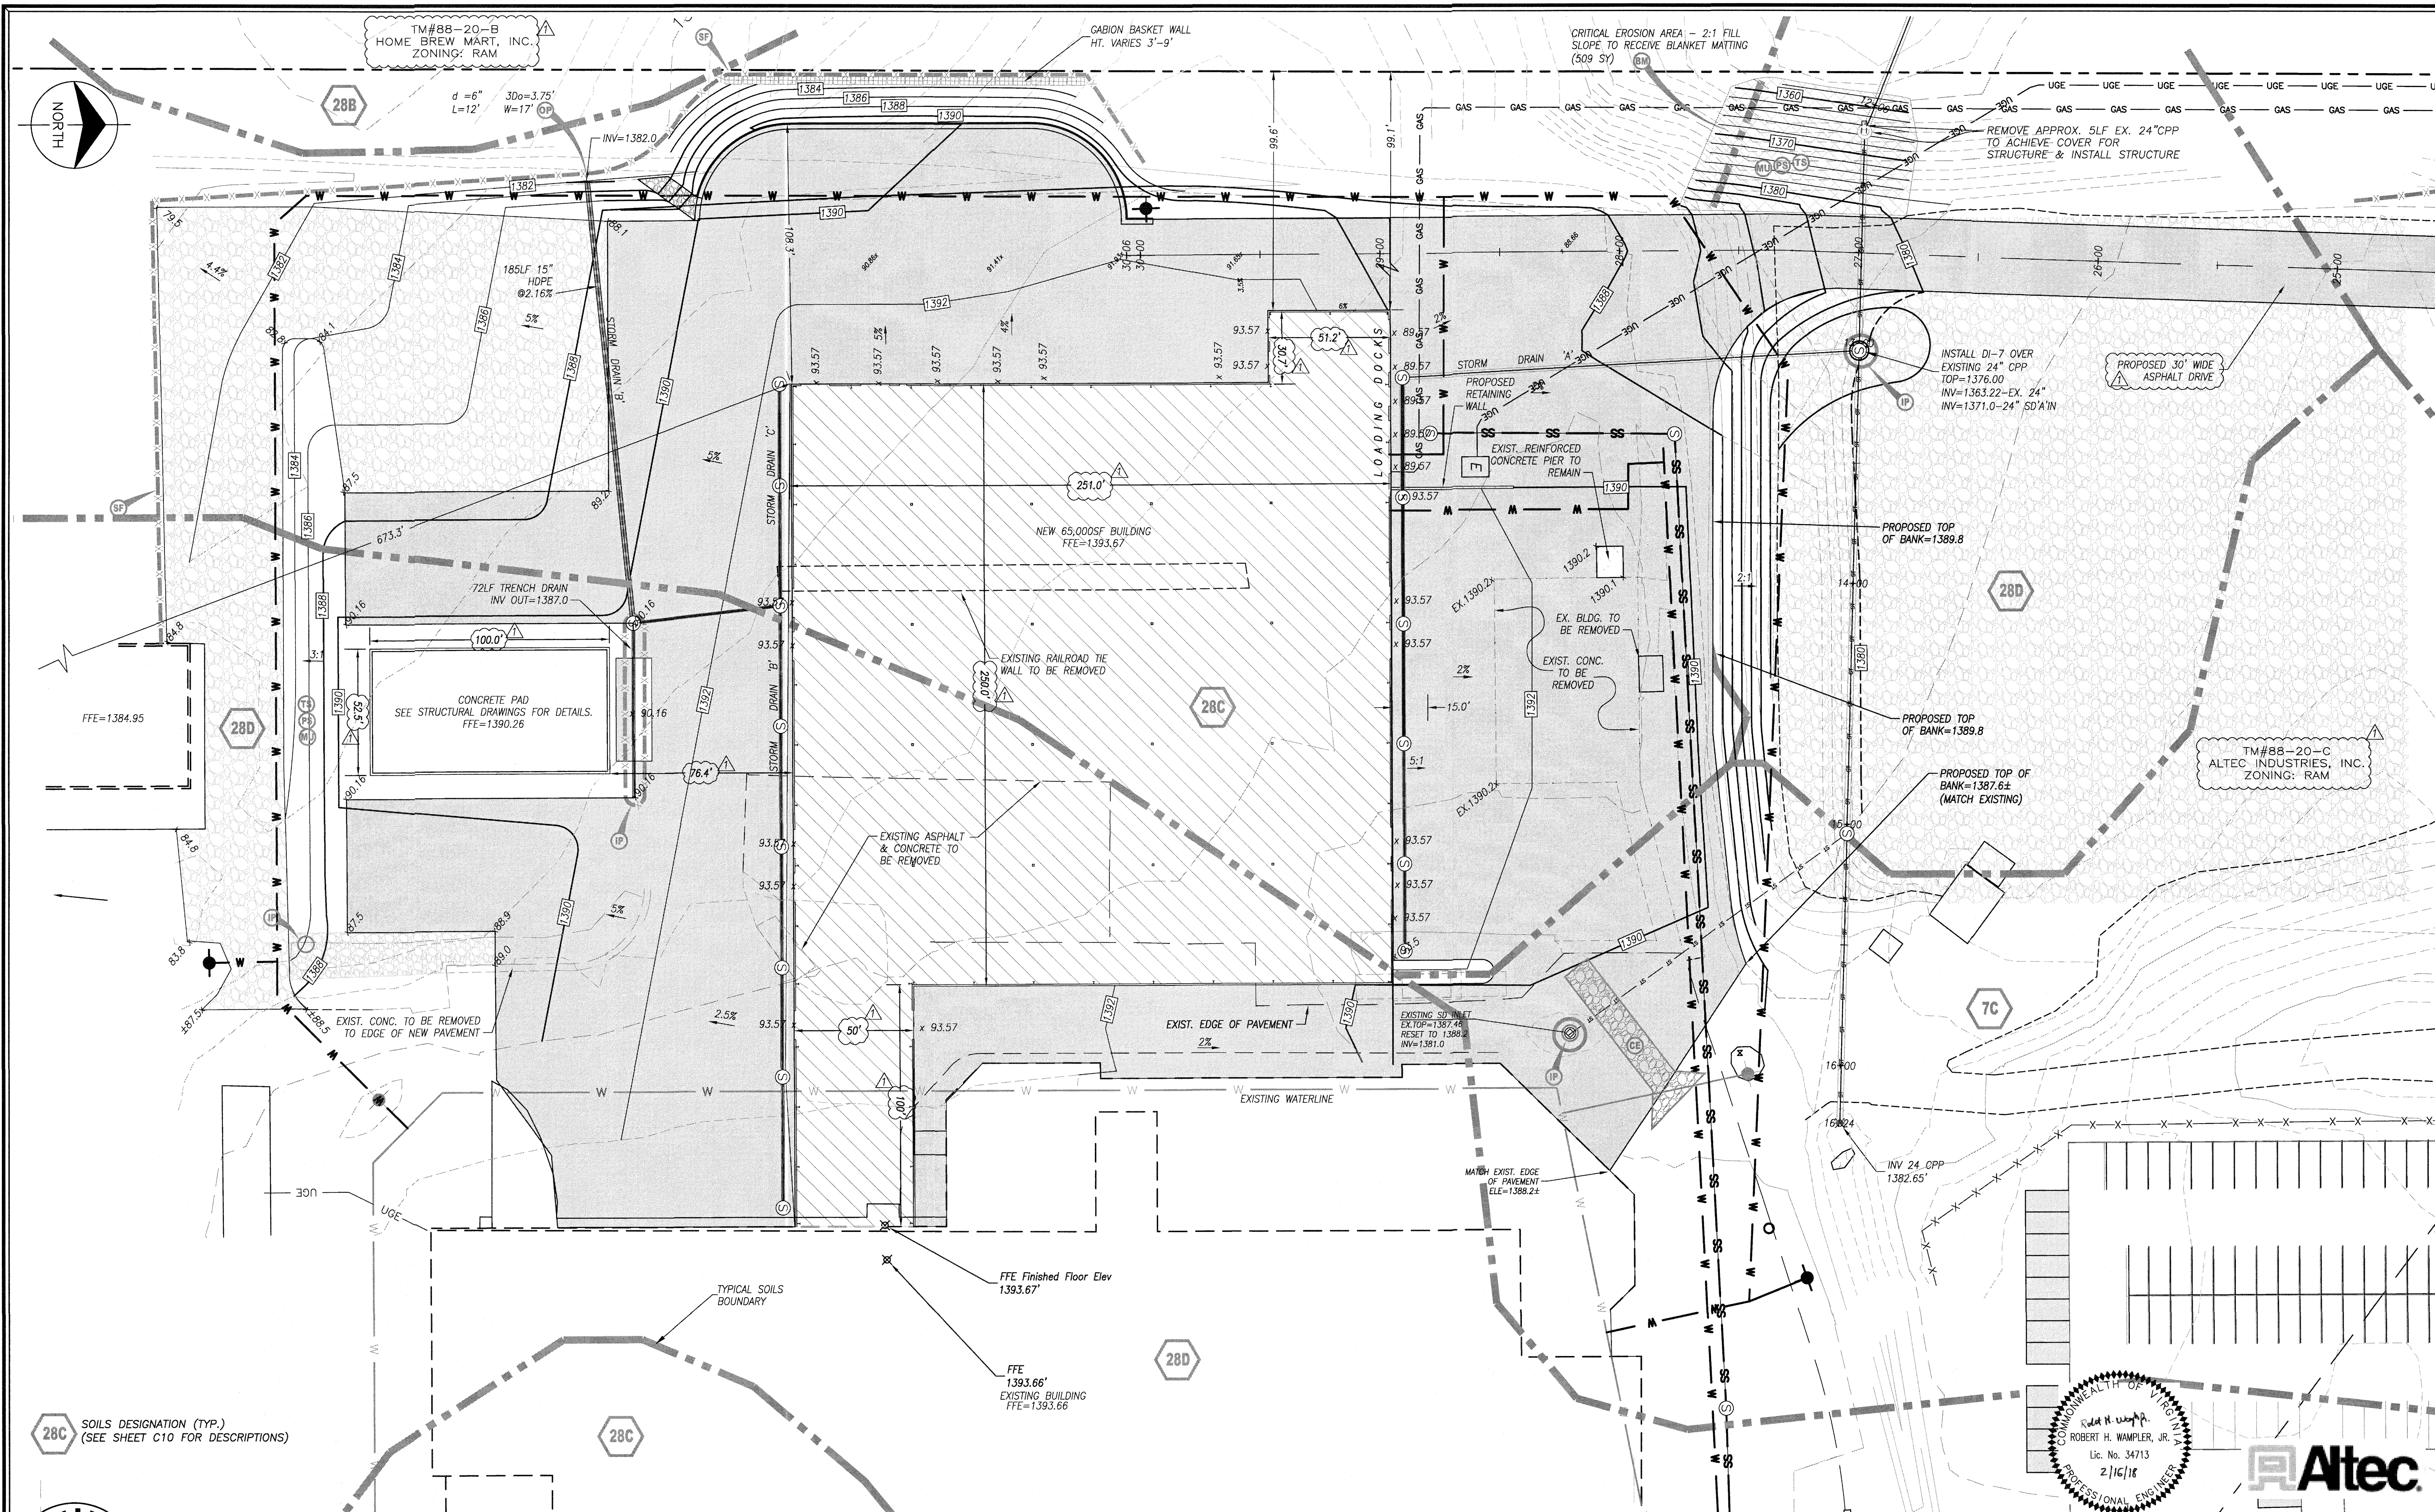

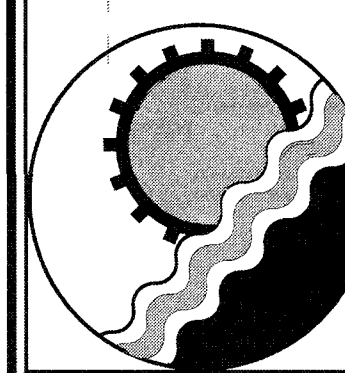

ENGINEERING CONCEPTS, INC.
94 GREENFIELD STREET
DALEVILLE, VIRGINIA 24083
540.473.1253

No.	Revision	By	Appd.	Date	Drawn
1	BotCo COMMENTS 2/2/18	ECI	RHW	2/16/18	MSMJ
					Designed ECI
					Checked ECI
					Approved RHW

BUILDING EXPANSION GRADING PLAN
ACCESS DRIVE & BUILDING EXPANSION

ALTEC INDUSTRIES AT GREENFIELD
BOTETOURT COUNTY VIRGINIA

SCALE: 1"=30'

DATE: OCT. 4, 2017

PROJECT: 17058

C07

