


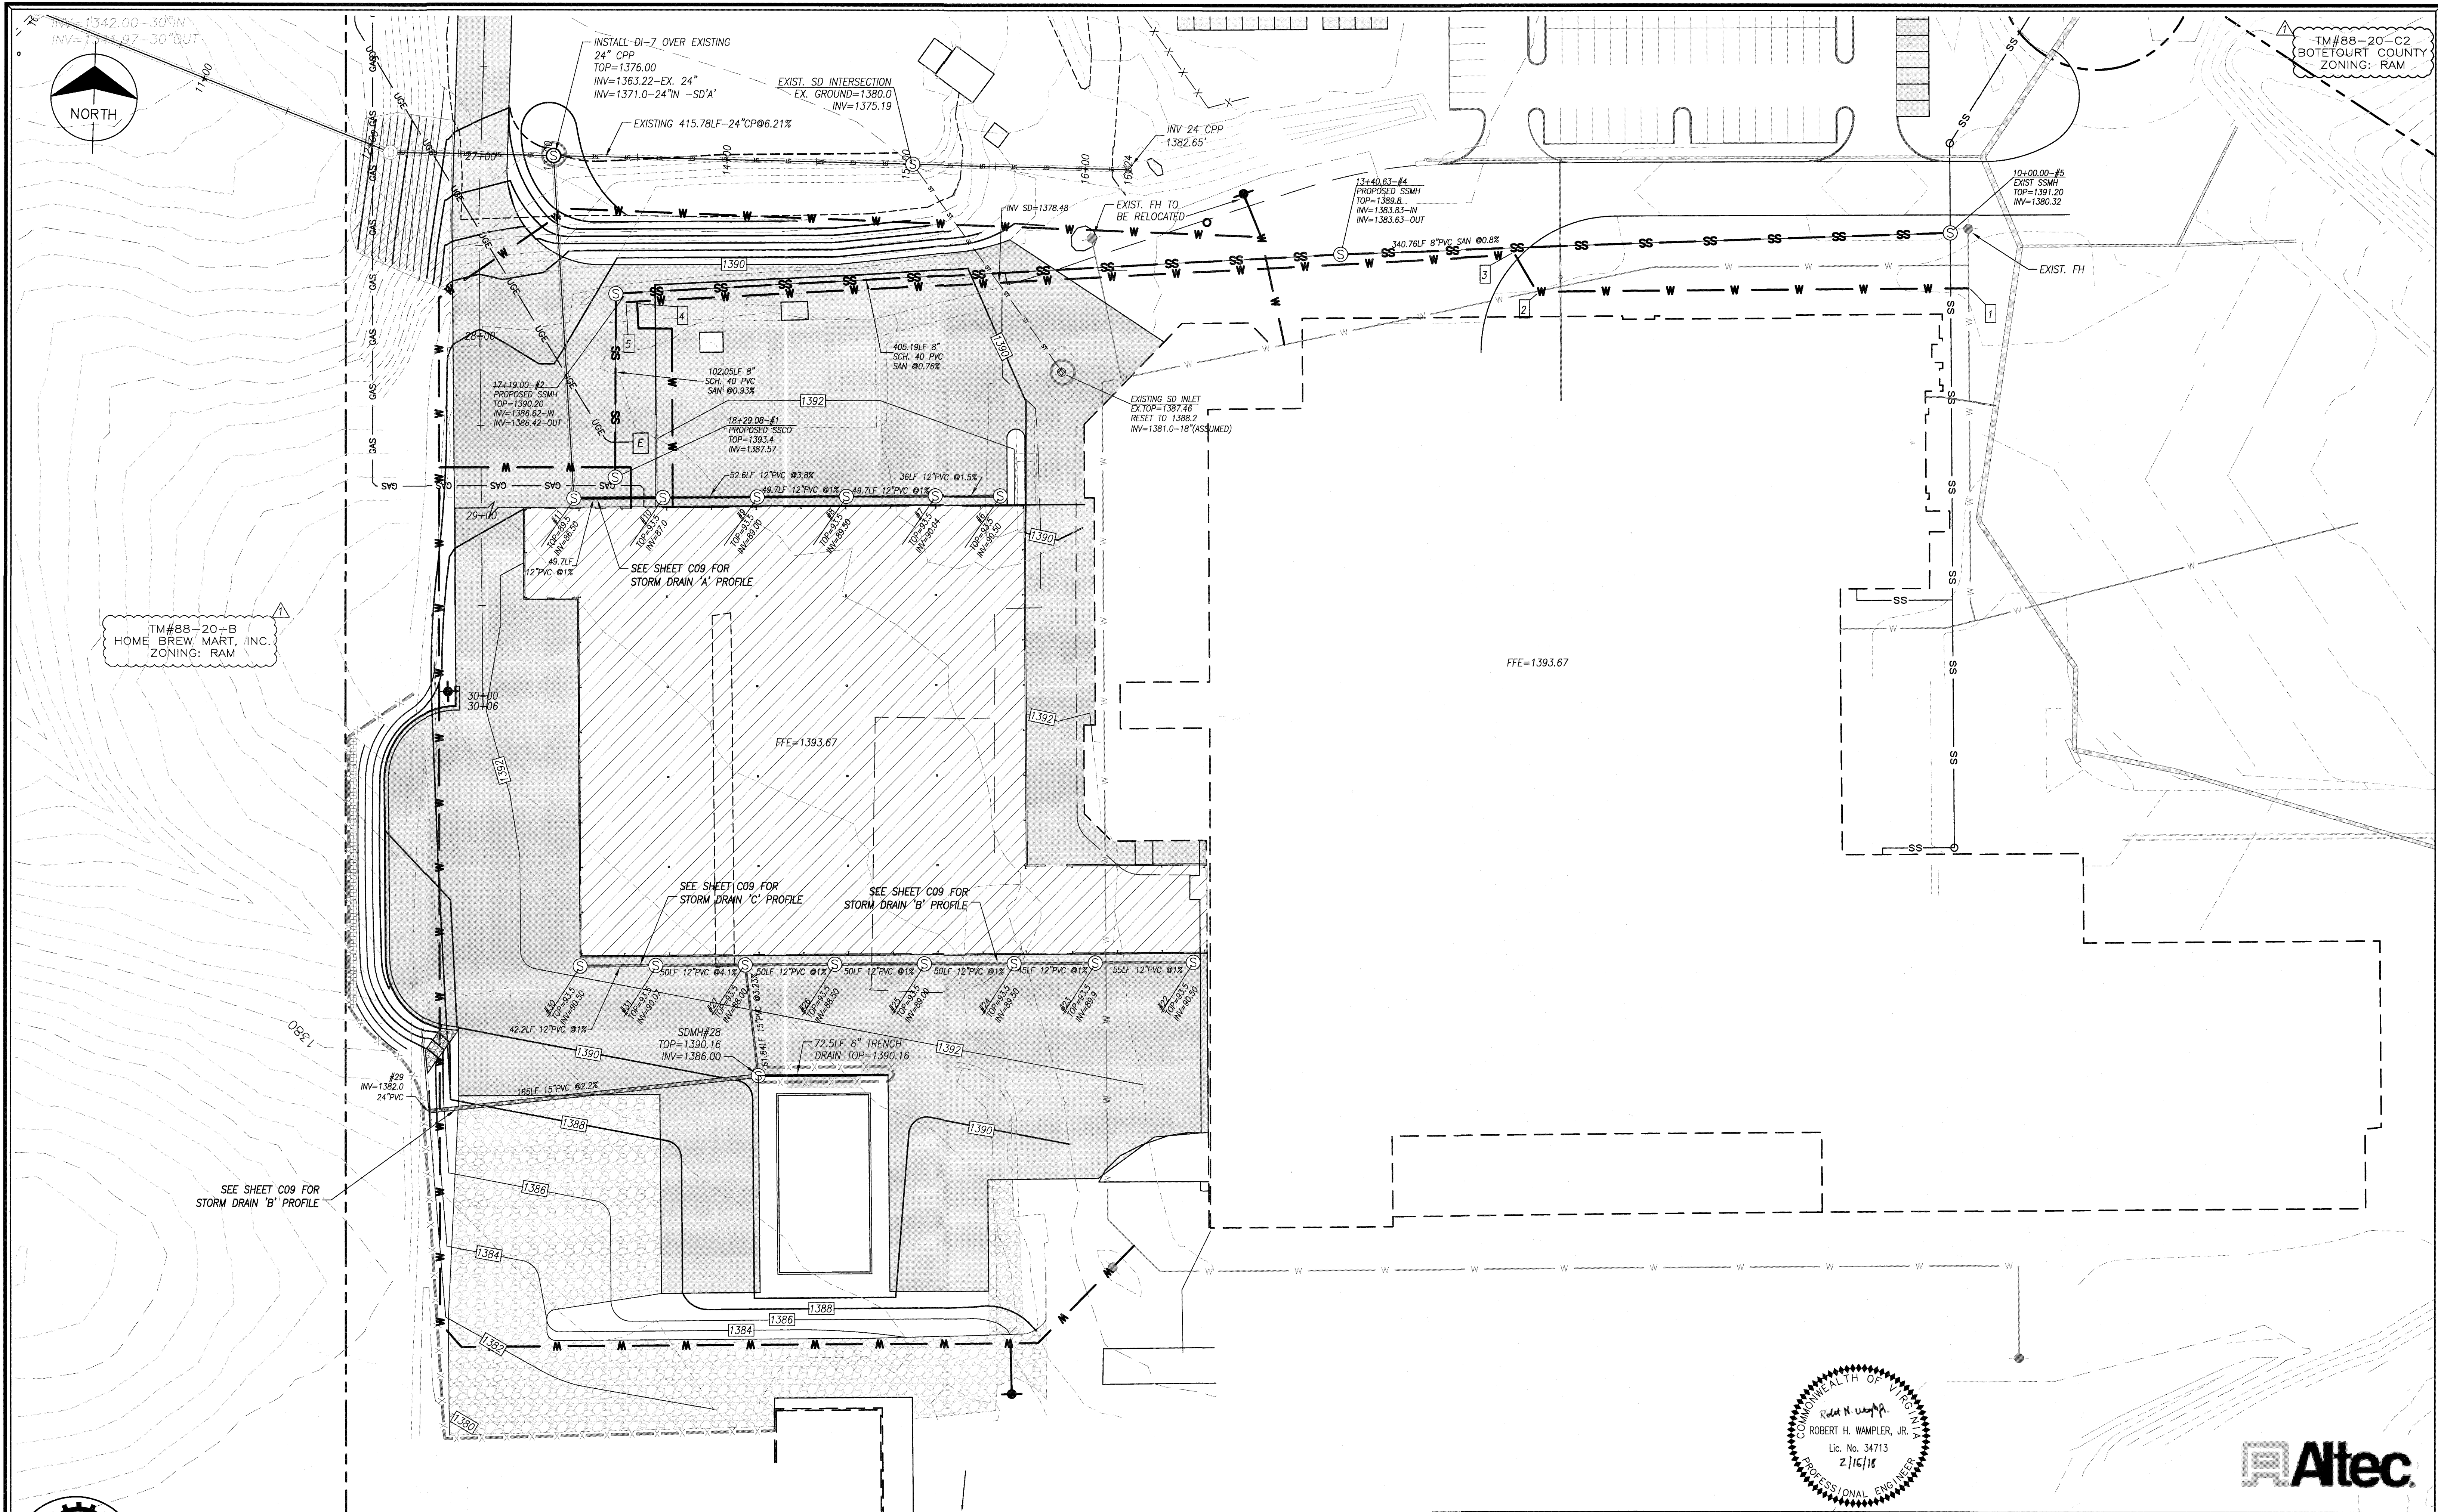

No.	Revision	By	Appd.	Date	Drawn
1	BotCo COMMENTS 2/2/18	ECI	RHW	2/16/18	MSMJ
					Designed ECI
					Checked ECI
					Approved RHW

**BUILDING EXPANSION UTILITY PLAN
 ACCESS DRIVE & BUILDING EXPANSION**
**ALTEC INDUSTRIES AT GREENFIELD
 BOTETOURT COUNTY VIRGINIA**

SCALE: 1"=40'
 DATE: OCT. 4, 2017
 PROJECT: 17058
C08