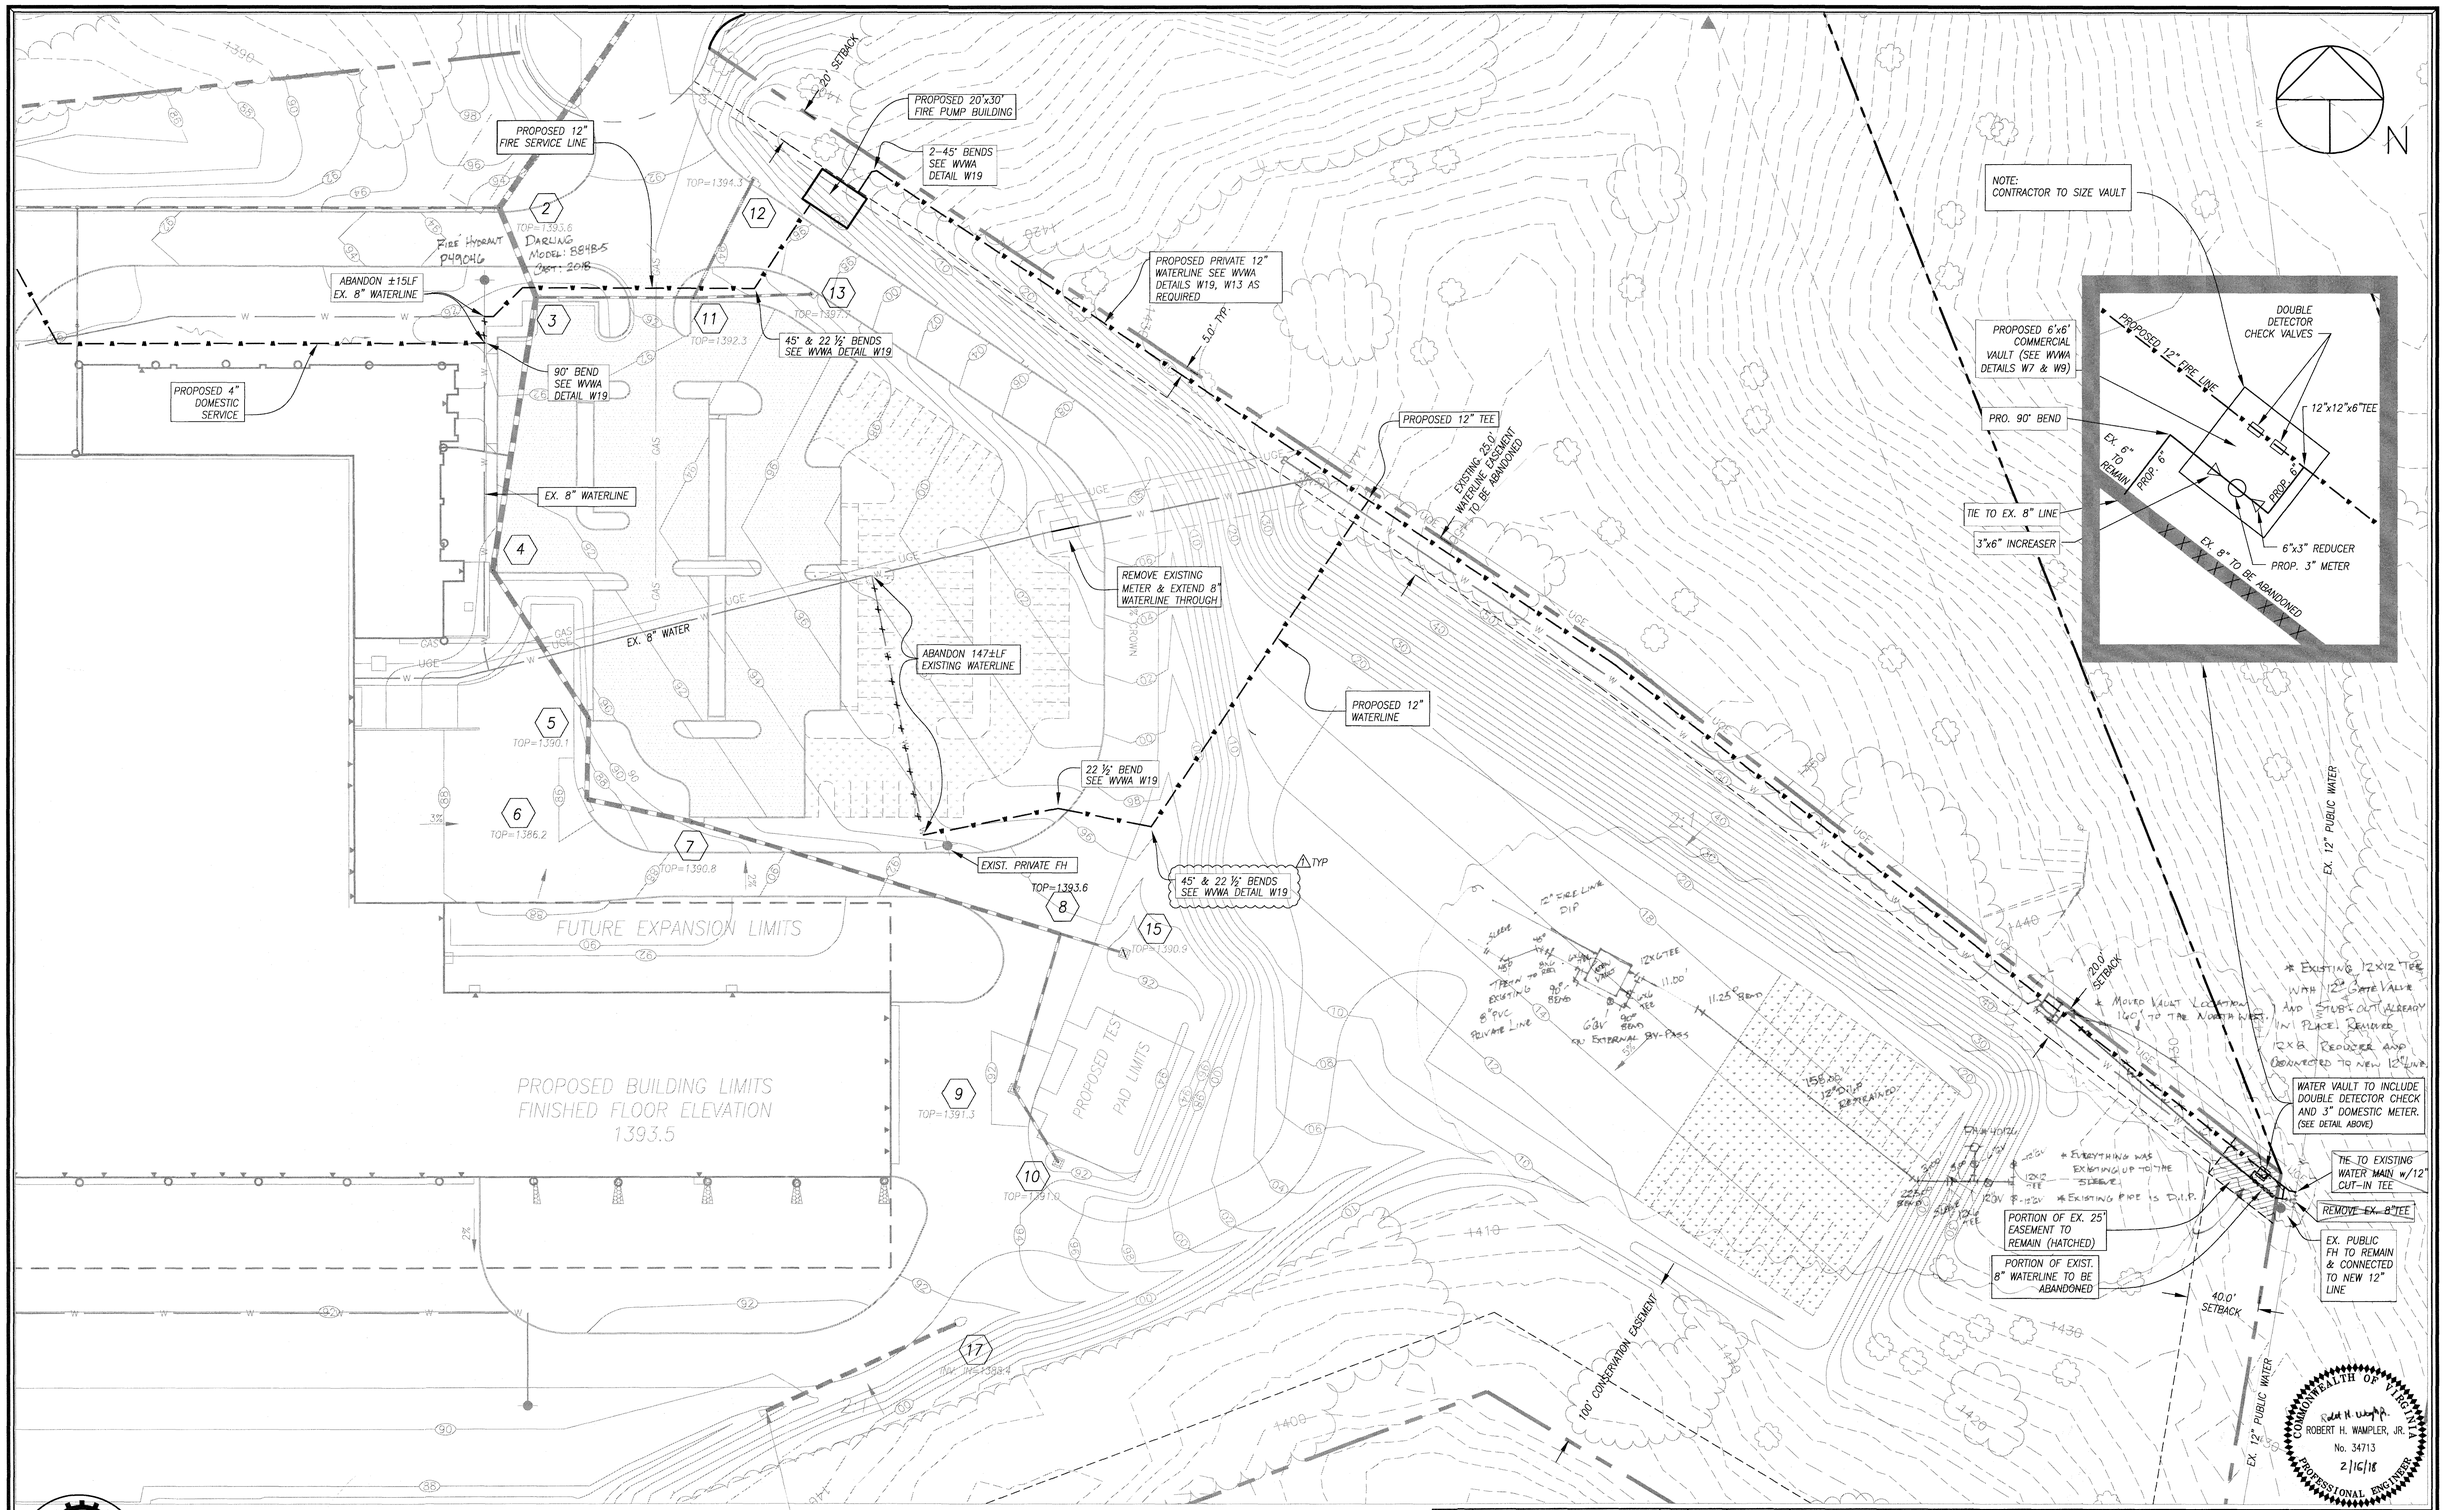

ENGINEERING CONCEPTS, INC.
94 GREEENFIELD STREET
DALEVILLE, VIRGINIA 24083
540.473.1253

No.	Revision	By	Appd.	Date
1	WVWA Comments	ECI	RHW	2/16/18

Drawn MSMj
Designed ECI
Checked RHW
Approved RHW

FIRE SERVICE REVISIONS FOR ALTEC INDUSTRIES

325 S. CENTER DRIVE
BOTETOURT COUNTY – VIRGINIA

SCALE: 1"=40'
DATE: JAN 25, 2018
PROJECT: 17058

C18