
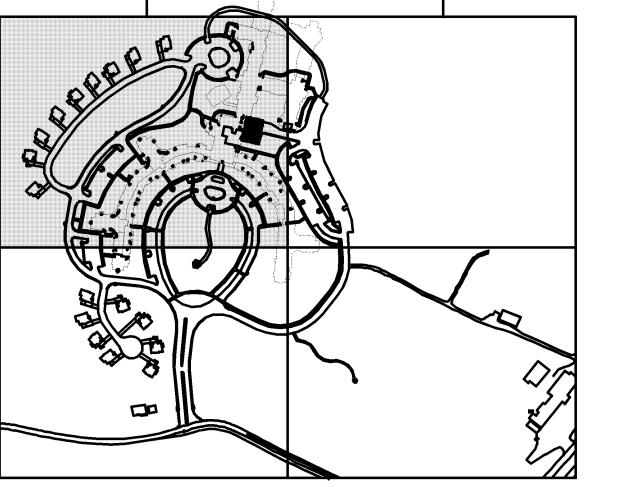




ROOF COLLECTORS HAVE BEEN ADDED TO PLANS.

ELEVATIONS SHOWN 1366.7 ARE TOP OF CURB UNLESS OTHERWISE NOTED.
 ELEVATIONS SHOWN 72.6 OR 72+6 ARE SPOT ELEVATIONS UNLESS OTHERWISE NOTED.

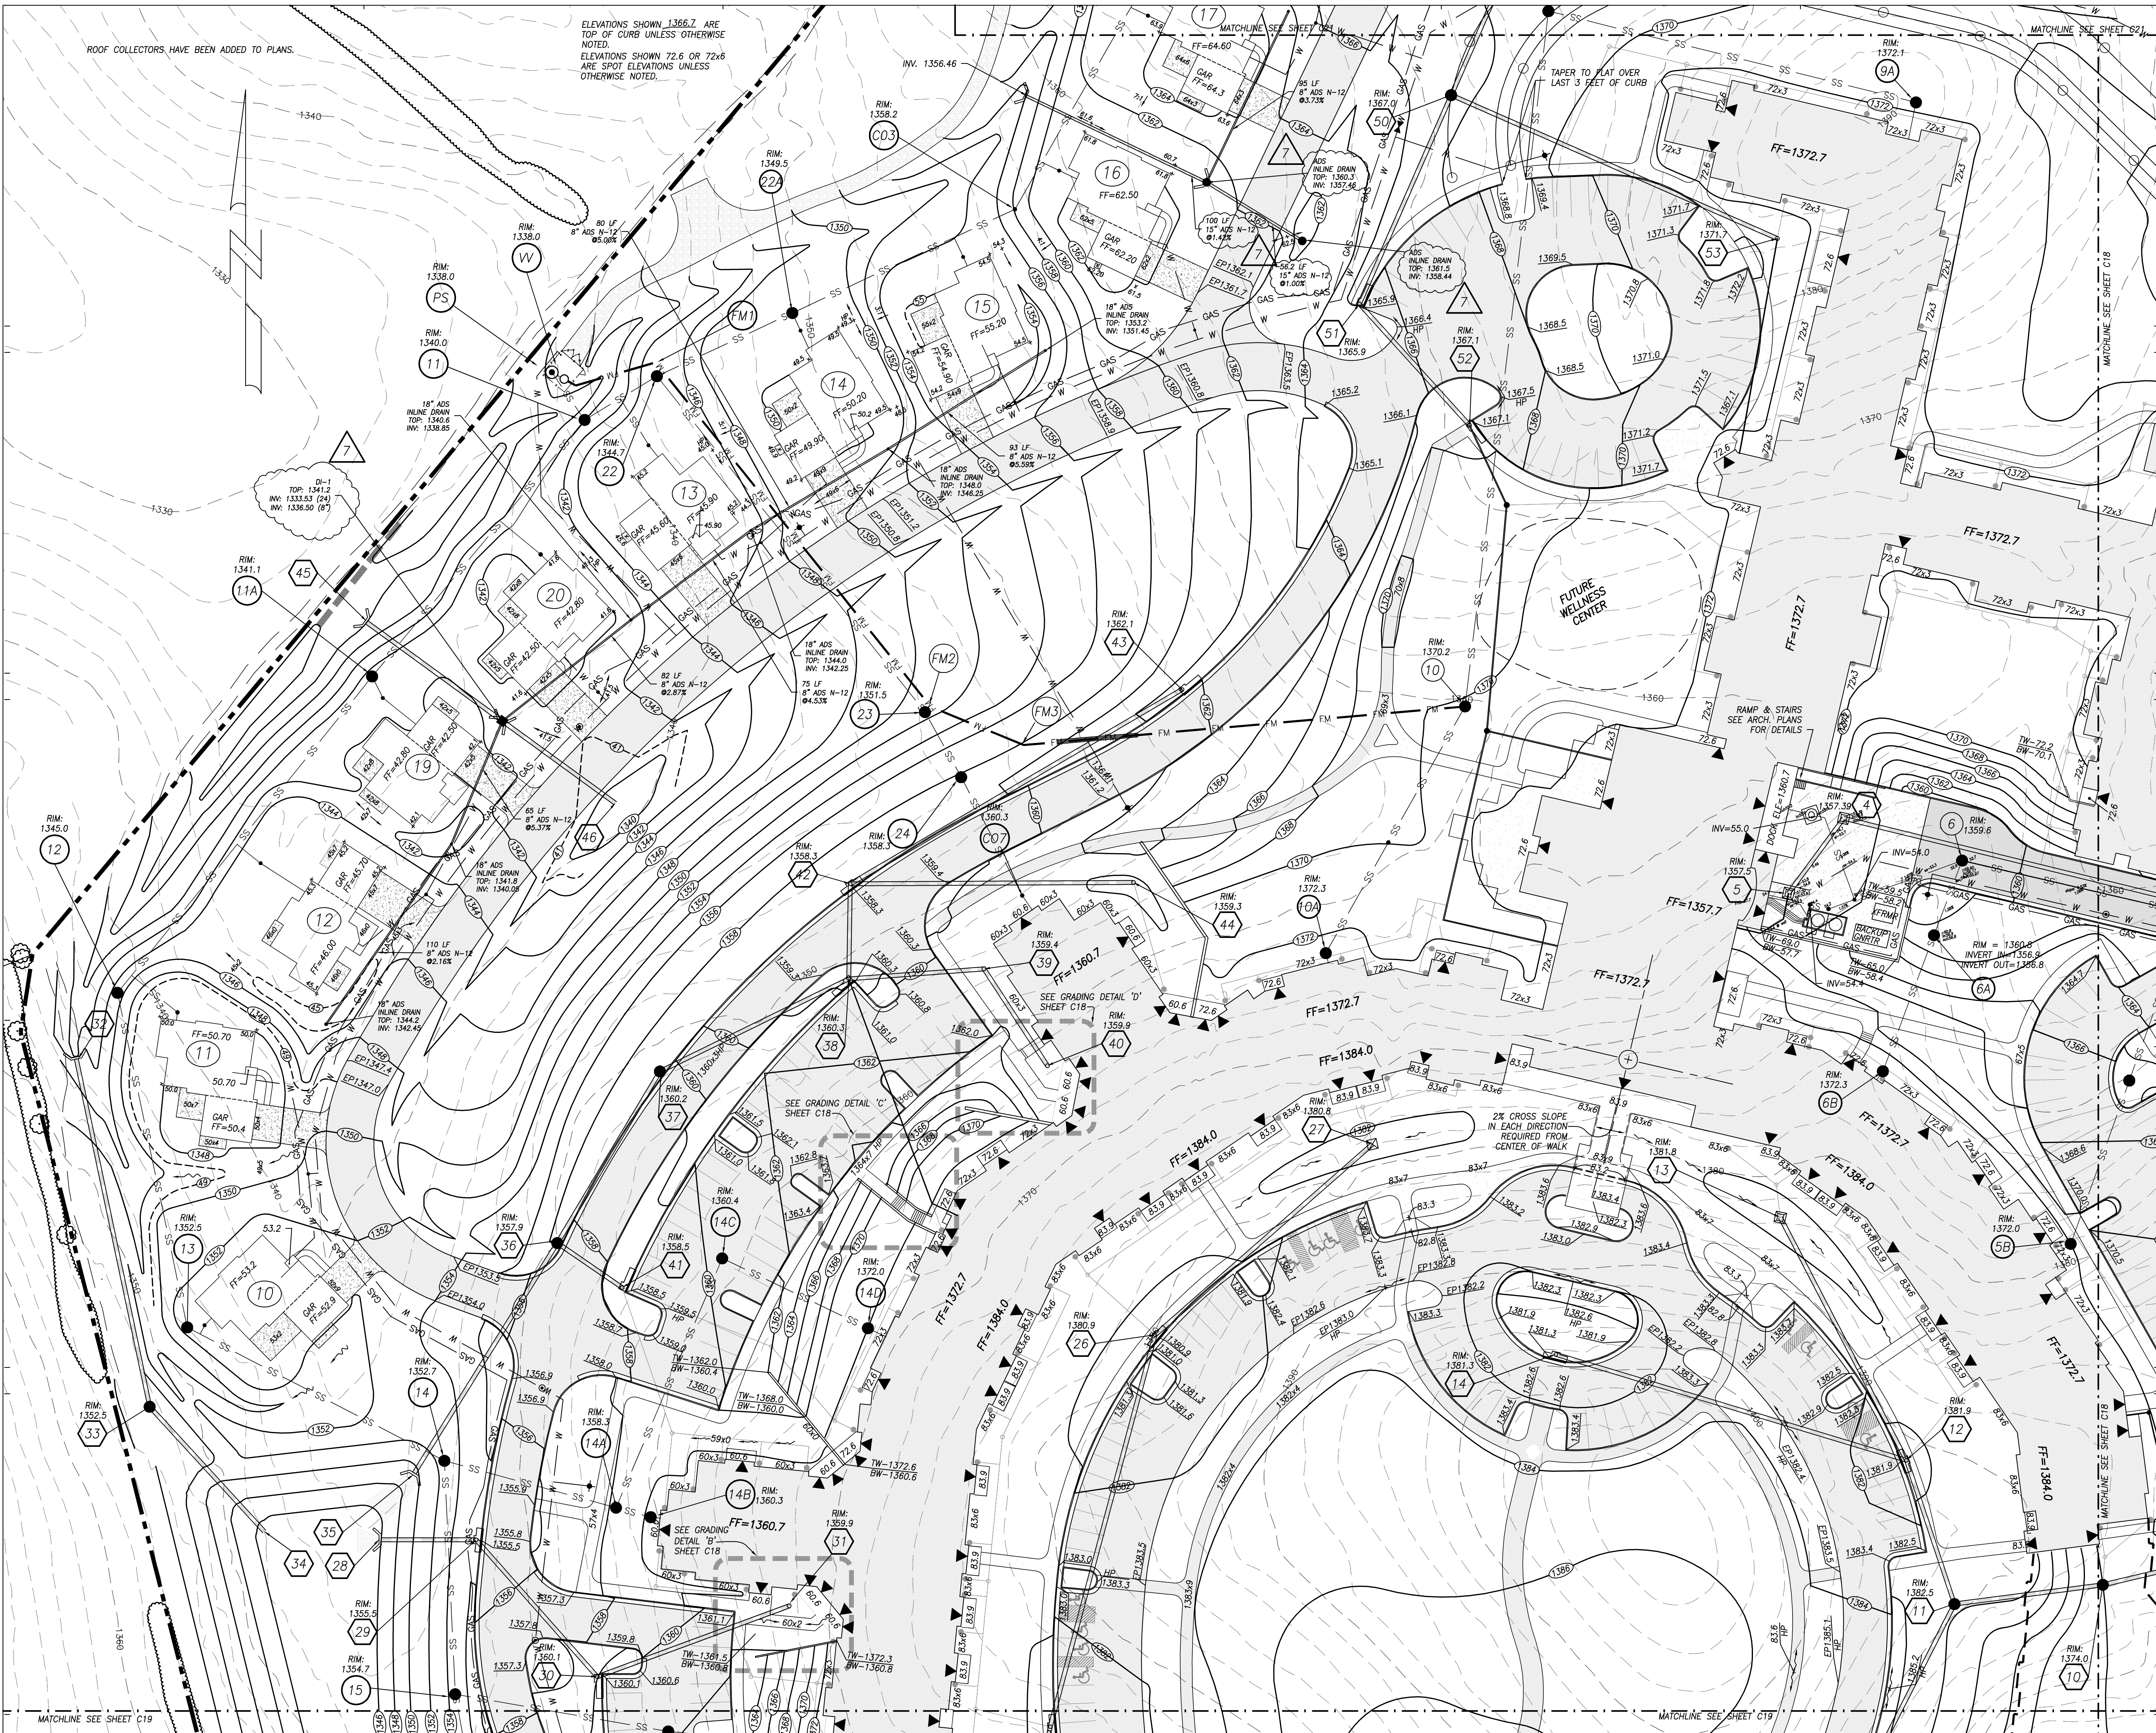

ENGINEERING
 CONCEPTS, INC.
 20 South Roanoke St.
 Fincastle, Virginia 24090
 540.473.1253 540.473.1254(Fax)
 email@engineeringconcepts.com
 ECI PROJECT #02019

GENERAL NOTES

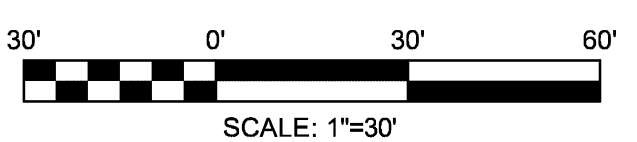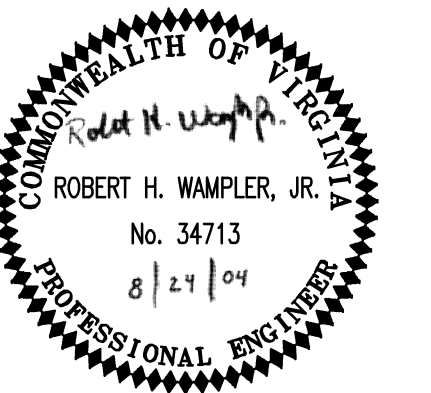

PROJECT TITLE

The Glebe


SFCS Architecture
 Engineering
 Planning
 Interiors
 SFCS Inc. • 305 South Jefferson Street
 Roanoke, Virginia 24011.2003
 540.344.6664 • Fax 540.343.6925
 www.sfcs.com

PROJECT DESIGNER	: SFCS	
PROJECT ARCHITECT	: SFCS	
PROJECT ENGINEER	: ECI	
DRAWN BY	: ECI	
CHECKED BY	: ECI	
APPROVED BY	: ECI	
NO.	REVISION DESCRIPTION	DATE
7	ADS REVISIONS	9/30/04

DRAWING TITLE

GRADING PLAN

COMM. NO.	DATE
DRAWING	SHEET

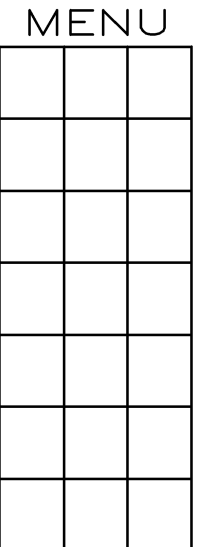

CADD VERSION
 ACADR14
 PLOT SCALE
 1:1
 PLOT DATE
 COMM. NO.
 DRAWING NO.

MATCHLINE SEE SHEET C19

MATCHLINE SEE SHEET C19

MATCHLINE SEE SHEET C18

MATCHLINE SEE SHEET C18