



8" WATER LINE FROM VAULT
 1" = 50' HOR.
 1" = 5' VERT.
 SEE SHEETS C19,C20,C18 AND C24,C25,C23 FOR PLAN VIEW

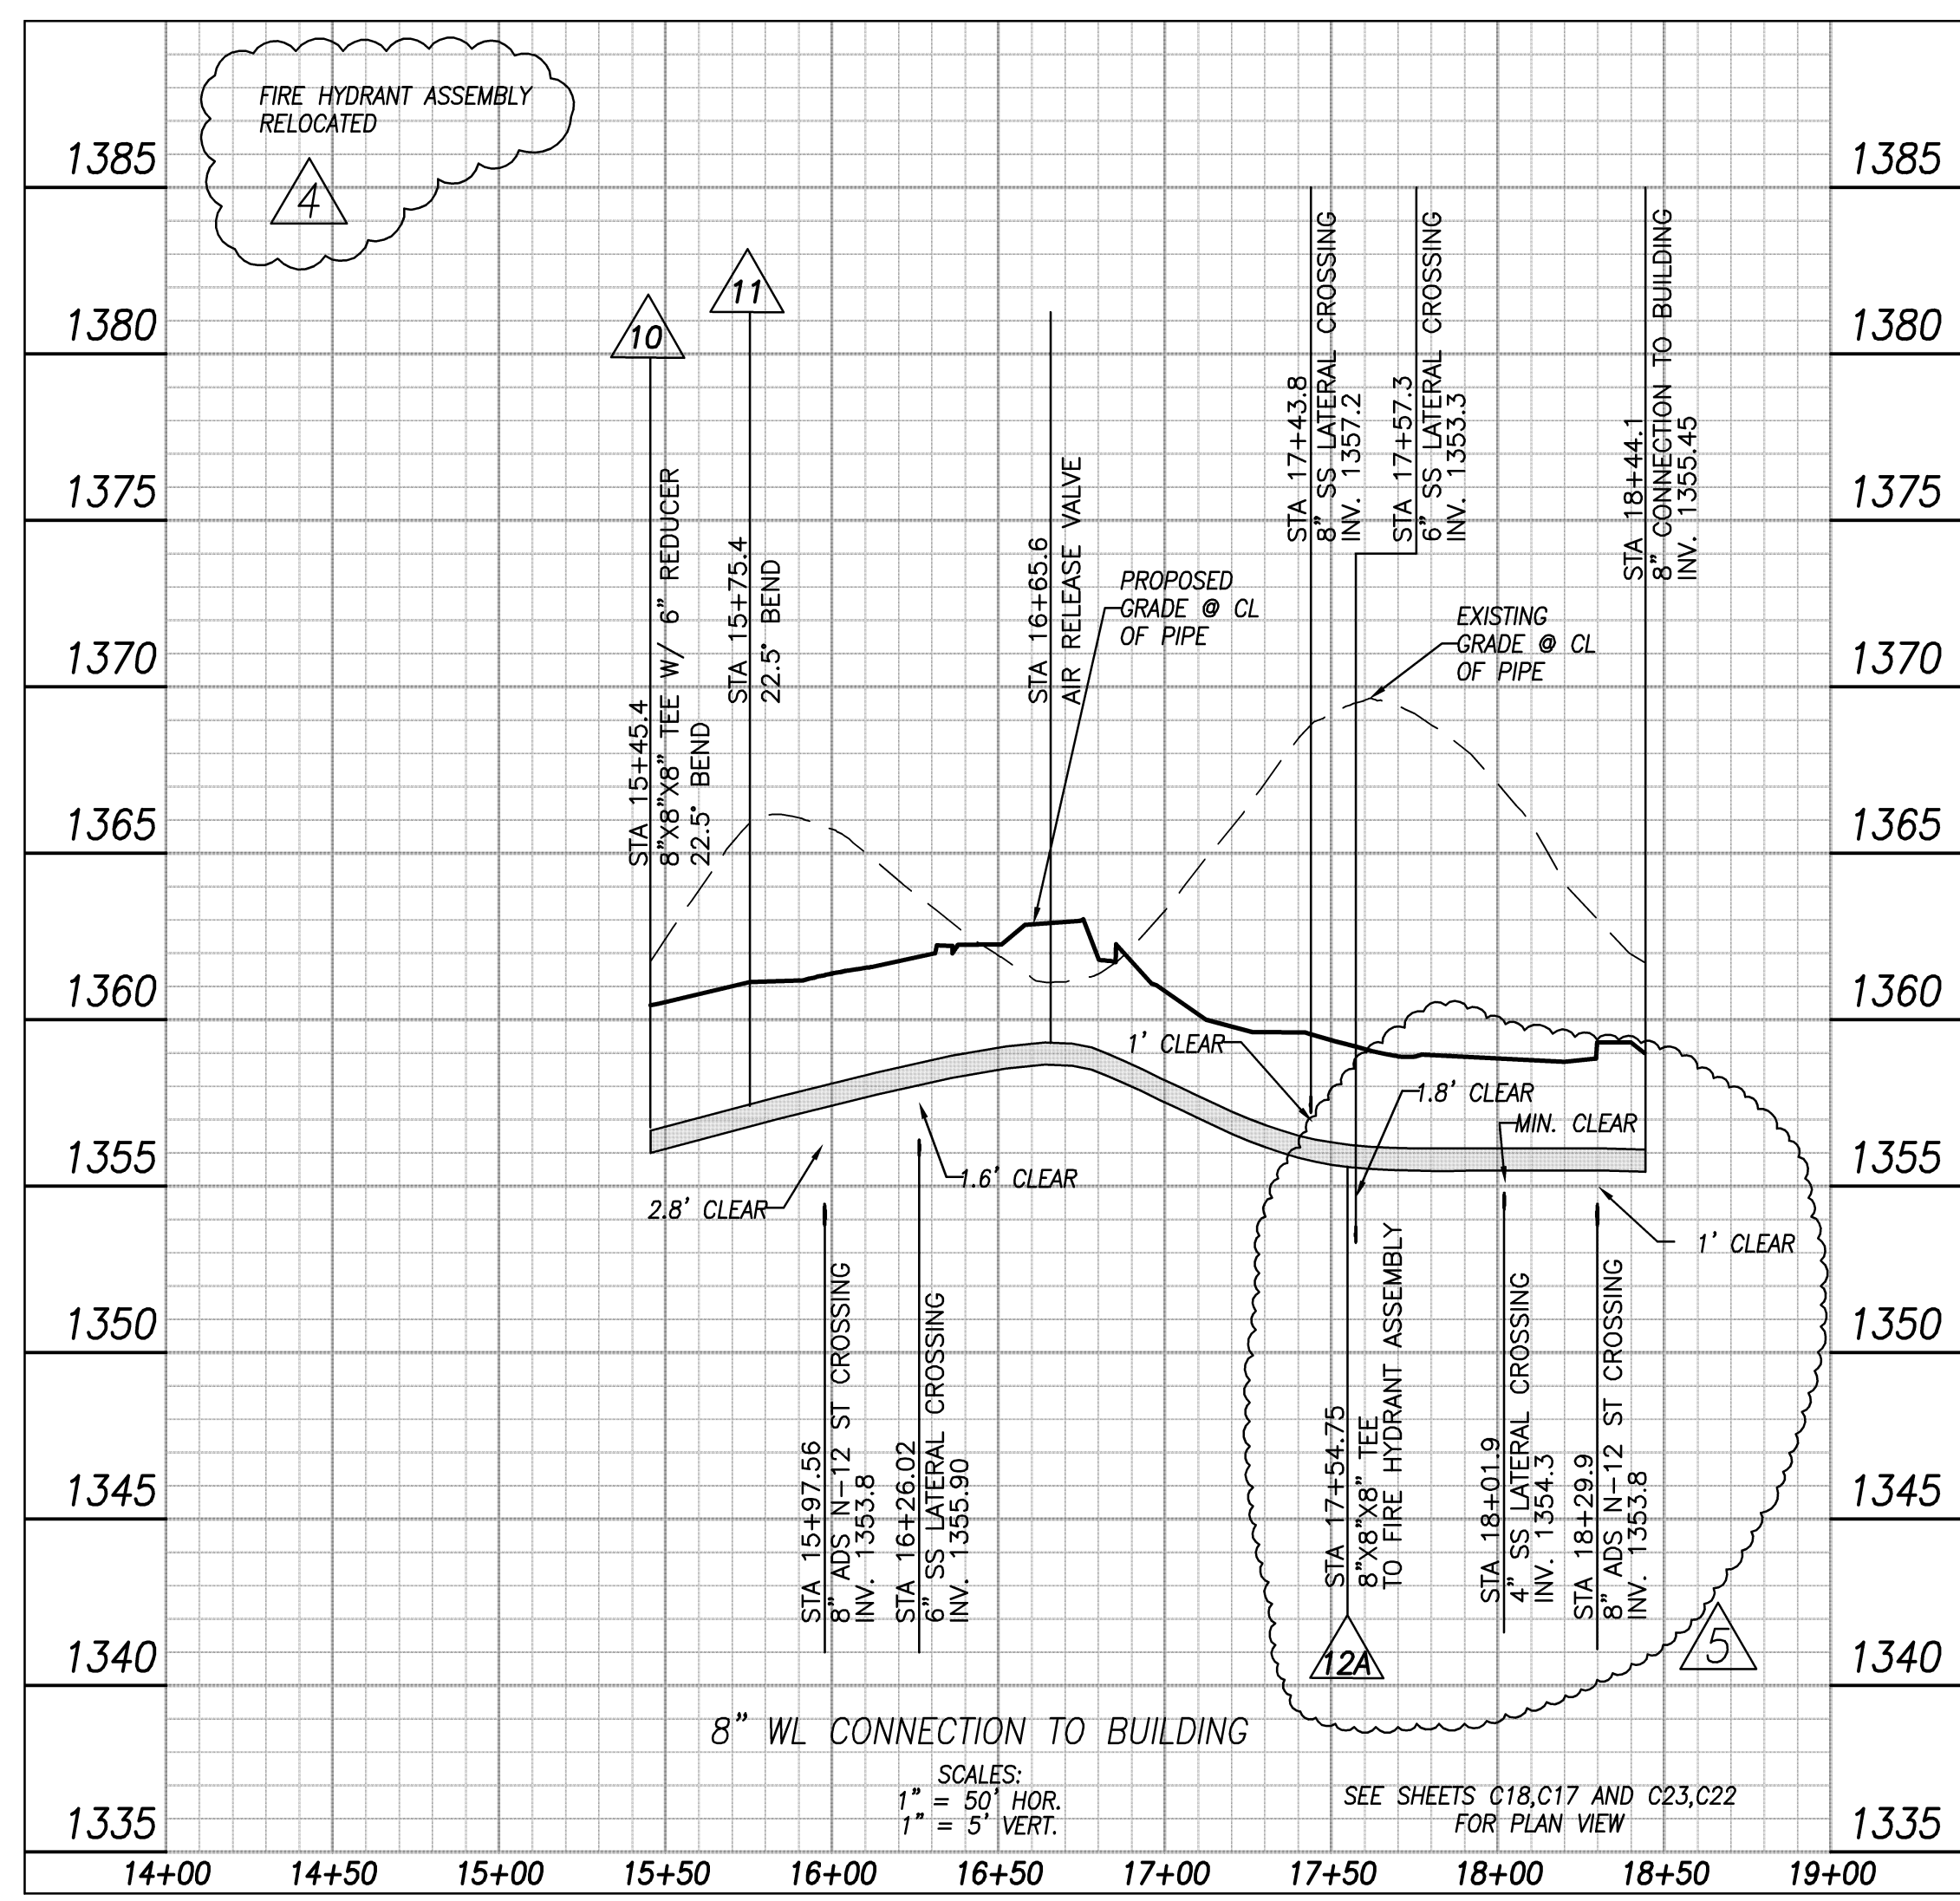

8" WL CONNECTION TO BUILDING
 1" = 50' HOR.
 1" = 5' VERT.
 SEE SHEETS C18,C17 AND C23,C22 FOR PLAN VIEW

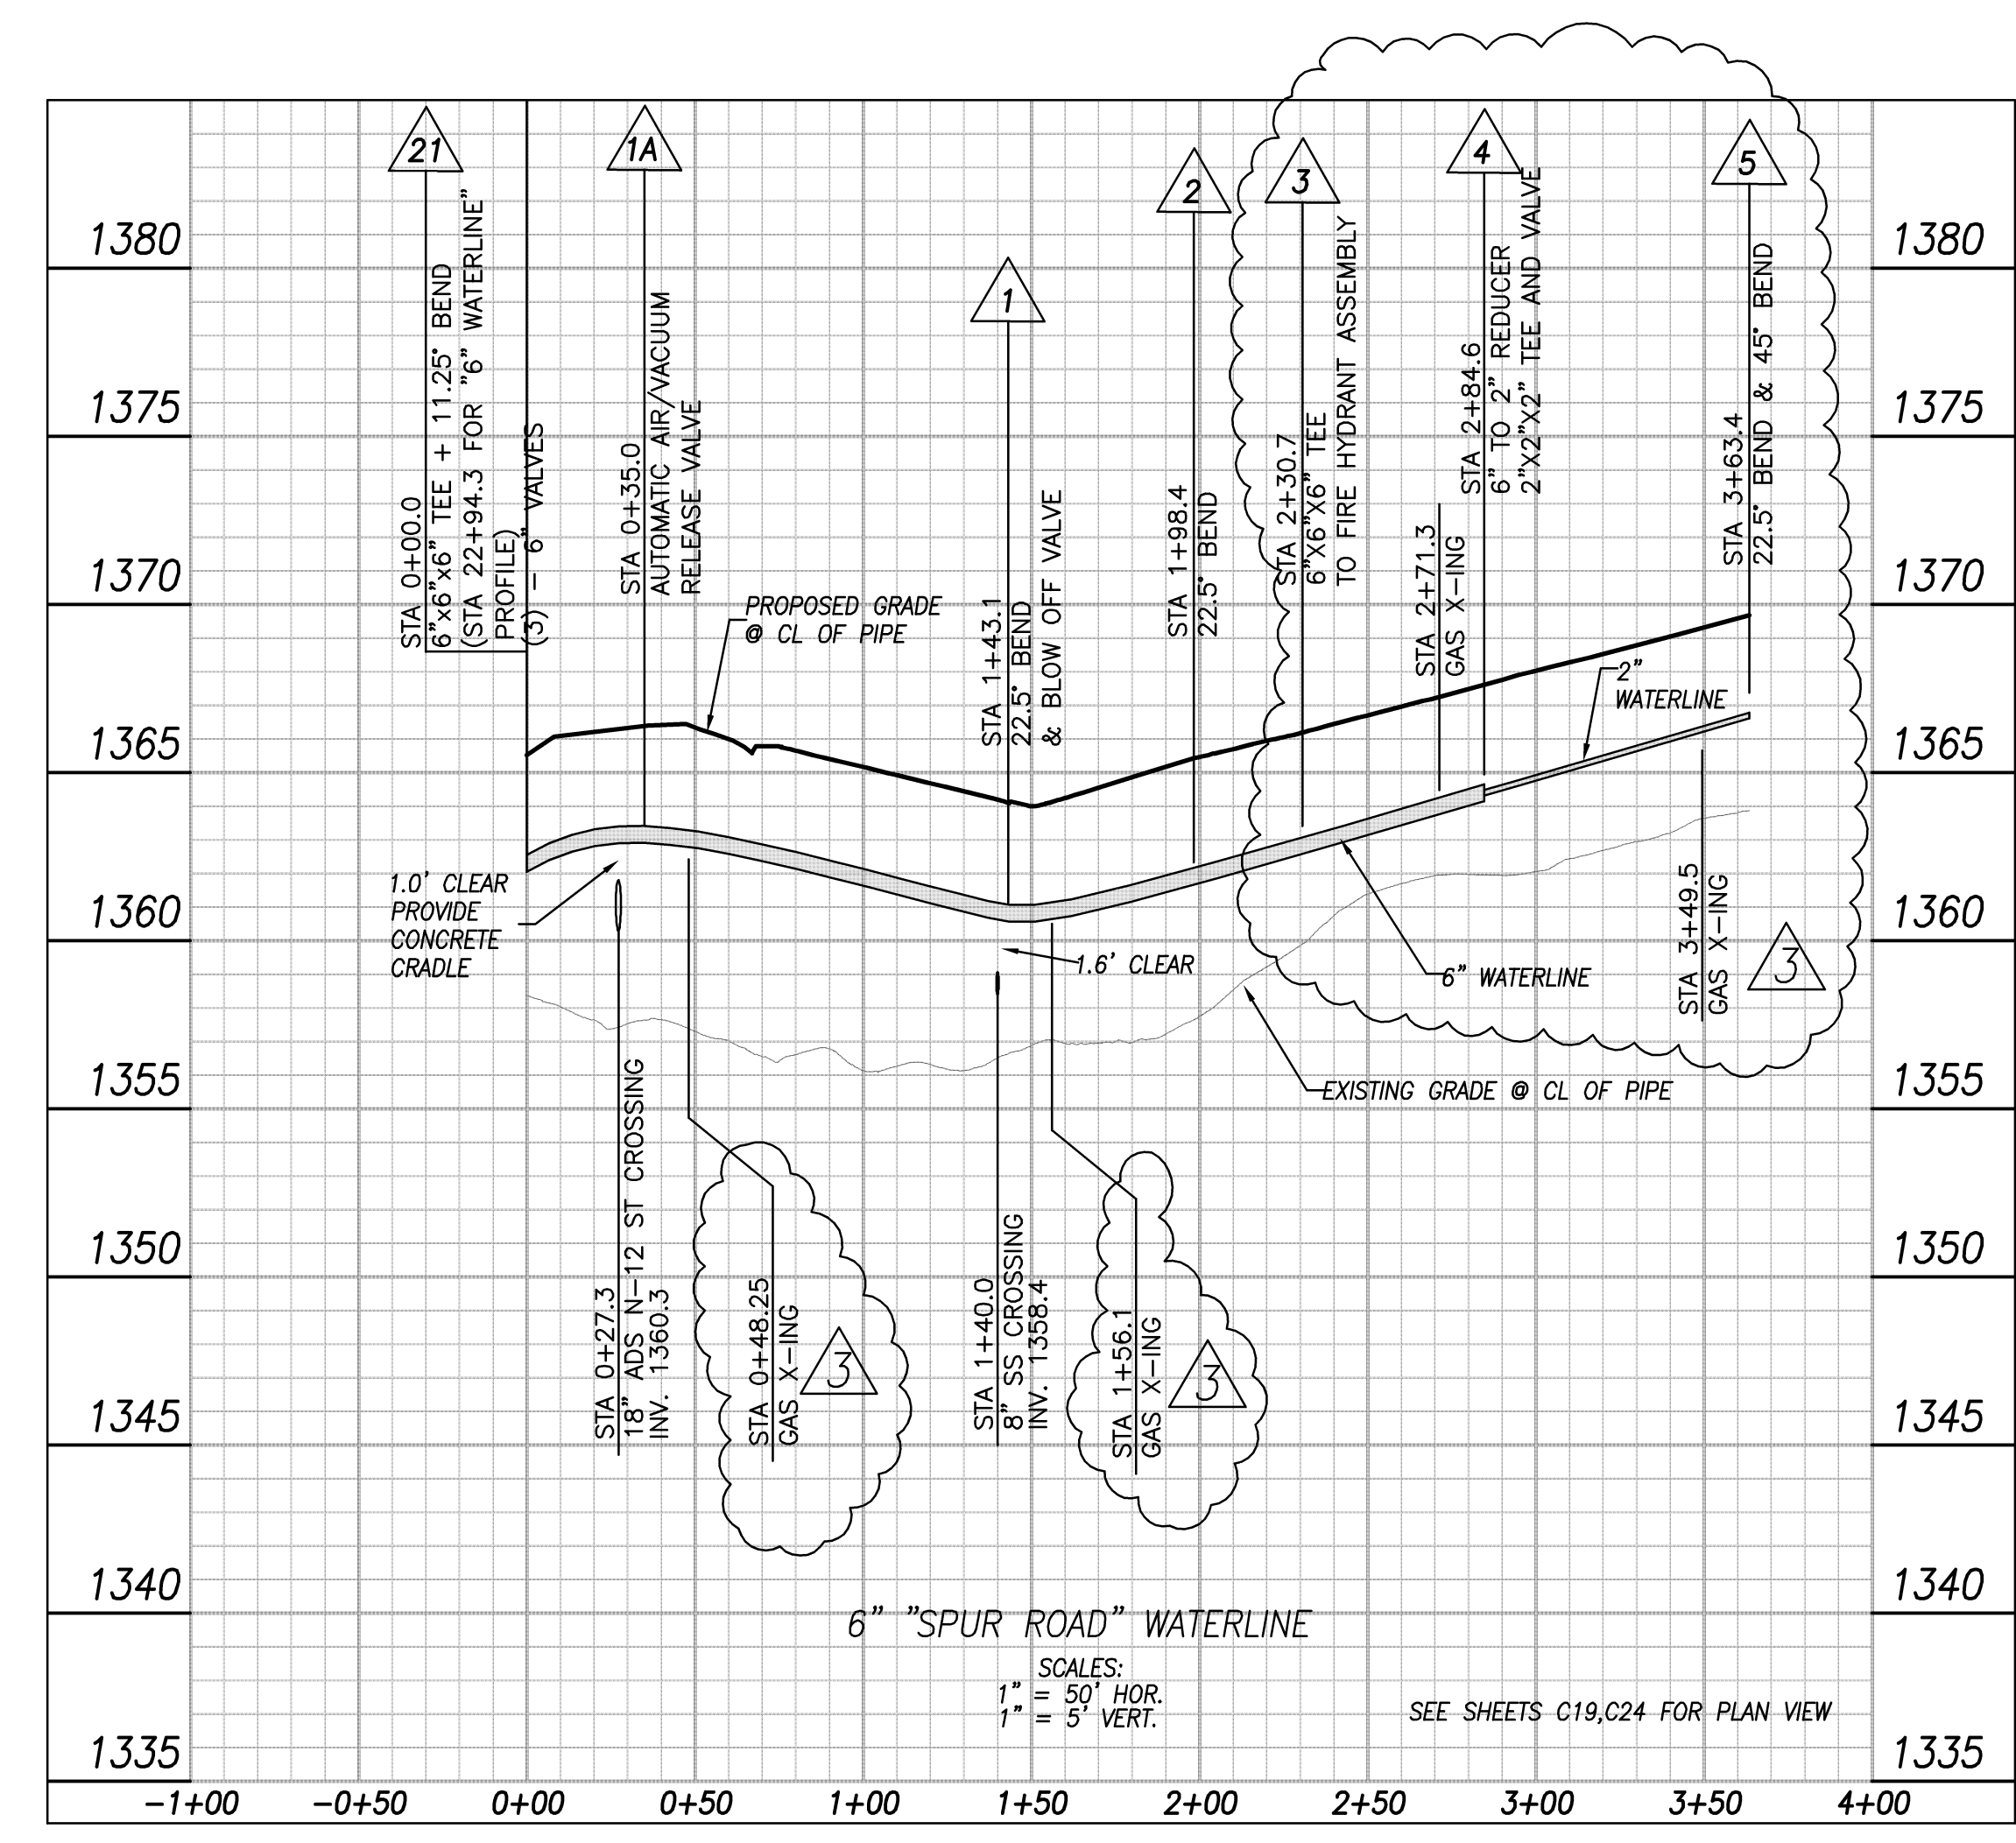

6" "SPUR ROAD" WATERLINE
 1" = 50' HOR.
 1" = 5' VERT.
 SEE SHEETS C19,C24 FOR PLAN VIEW

KEYPLAN

ENGINEERING CONCEPTS, INC.
 20 South Roanoke St.
 Finca, Virginia 24090 540.473.1253
 540.473.1254 (fax)
 email@engineeringconcepts.com
 ECI PROJECT #02019

GENERAL NOTES

SCALE:
 1" = 50' HOR.
 1" = 5' VERT.

PROJECT TITLE

The Glebe

SFCS Architecture
 Engineering
 Interiors

SFCS Inc. • 305 South Jefferson Street
 Roanoke, Virginia 24011.2003
 540.344.6664 • Fax 540.343.6925
 www.sfcs.com

PROJECT DESIGNER	: SFCS	
PROJECT ARCHITECT	: SFCS	
PROJECT ENGINEER	: ECI	
DRAWN BY	: ECI	
CHECKED BY	: ECI	
APPROVED BY	: ECI	
NO.	REVISION DESCRIPTION	DATE
1	VDOT, VDH, BOYD COUNTY COMMENTS	
2	SANITARY SEWER REVISIONS	8/28/03
3	REVISIONS PER BOT CO	11/12/03
4	REVISIONS PER BOT CO	12/11/03
5	MEP COURTYARD REVISIONS	2/11/04

DRAWING TITLE

WATERLINE PROFILES

COMM. NO.	DATE
4715.00	11/2/03
DRAWING	SHEET
C32	32 OF 43

CADD VERSION
 ACADR-14
 PLOT SCALE
 1:1
 PLOT DATE
 COMM. NO.
 DRAWING NO.