

PROJECT: MANAGER Mohammad Zaid, PE (540) 387-5374 (Salem)
SURVEYED BY Richard Ziemann, L.S. (703) 631-5325 (Burgess & Niple)
DESIGN SUPERVISED BY J. Scott Hodge, PE (540) 857-3322 (AECOM)
DESIGNED BY Craig Riddle, PE (540) 857-3369 (AECOM)

UTILITY OWNERSHIP LIST

ELECTRIC

APPALACHIAN POWER COMPANY
803 RIVER AVENUE, S.E.
ROANOKE, VA 24022

CONTACT: DAVID KEITH
PHONE: (540) 427-3616

GAS

ROANOKE GAS COMPANY
519 KIMBALL AVENUE, N.E.
P.O. BOX 13007
ROANOKE, VA 24030

CONTACT: THOMAS "PETE" ORR, II
PHONE: (540) 777-3874
CELL: (540) 400-1013
E-MAIL: pete.orr@roanokegas.com

WATER (TROUTVILLE)

TOWN OF TROUTVILLE
5419 LEE HIGHWAY
P.O. BOX 279
TROUTVILLE, VA 24175

CONTACT: SCOTT PADERICK
PHONE: (540) 992-4401
FAX: (540) 992-1183

WATER (BCW)

BOTETOURT COUNTY
30 WEST BUCK STREET
FINCASTLE, VA 24090

CONTACT: KEVIN SHEARER
PHONE: (540) 473-8316
E-MAIL: kshearer@botetourt.org

TELEPHONE/FIBER OPTIC

NTELOS
1900 ROANOKE ROAD
DALEVILLE, VA 24093

CONTACT: CAROL F. THEIMER
PHONE: (540) 591-5430
CELL: (540) 206-4938
FAX: (540) 992-1000
E-MAIL: theimer@ntelos.com

TELEVISION/FIBER OPTIC

COMCAST
1415 SOUTH MAIN STREET
BLACKSBURG, VA 24060

CONTACT: JOSEPH C. AUSTIN, III
PHONE: (540) 717-4600
E-MAIL: joseph.austiniii@cable.comcast.com

FIBER OPTIC


MID-ATLANTIC BROADBAND
COOPERATION

CONTACT: DOUG HERRIN
PHONE: 570-1310
CELL: (434) 446-3870

FIBER OPTIC

VERIZON


CONTACT: ALAN ASBURY
PHONE: (540) 563-8341
E-MAIL: roscoe.a.asbury@verizon.com

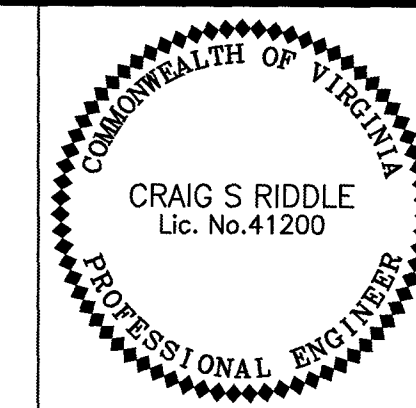

Craig S. Riddle
2014.07.17 09:27:13 -04'00'
AECOM TECH. SERV., INC.
ROANOKE, VIRGINIA
UTILITY ENGINEER

REVISED	STATE	ROUTE	STATE	PROJECT	SHEET NO.
	VA.	11		0081-011-120, PE-102 RW-202, C-502	18(3)

DESIGN FEATURES RELATING TO CONSTRUCTION
OR TO REGULATION AND CONTROL OF TRAFFIC
MAY BE SUBJECT TO CHANGE AS DEEMED
NECESSARY BY THE DEPARTMENT

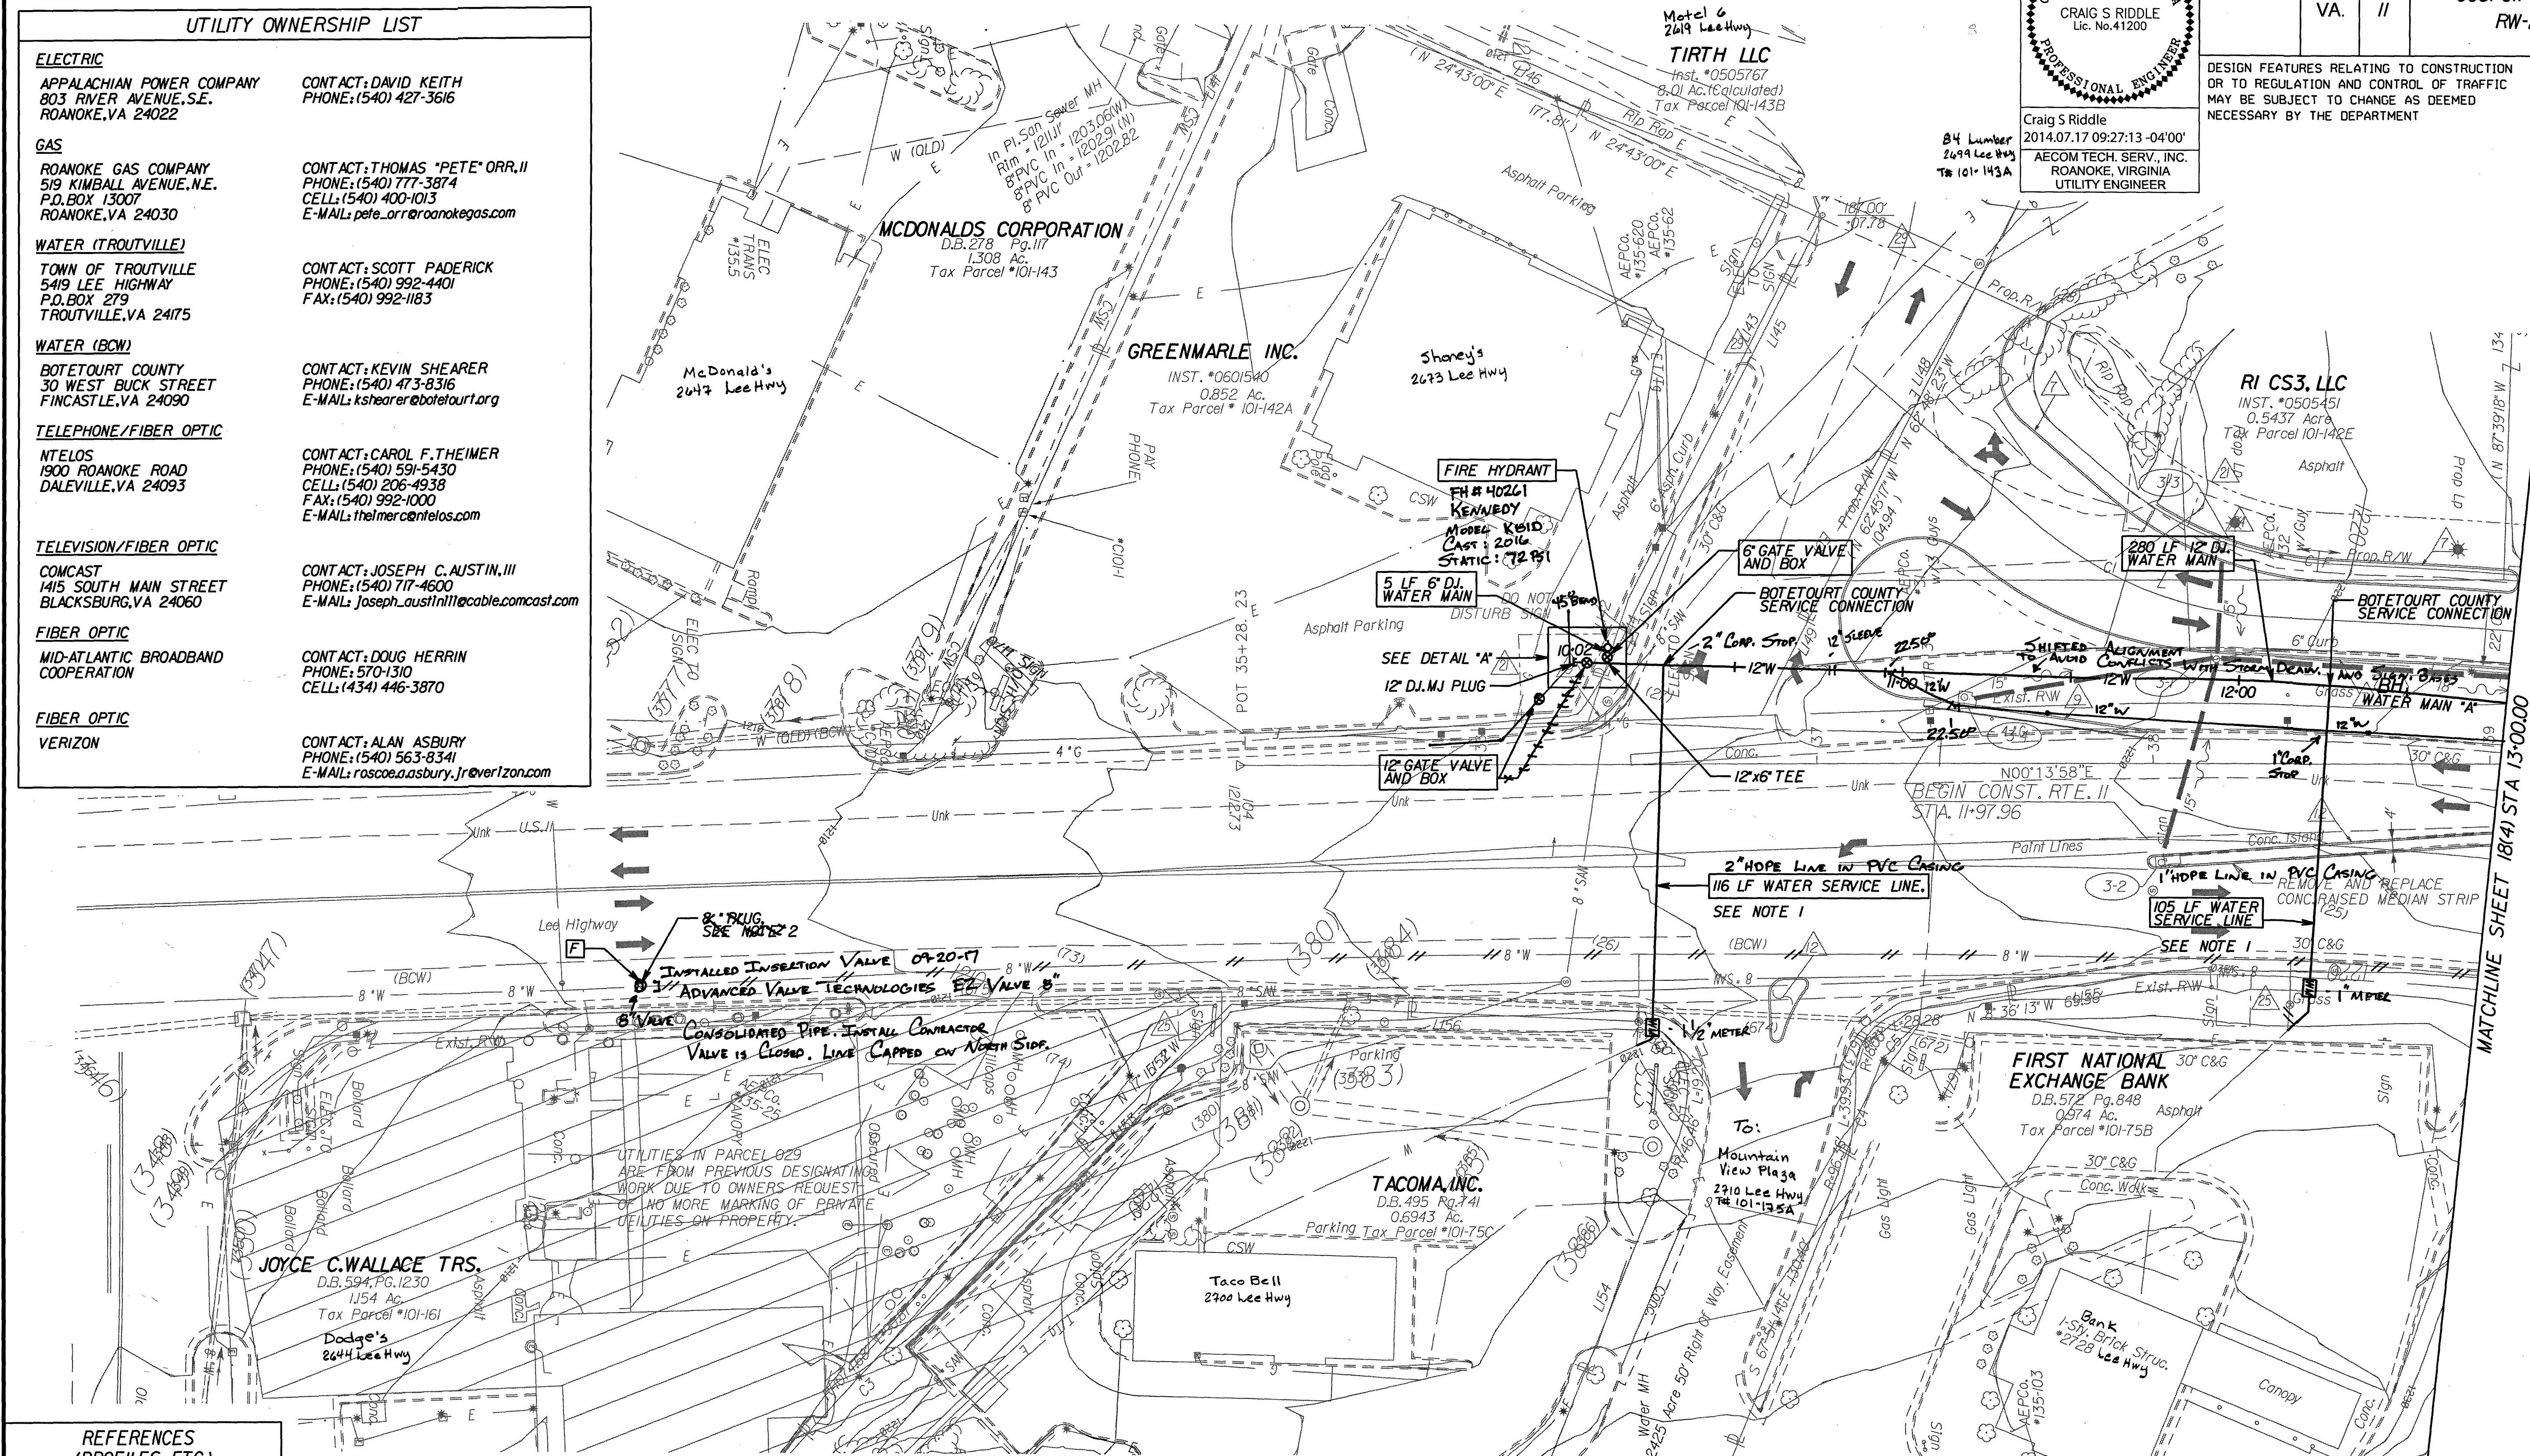

REFERENCES (PROFILES ETC.)

WATER MAIN
PROFILE 18(3A)

LEGEND:

- [F] CONSTRUCTION POINT, SEE SEQUENCE OF CONSTRUCTION SHEET 18A
- [W] BOTETOURT COUNTY WATER METER AND PRV
- UTILITY TO BE ABANDONED


NOTES:

1. INSTALL SERVICE LINE TO MATCH EXISTING SERVICE LINE DIAMETER BY TRENCHLESS METHOD ACROSS ROUTE 11. INSTALL BOTETOURT COUNTY WATER METER AND PRV AT APPROXIMATE LOCATION INDICATED WITHIN RIGHT OF WAY. PROVIDE SUITABLE PRESSURE RATED FITTING TO CONNECT PROPOSED SERVICE LINE TO EXISTING SERVICE LINE AT INDICATED LOCATION. CLOSE EXISTING SERVICE VALVE AND CUT THE EXISTING SERVICE LINE AS REQUIRED TO MAKE CONNECTION. ENSURE EXISTING SERVICE LINE TO REMAIN IS UNDAMAGED AND SUITABLE FOR CONNECTION.
2. CONTRACTOR SHALL COORDINATE WITH BOTETOURT COUNTY TO DEPRESSURIZE EXISTING 8-INCH WATER MAIN CUT AND PLUG LINE AS INDICATED. SEE SEQUENCE OF CONSTRUCTION ON SHEET 18A. RESTORE PAVEMENT TO ORIGINAL CONDITION AND CONFORMING TO VDOT REQUIREMENTS. COST INCLUDED IN OTHER ITEMS. NO ADDITIONAL COMPENSATION WILL BE PROVIDED. CONFORM TO VA W.A.M.P. REQUIREMENTS FOR WORK.

MATERIAL WATERLINE

- AMERICAN CHASS 350 D.I.P. 12" x 6"
- KENNEDY 12" x 6" GATE VALVES
- KENNEDY FIRE HYDRANT K81D
- ENDOT 2" x 1" HDPE SERVICE LINES

RI CS3, LLC
INST. #0505451
0.3825 Acre
Tax Parcel 101-142C

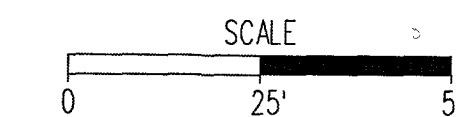

PROJECT	SHEET NO.
0081-011-120	18(3)