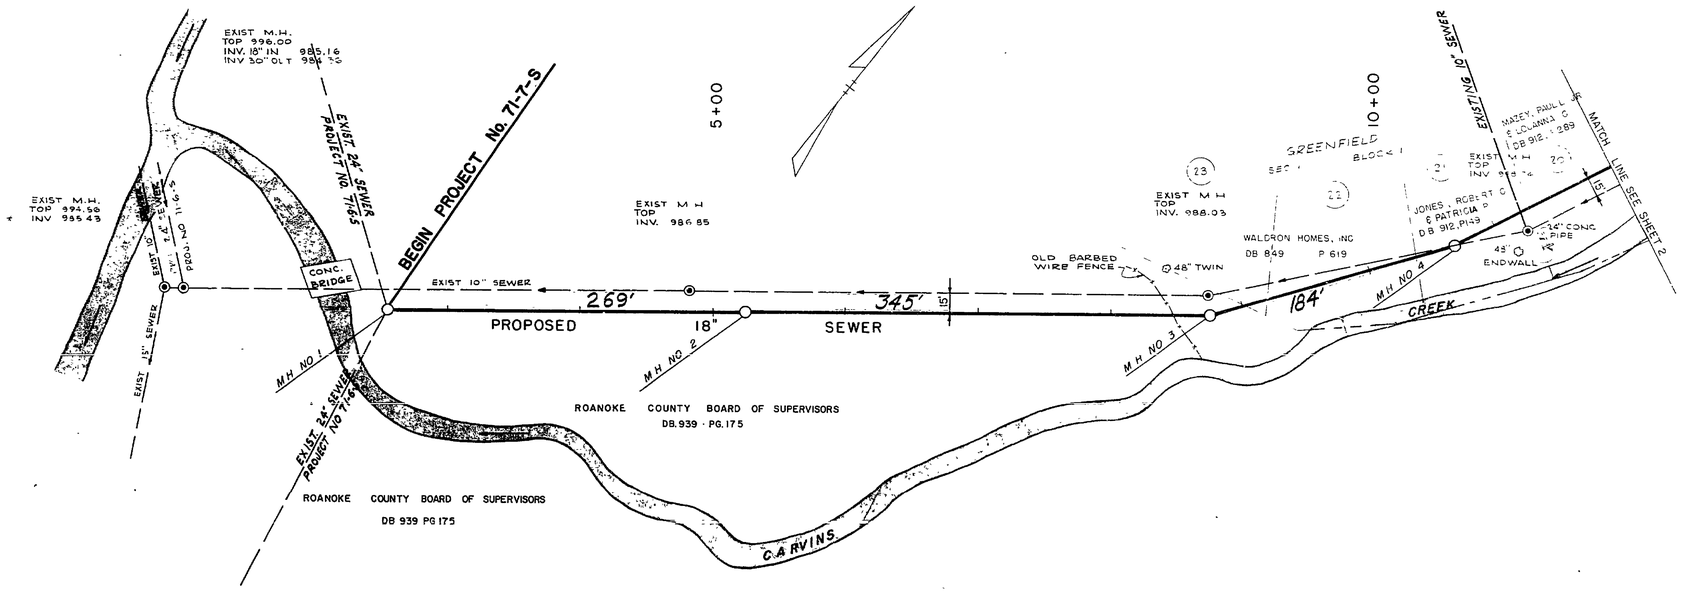

AS BUILT

SCALE: 1 IN. = 50 FT

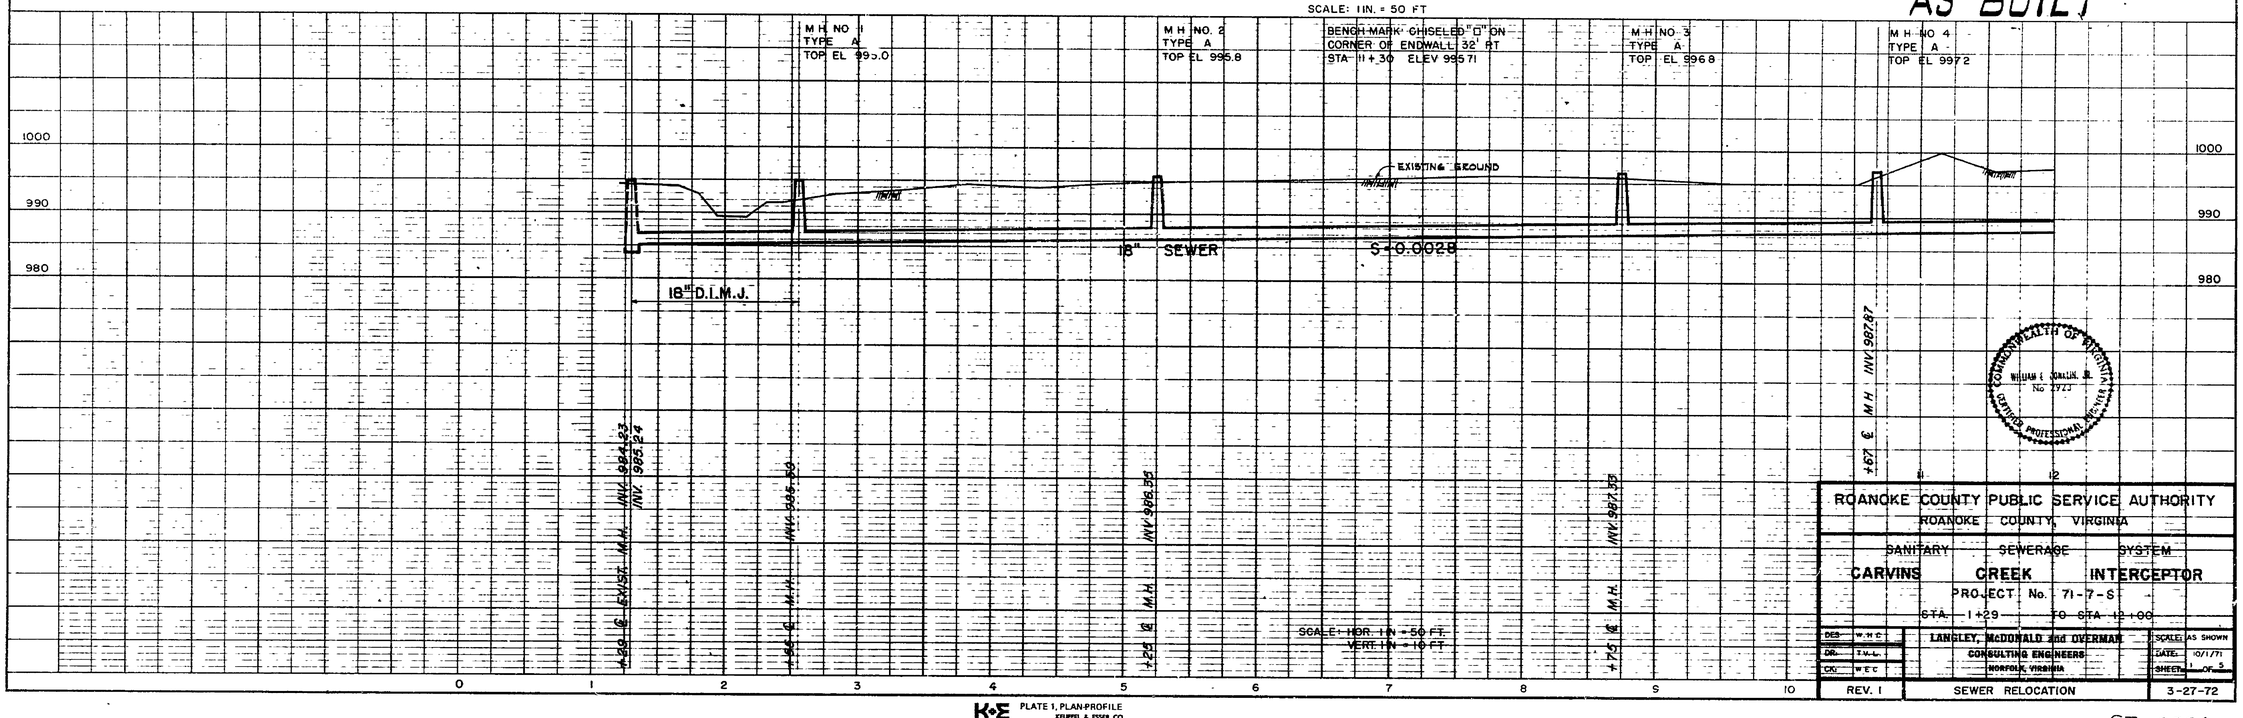

SCALE: HOR. 1 IN = 50 FT.
VERT. 1 IN = 10 FT

COMMONWEALTH OF VIRGINIA
WILLIAM E. CONKLIN, JR.
No. 2923
CERTIFIED PROFESSIONAL ENGINEER

ROANOKE COUNTY PUBLIC SERVICE AUTHORITY
ROANOKE COUNTY, VIRGINIA
SANITARY SEWERAGE SYSTEM
CARVINS CREEK INTERCEPTOR
PROJECT No. 71-7-S
STA. 1+29 TO STA. 12+00

DES.	W.H.C.	LANGLEY, McDONALD and OVERMAN CONSULTING ENGINEERS NORFOLK, VIRGINIA	SCALE: AS SHOWN
DR.	T.W.L.		DATE: 10/1/71
CK.	W.E.C.		SHEET 1 OF 5
REV. 1		SEWER RELOCATION	3-27-72

PLATE 1, PLAN-PROFILE
KEUFFEL & ESSER CO.
48 7008 MADE IN U.S.A.

SI-0326
3427