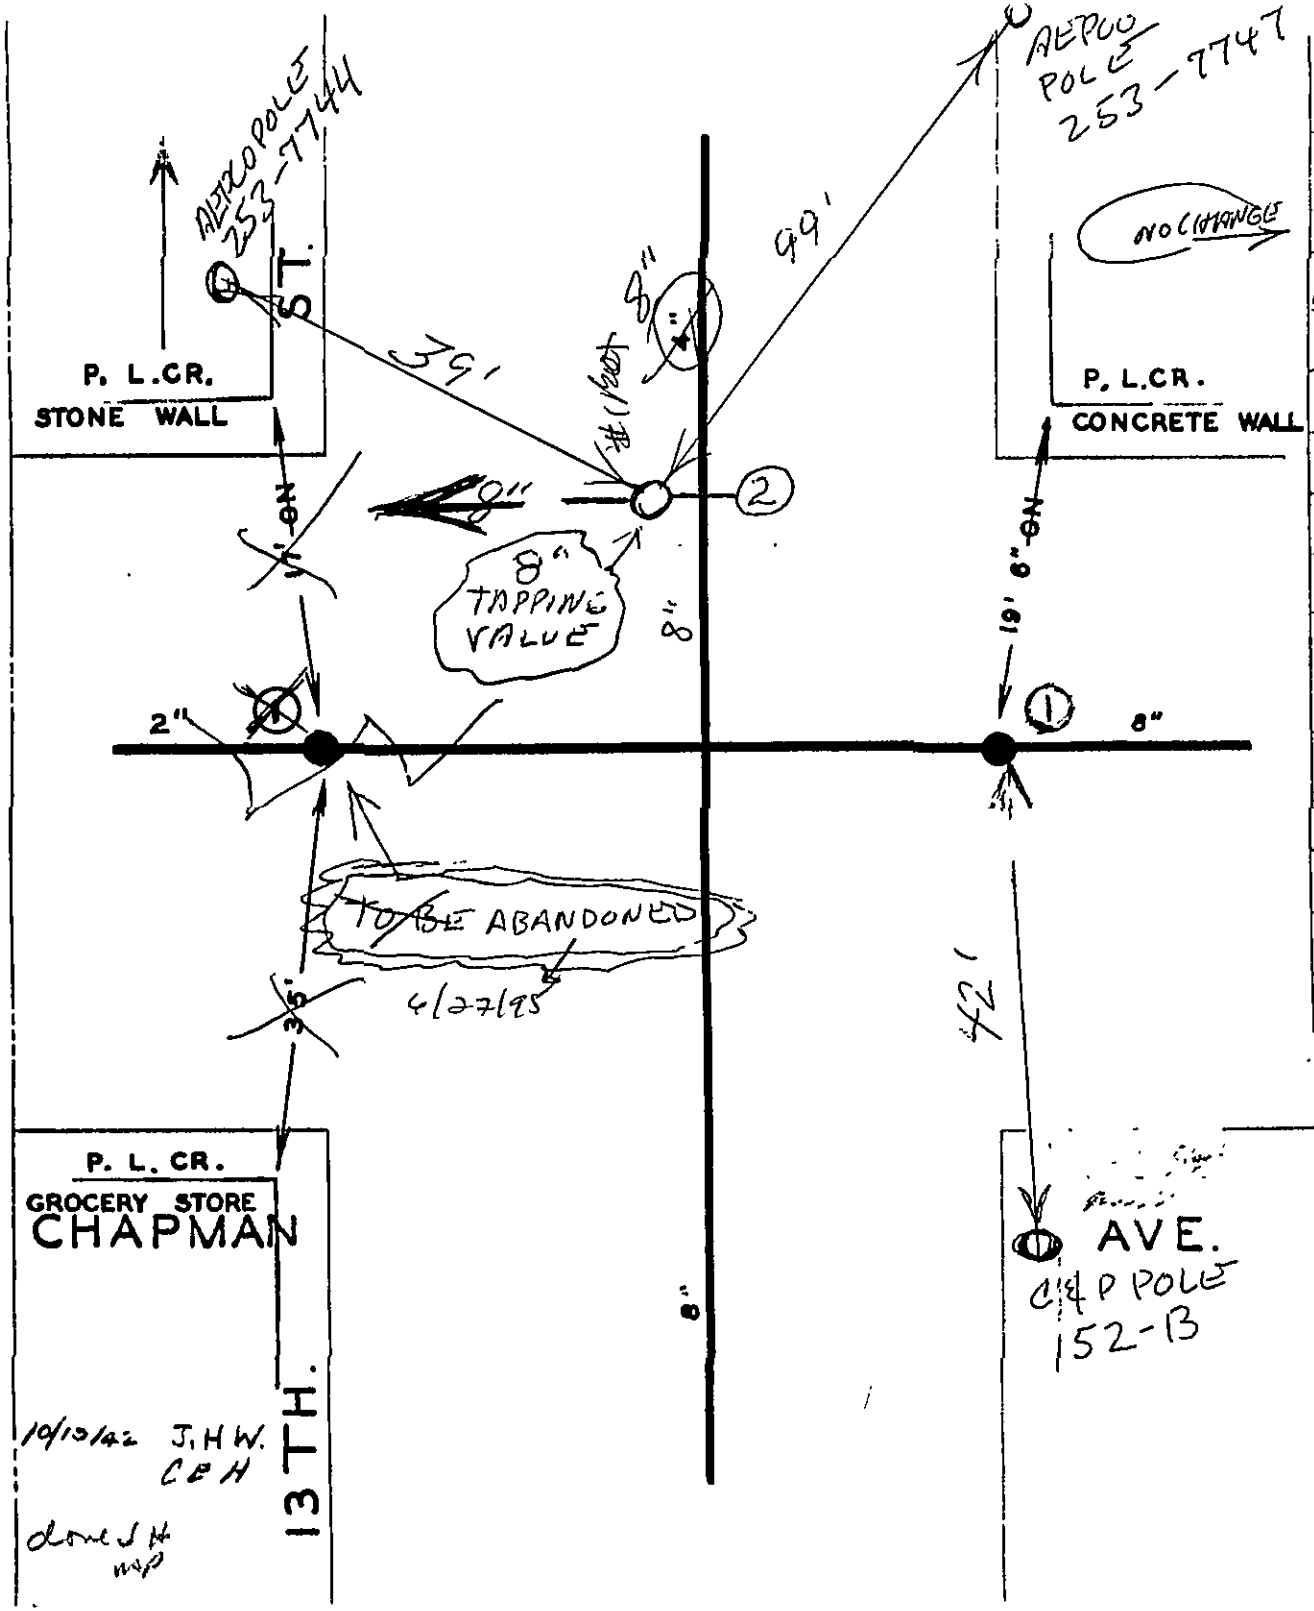

DATE	NO	SIZE	MAKE	OPEN	TURN
1893	1	2"		R	7
1892	1	8"	"GOOD"	R	27
1995	2	8"	MUELLER	R	27
	2	0	EPL		

CITY OF ROANOKE—WATER DEP'T
VALVE DIAGRAM
CHAPMAN AVE & 13TH ST. S. W.

SEC MAP 121
DATE
PAGE NO SW 185