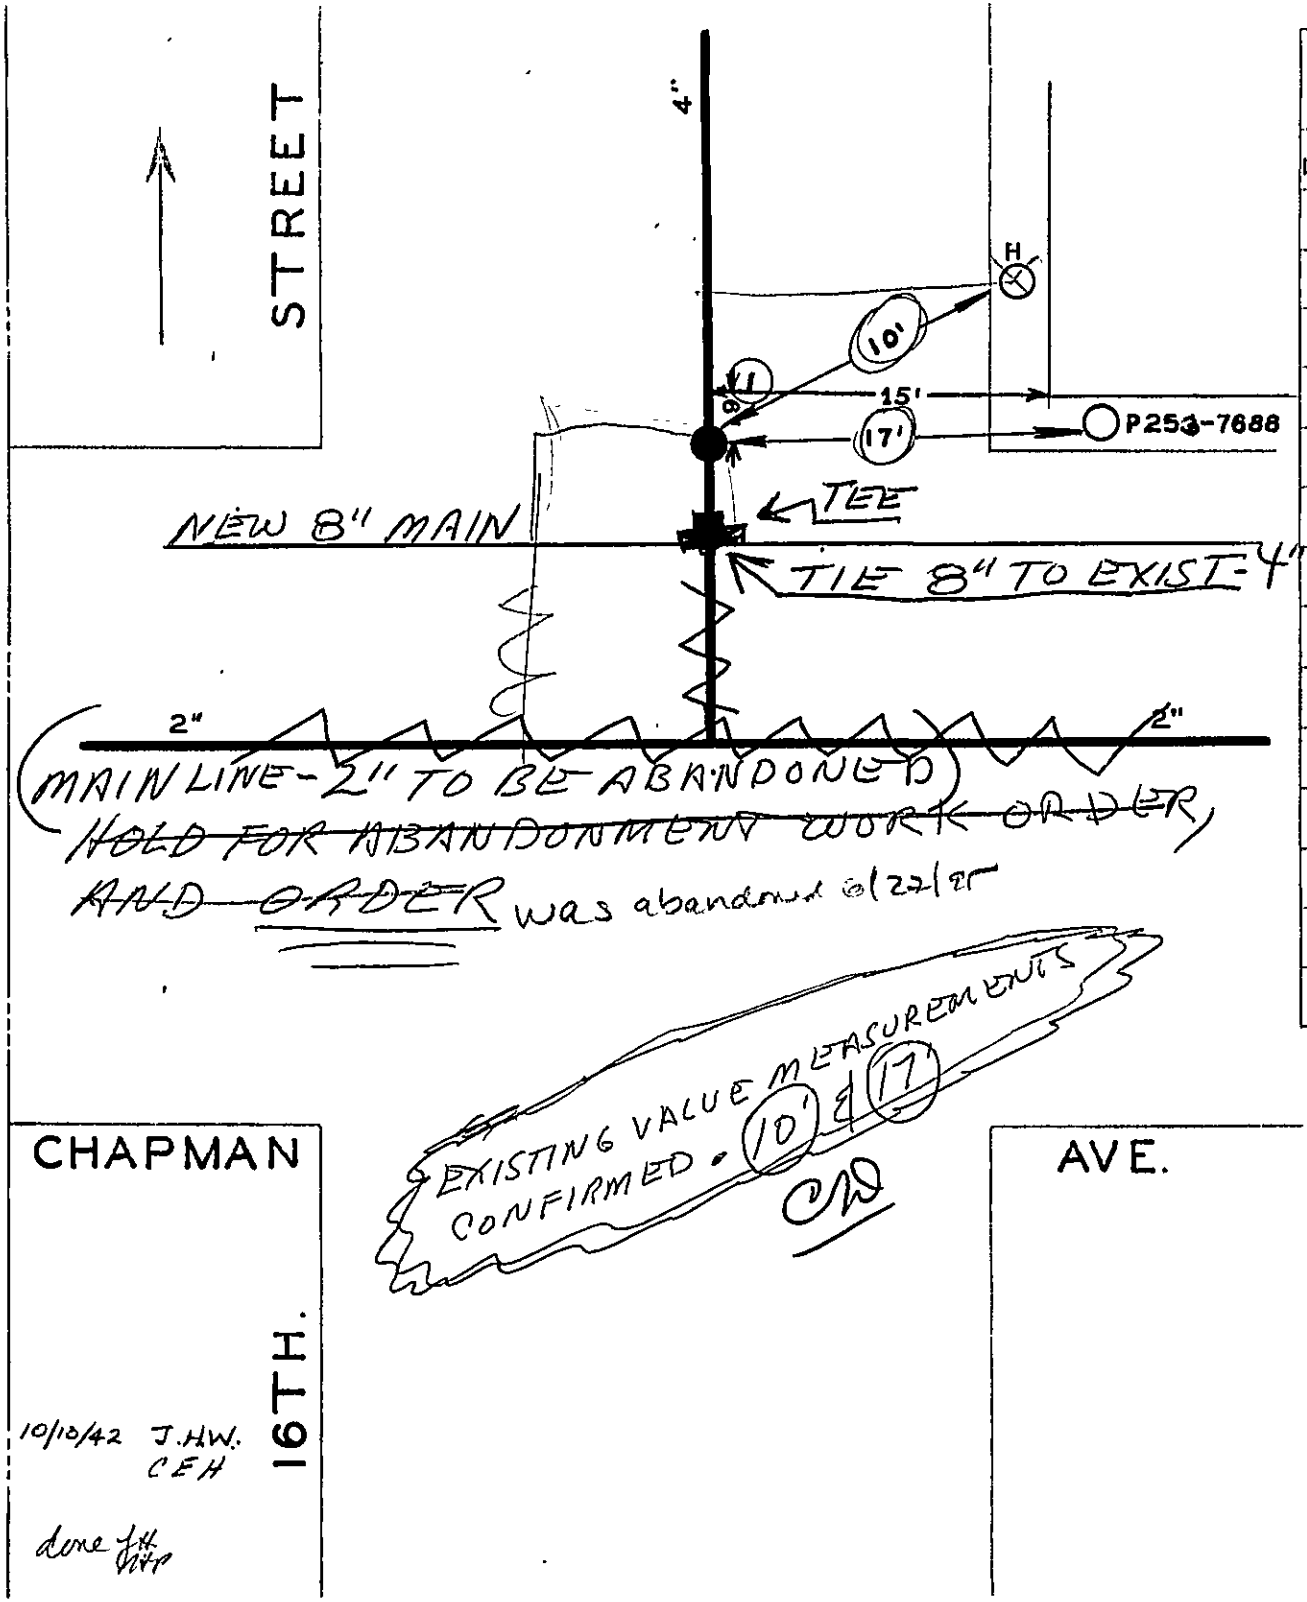

DATE	NO.	SIZE	MAKE	OPEN	TURNS
1906	1	4"		R	8 1/2
	1	6'-S	NPL		

CITY OF ROANOKE—WATER DEP'T
VALVE DIAGRAM
CHAPMAN AVE. & 16TH.
ST. S.W.

SEC. MAP 121
DATE
PAGE NO S.W.187