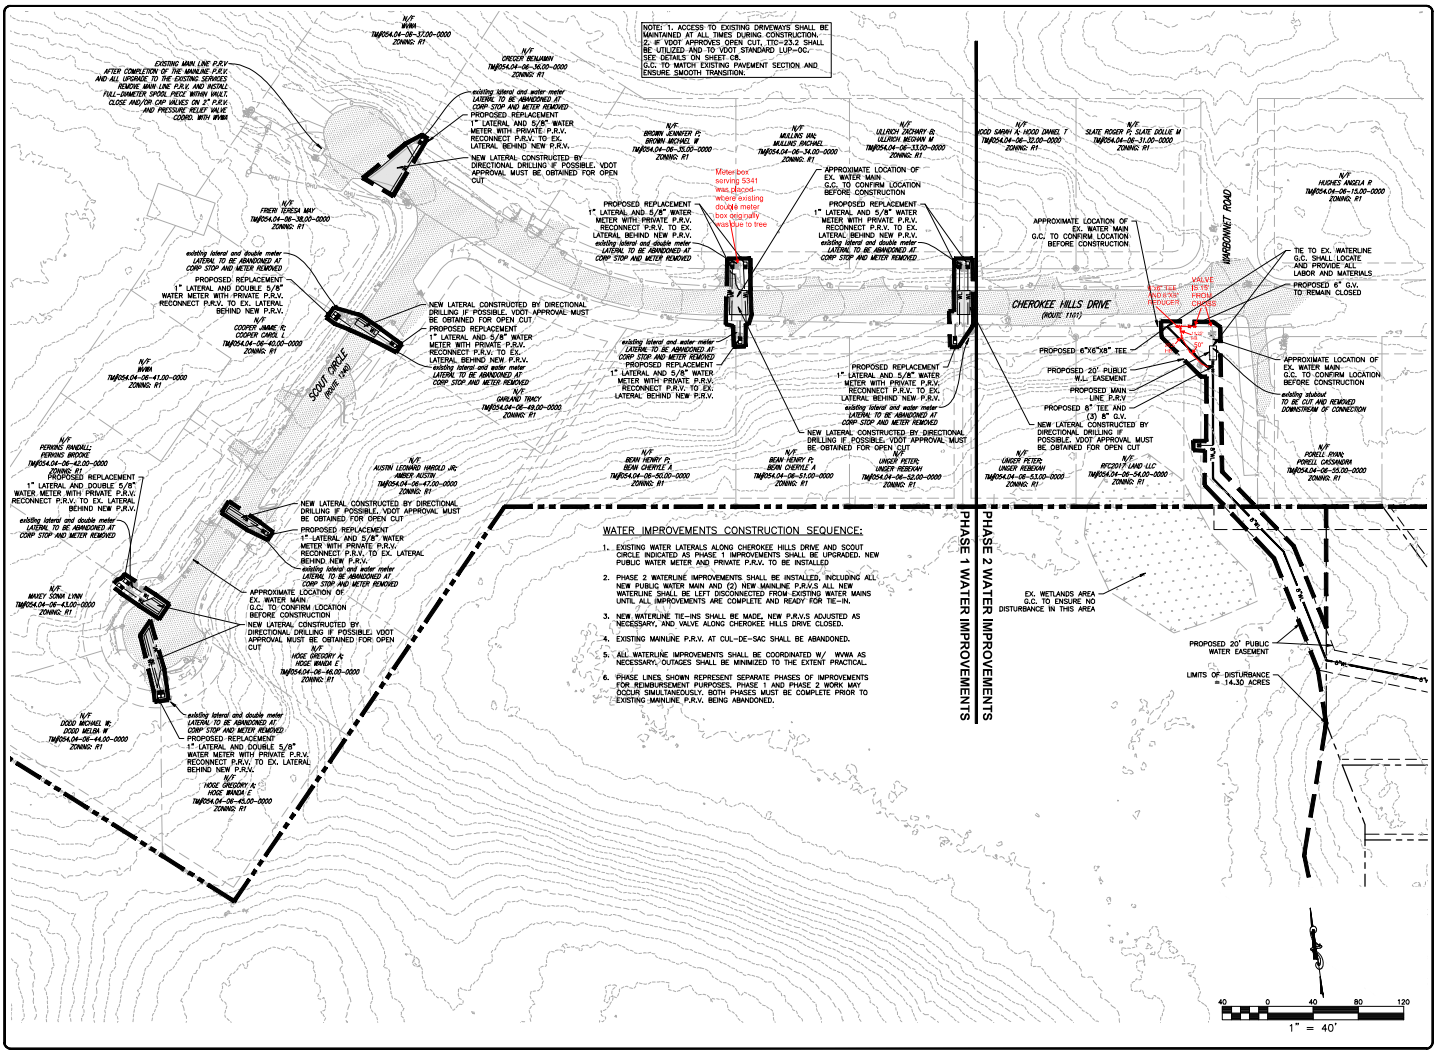

BALZER & ASSOCIATES
PLANNERS / ARCHITECTS
ENGINEERS / SURVEYORS
Roanoke / Richmond
New River Valley
Shenandoah Valley
www.balzer.cc
1308 Corporate Circle
Roanoke, VA 24018
540.772.9697

COMMONWEALTH OF VIRGINIA
CHRISTOPHER P. BUDDE
Lic. No. 47008
9/7/2023
PROFESSIONAL ENGINEER

CHEROKEE HILLS
SECTION 6
OFFSITE UTILITY PLAN

CITYWIDE DISTRICT
ROANOKE COUNTY - 051414

DRAWN BY	AAS
DESIGNED BY	KAM
CHECKED BY	CPB
DATE	12/8/2022
SCALE	1" = 40'
REVISIONS	
4/12/2023	
5/8/2023	
5/30/2023	
8/23/2023	
P.D.U.1 9/22/2023	
9/7/2023	

C4.2
PROJECT NO. 0421.0006.06

APPROVED, 9/12/2023