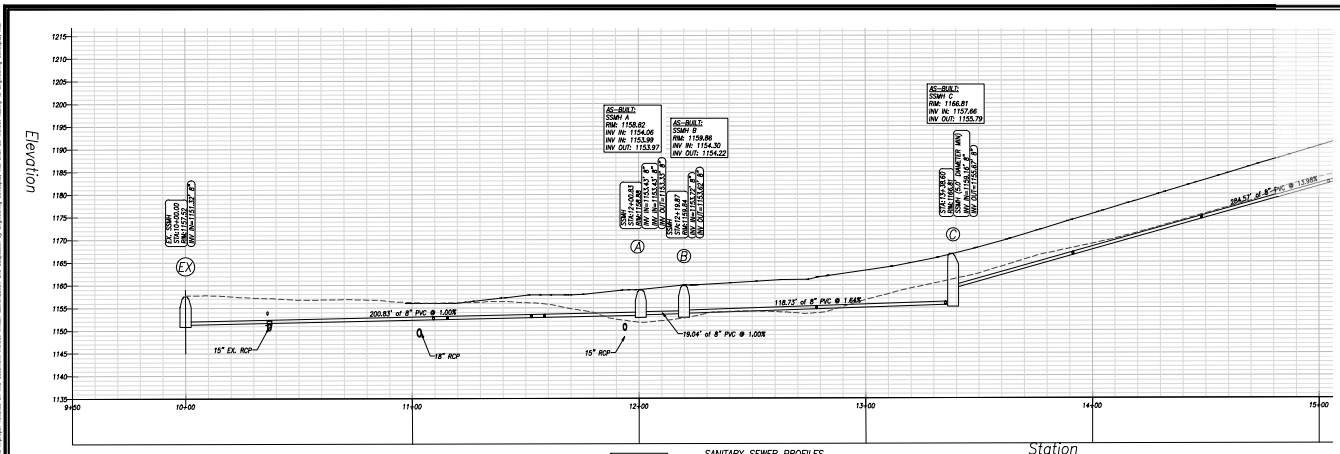

SANITARY SEWER PROFILES
SCALE: H-1"=20'
V-1"=10'

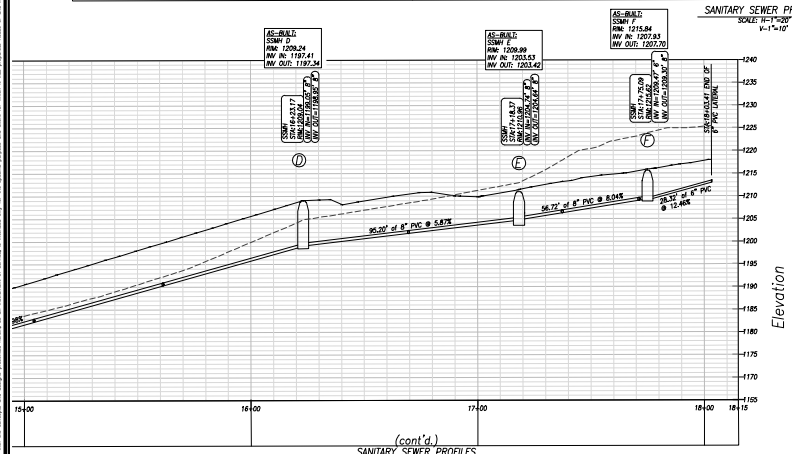

(cont'd.)
SANITARY SEWER PROFILES
SCALE: H-1"=20'
V-1"=10'

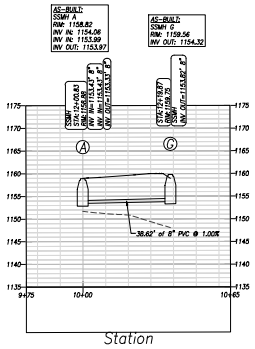

SANITARY EXTENSION PROFILE
SCALE: H-1"=20'
V-1"=10'

Pipe Table					
NAME	SIZE	LENGTH	SLOPE	MATERIAL	MIN. COVER
Pipe – 1	8"	200.83'	1.00%	PVC	3'
Pipe – 2	8"	19.04'	1.00%	PVC	5'
Pipe – 3	8"	118.73'	1.64%	PVC	5'
Pipe – 4	8"	284.57'	13.98%	PVC	7'
Pipe – 5	8"	95.20'	5.87%	PVC	6'
Pipe – 6	8"	56.72'	8.04%	PVC	6'
Pipe – 7	8"	38.62'	1.00%	PVC	4'

AS-BUILT

ENGINEERING CONCEPTS, INC.
94 GREENFIELD STREET
DALEVILLE, VIRGINIA 24083
540.473.1253

No.	Description	Date

COLONIAL GREEN
CITY OF ROANOKE - VIRGINIA
SANITARY SEWER PROFILES AS-BUILT

COMMONWEALTH OF VIRGINIA
JUDSON SCOTT CALDWELL
Lic. No.046713
12/23/24

0 20' 40'
GRAPHIC SCALE

PROJECT: 21019

C-000

This document, together with the concepts and designs presented herein, as an instrument of service, is intended only for the specific purpose and client for which it was prepared. Reuse of and improper reliance on this document without written authorization and adaptation by Engineering Concepts, Inc. shall be without liability to Engineering Concepts, Inc.