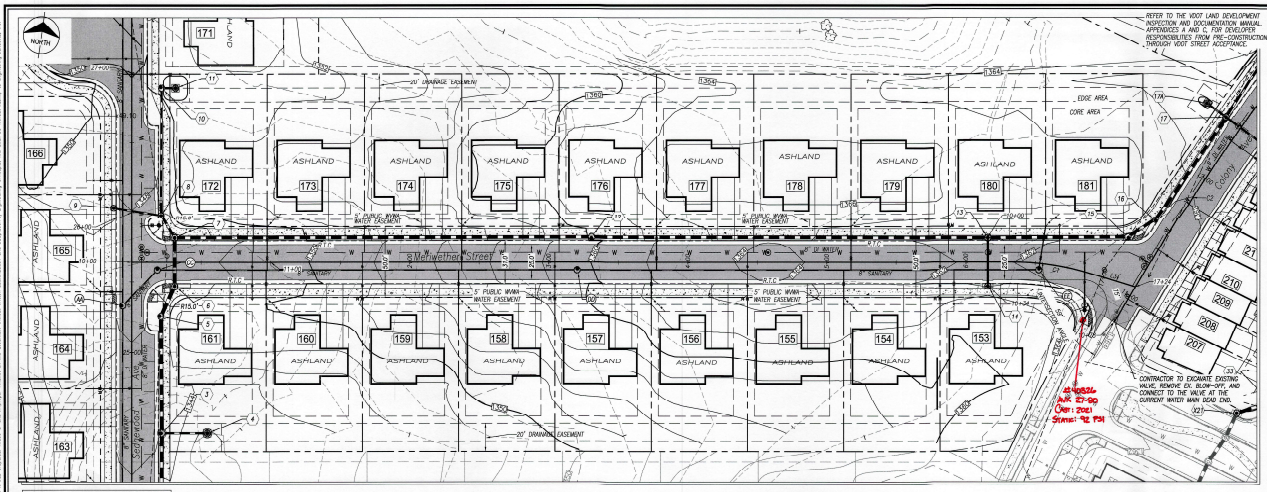

*SEE SHEET C-401 FOR ROAD CENTERLINE CURVE AND LINE TABLES.

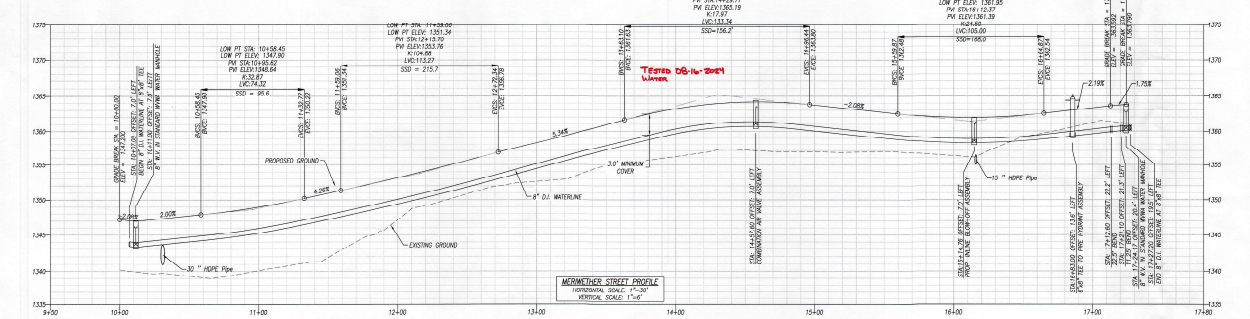

MERIWETHER STREET PROFILE
HORIZONTAL SCALE: 1"=30'
VERTICAL SCALE: 1"=6'

ENGINEERING CONCEPTS, INC.
914 GREENFIELD STREET
DALEVILLE, VIRGINIA 24083
540.474.3.1253

daleville town center

FRALIN & WALDRON, INC

DALEVILLE TOWN CENTER
BOTETOURT COUNTY, VA

MERIWETHER STREET PLAN & PROFILE

STATE OF VIRGINIA
MARK SCOTT CALDWELL
Lic. No.040713
JUNE 14, 2023
PROFESSIONAL ENGINEER

0 30 60
GRAPHIC SCALE

PROJECT: 21061

C-402