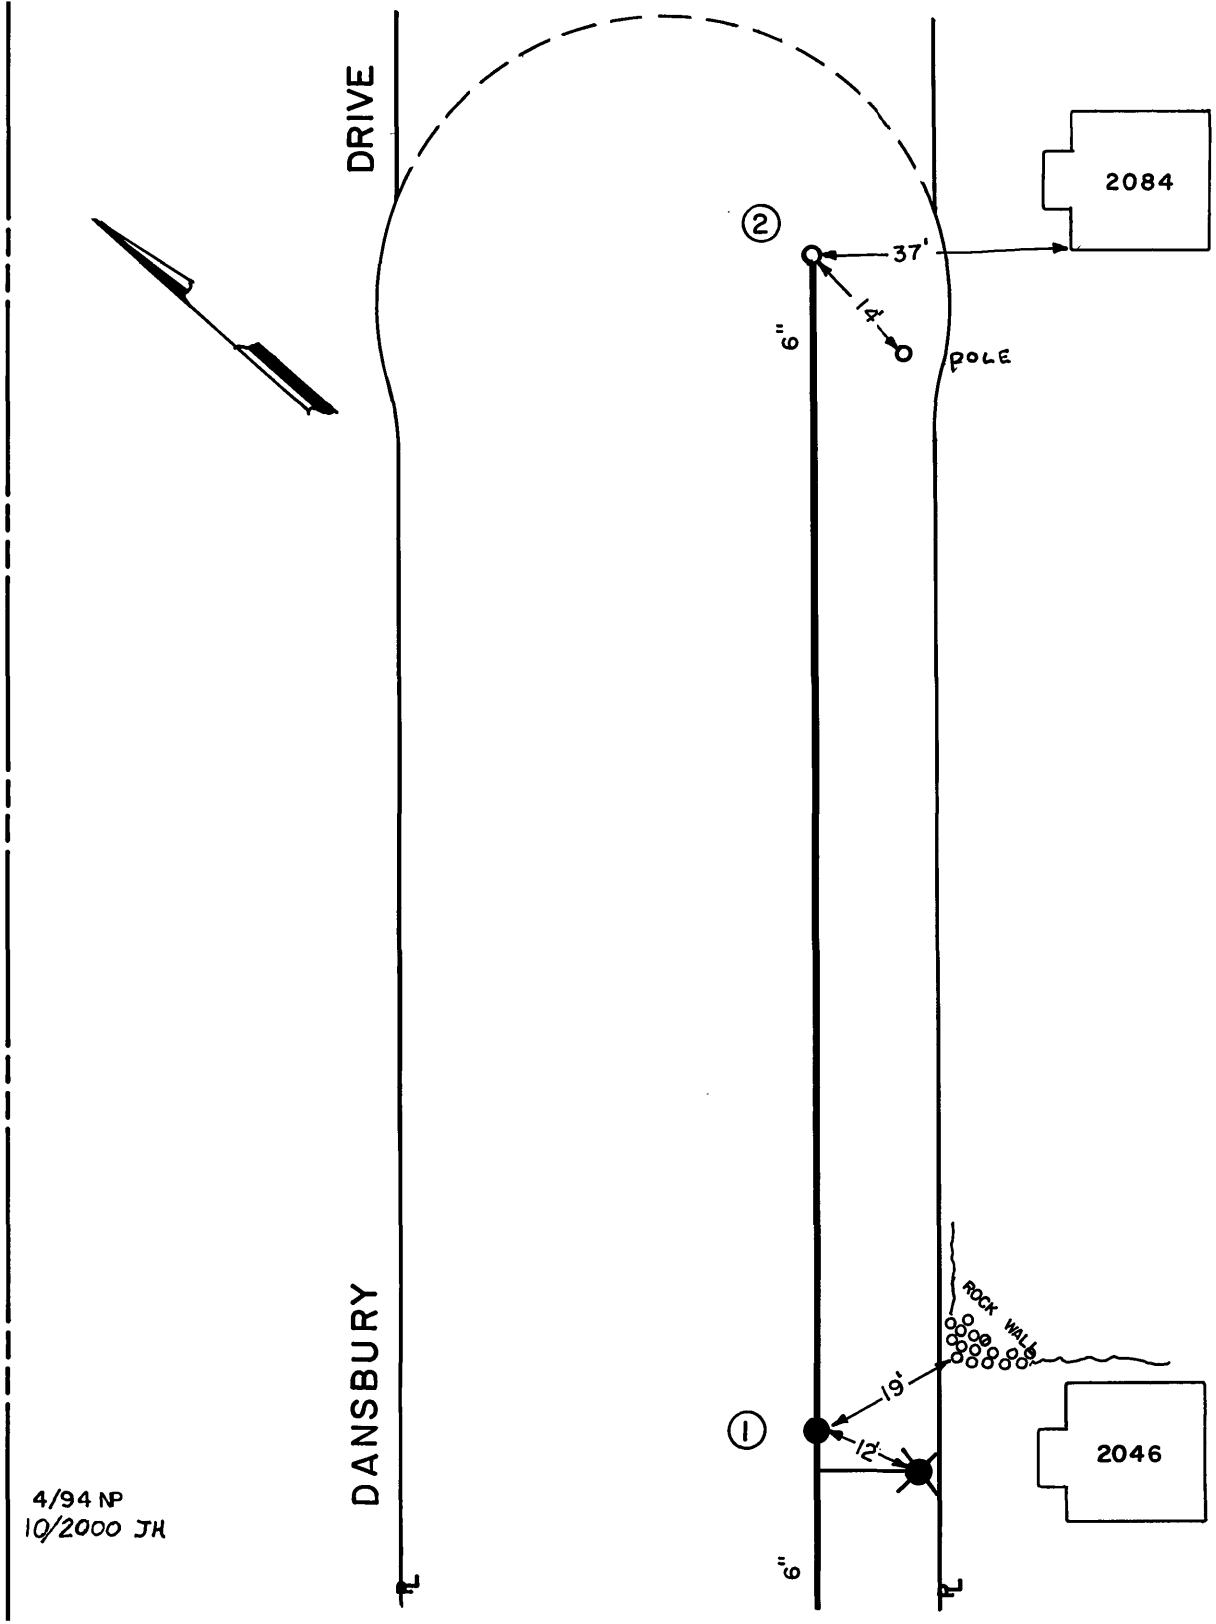


| DATE | NO. | SIZE | MAKE | OPEN | TURNS |
|---|---|---|---|---|---|
| 1993 | 1 | 6" | MUELLER | R | |
| 1993 | 2 | 2" | BLOW OFF | L | |
| | | | | | |
| | | | | | |
CITY OF ROANOKE - WATER DEP'T.

**VALVE DIAGRAM**

DANSBURY DRIVE - 2084

SEC. MAP 640 N.W.

DATE: PAGE NO.

4/94 NP
10/2000 JH