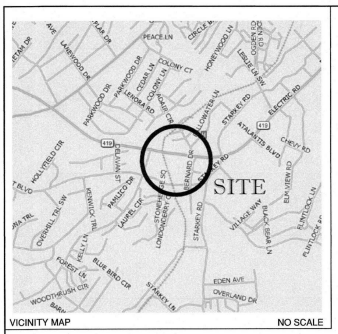

VICINITY MAP NO SCALE

LEGEND:

SSMH SANITARY SEWER MANHOLE
SSCO SANITARY SEWER CLEANOUT

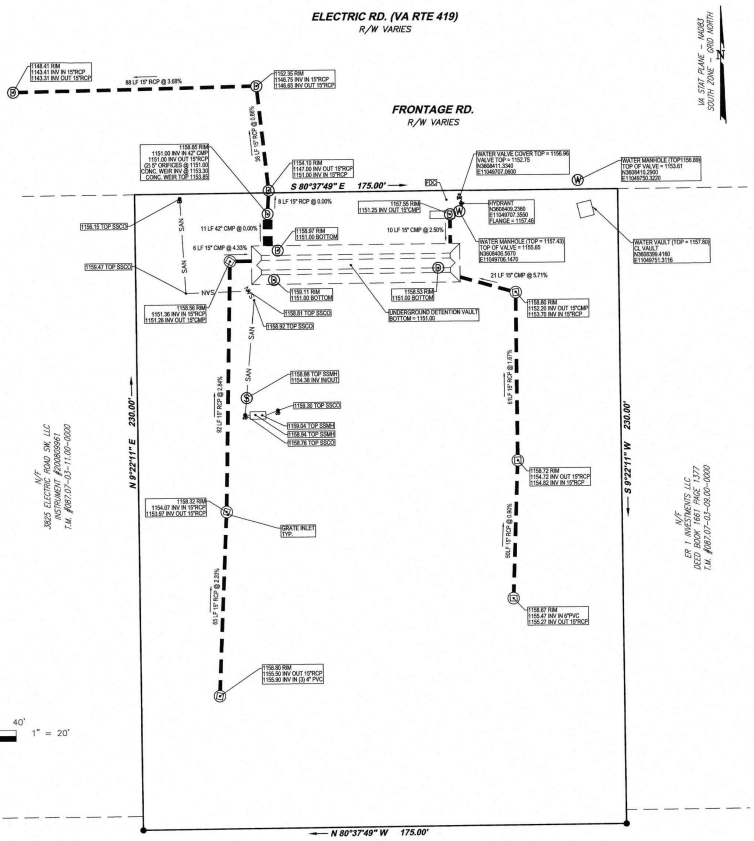

20' 10' 0' 20' 40'
1" = 20'
GRAPHIC SCALE

parker
DESIGN GROUP
ENGINEERS • SURVEYORS
PLANNERS • LANDSCAPE ARCHITECTS

2122 Carolina Ave, SW
Roanoke, VA 24014
Ph: 540-387-1153

1915-B W. Cary Street
Richmond, VA 23220
Phone: 804-358-2947

www.parkerdg.com

COMMONWEALTH OF VIRGINIA
STEVEN C. BARBA
Lic. No. 003125
12/12/22
LAND SURVEYOR

UTILITY AS-BUILT SURVEY FOR
DISCOUNT TIRE
3843 ELECTRIC RD.
CAVE SPRING MAGISTERIAL DISTRICT
ROANOKE COUNTY, VIRGINIA

REVISIONS

CALCS BY:	NA
DRAWN BY:	JAZ
CHECKED BY:	SCB
SCALE:	1" = 20'
DATE:	DEC. 8, 2022
PROJECT NUMBER:	22-0013:01
SHEET NO.:	1 OF 1

©2023 Parker DG 2013 Discount Tire\1 DWG\Survey Base - Production\Survey Invert Hydrant\22-0013 AS-BUILT SURVEY.dwg, December 12, 2022 12:03:19 PM