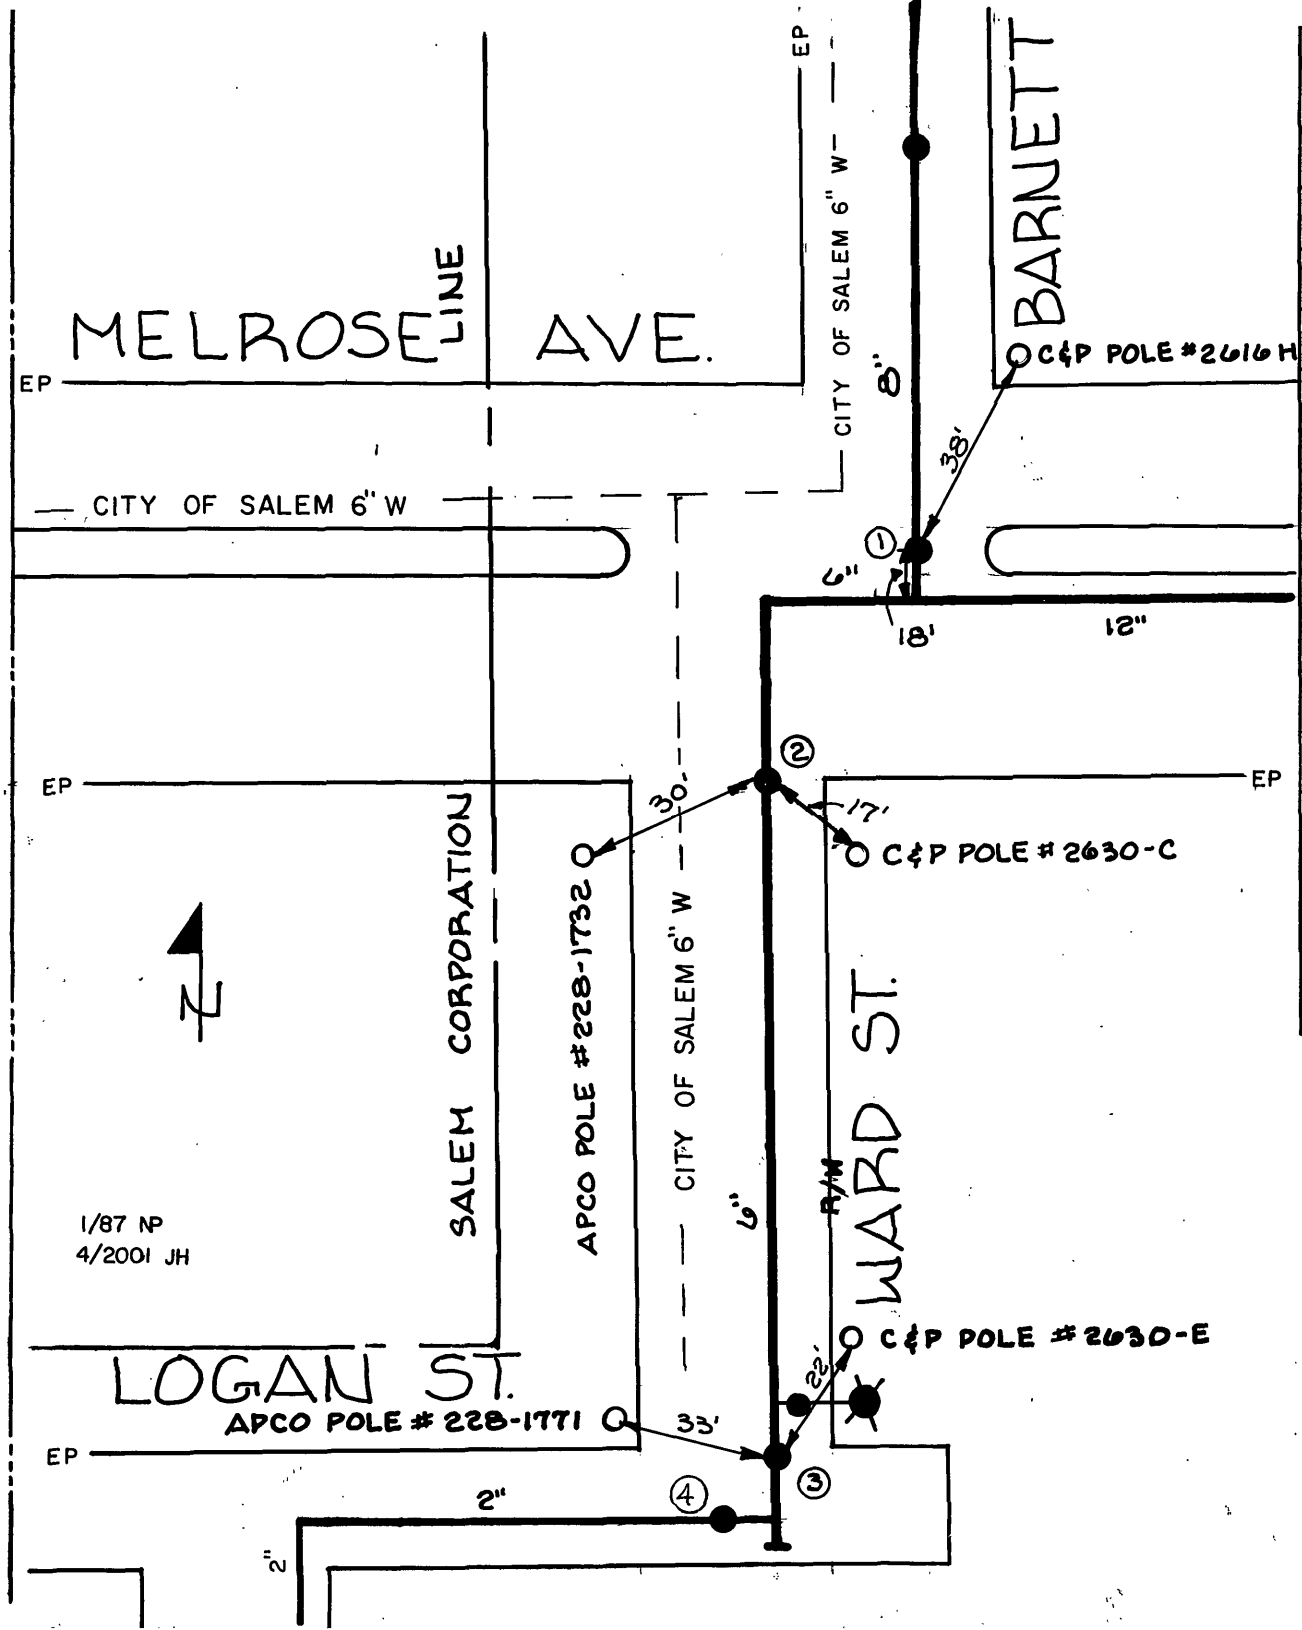

DATE	NO.	SIZE	MAKE	OPEN	TURNS
8-81	1	8"	MUELLER	R	
8-81	2	6"	MUELLER	R	
8-81	3	6"	MUELLER	R	
	4	2"		R	

CITY OF ROANOKE—WATER DEP'T

VALVE DIAGRAM

BARNETT RD, LOGAN ST, MELROSE AVE., & WARD ST. N.W.

SEC. MAP 611, 609.

DATE 8-81 PAGE NO.