


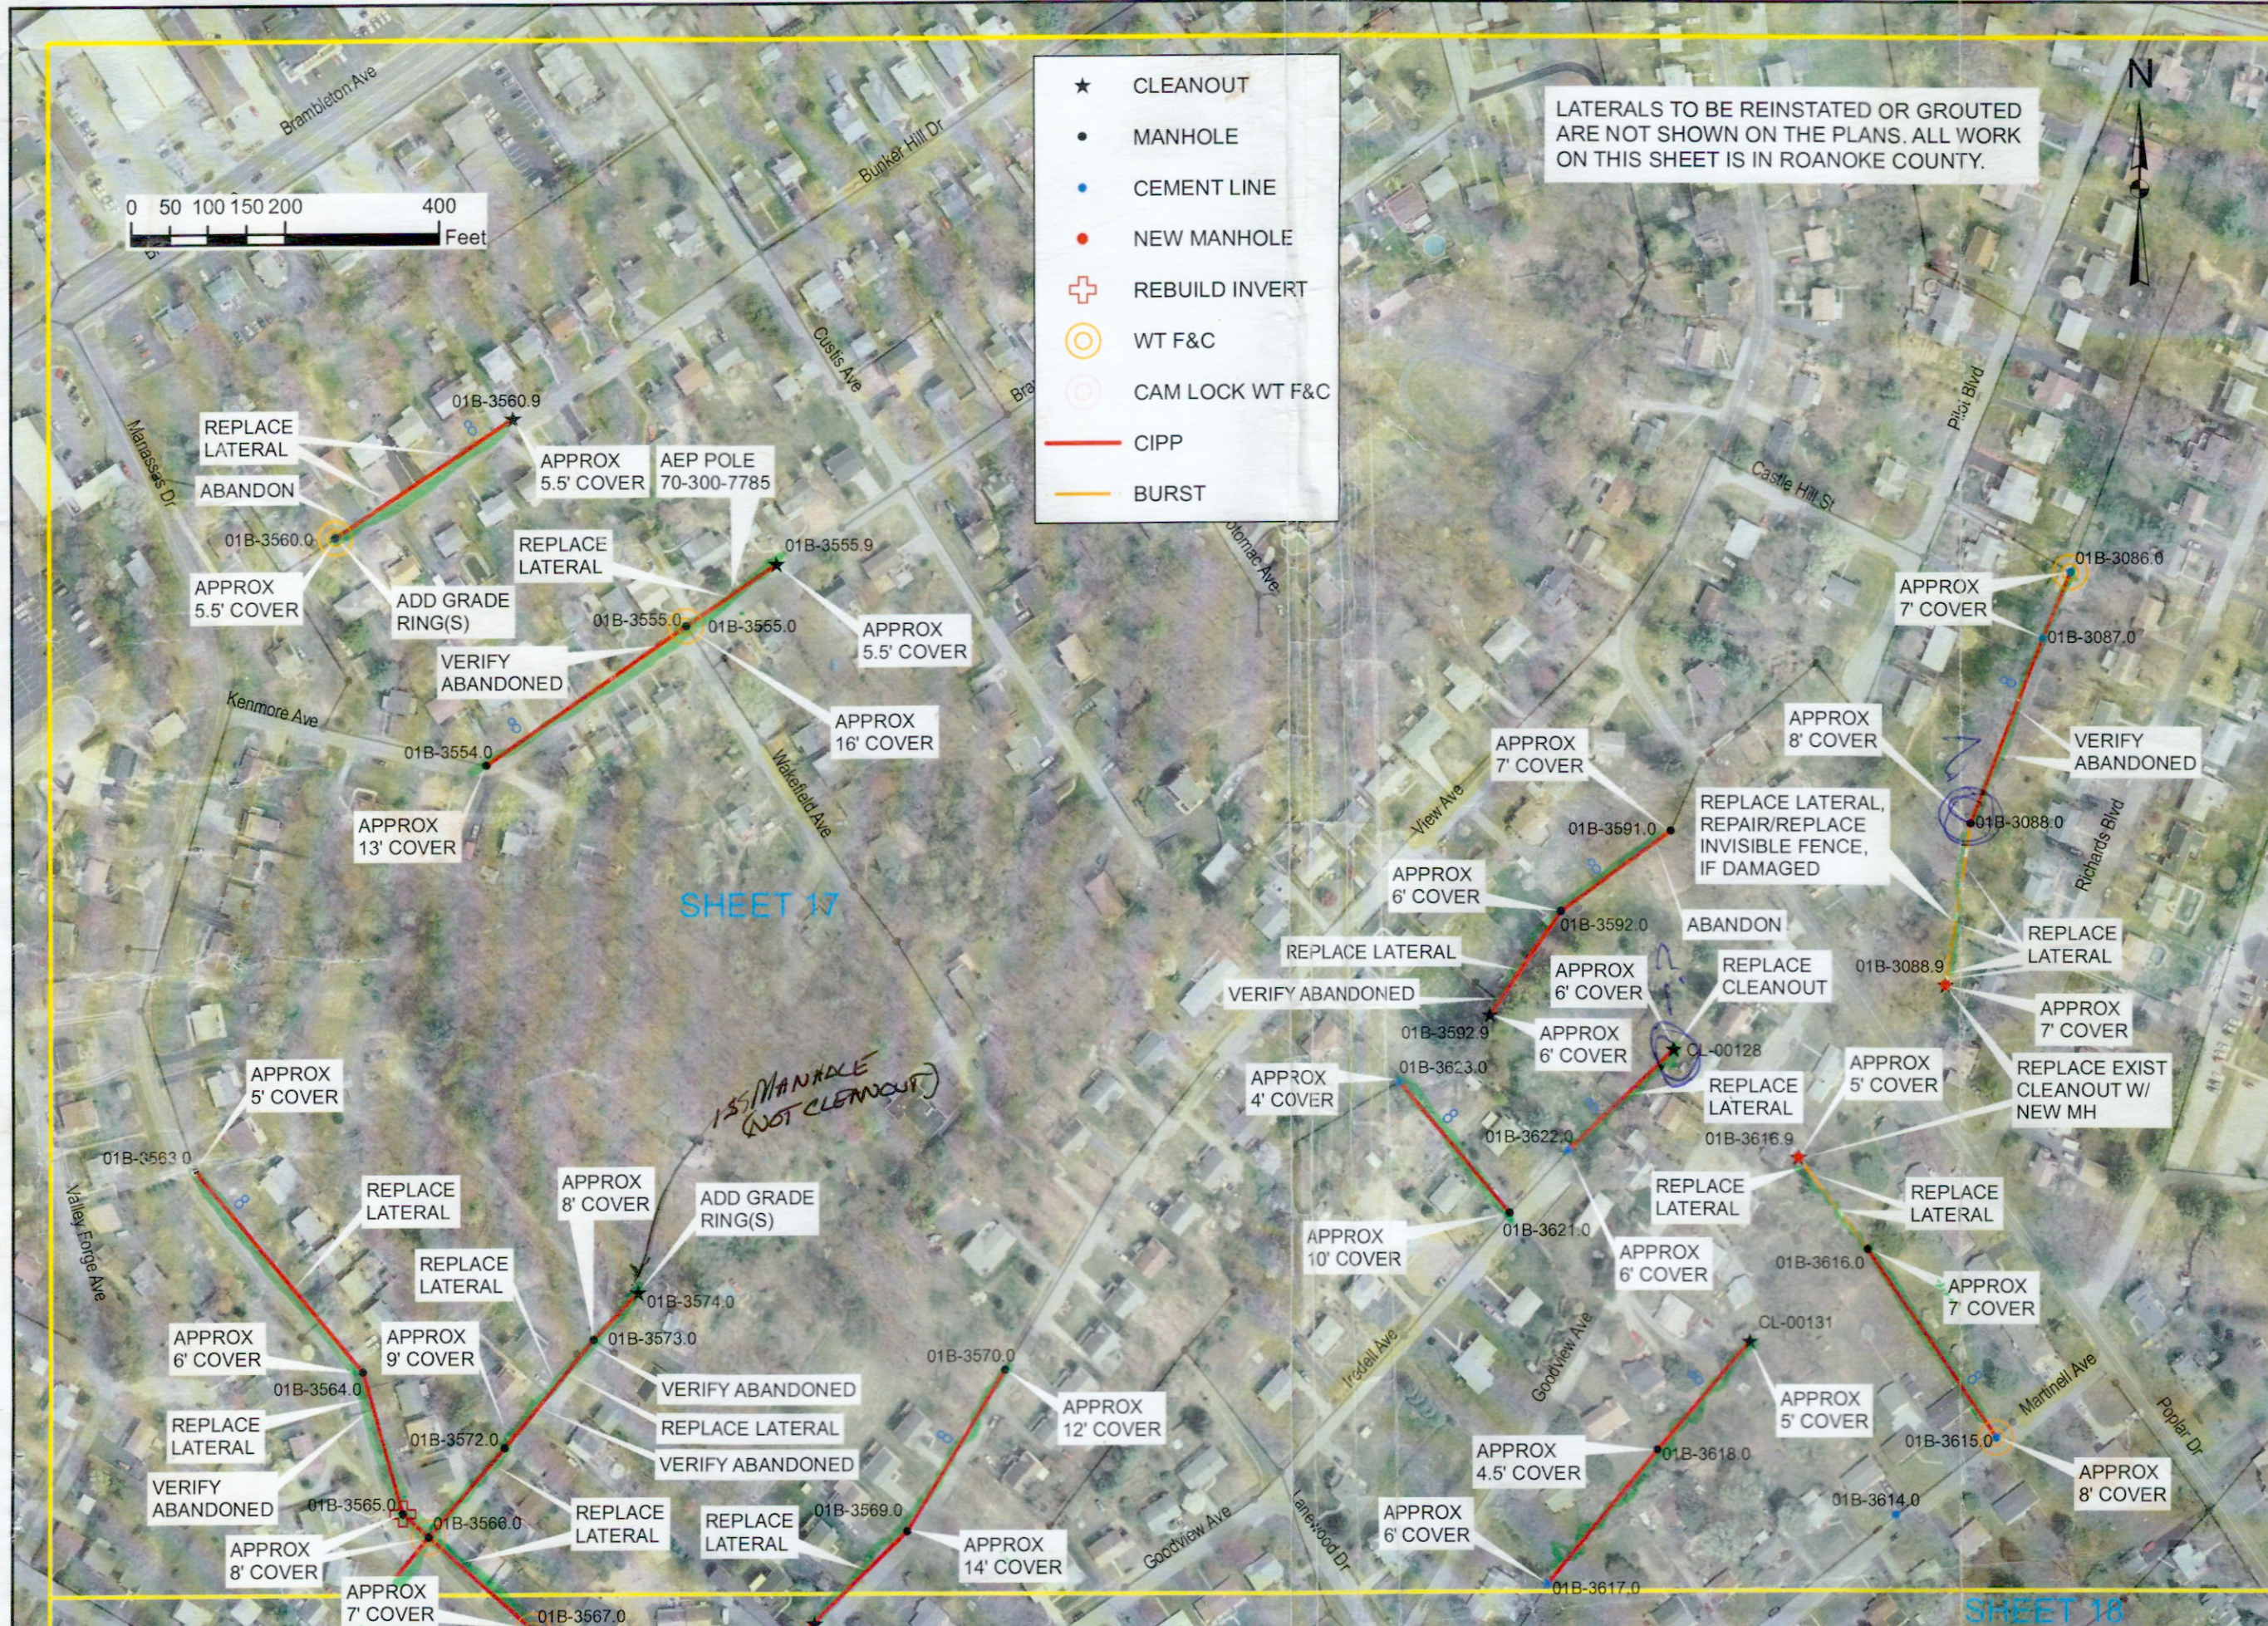

- ★ CLEANOUT
- MANHOLE
- CEMENT LINE
- NEW MANHOLE
- + REBUILD INVERT
- WT F&C
- CAM LOCK WT F&C
- CIPP
- BURST

LATERALS TO BE REINSTATED OR GROUTED ARE NOT SHOWN ON THE PLANS. ALL WORK ON THIS SHEET IS IN ROANOKE COUNTY.

MOUNT VERNON HEIGHTS/
CASTLE HILLS
**WESTERN VIRGINIA
WATER AUTHORITY**
**FY2011 VCWRLF COLLECTION
SYSTEM PROJECTS**
CONTRACTS 1A & 1B REHABILITATION

DESIGNED BY:	JSB
DRAWN BY:	CDH
CHECKED BY:	DBH
SCALE:	AS SHOWN
DATE:	FEB 2012
PROJECT NUMBER:	23184