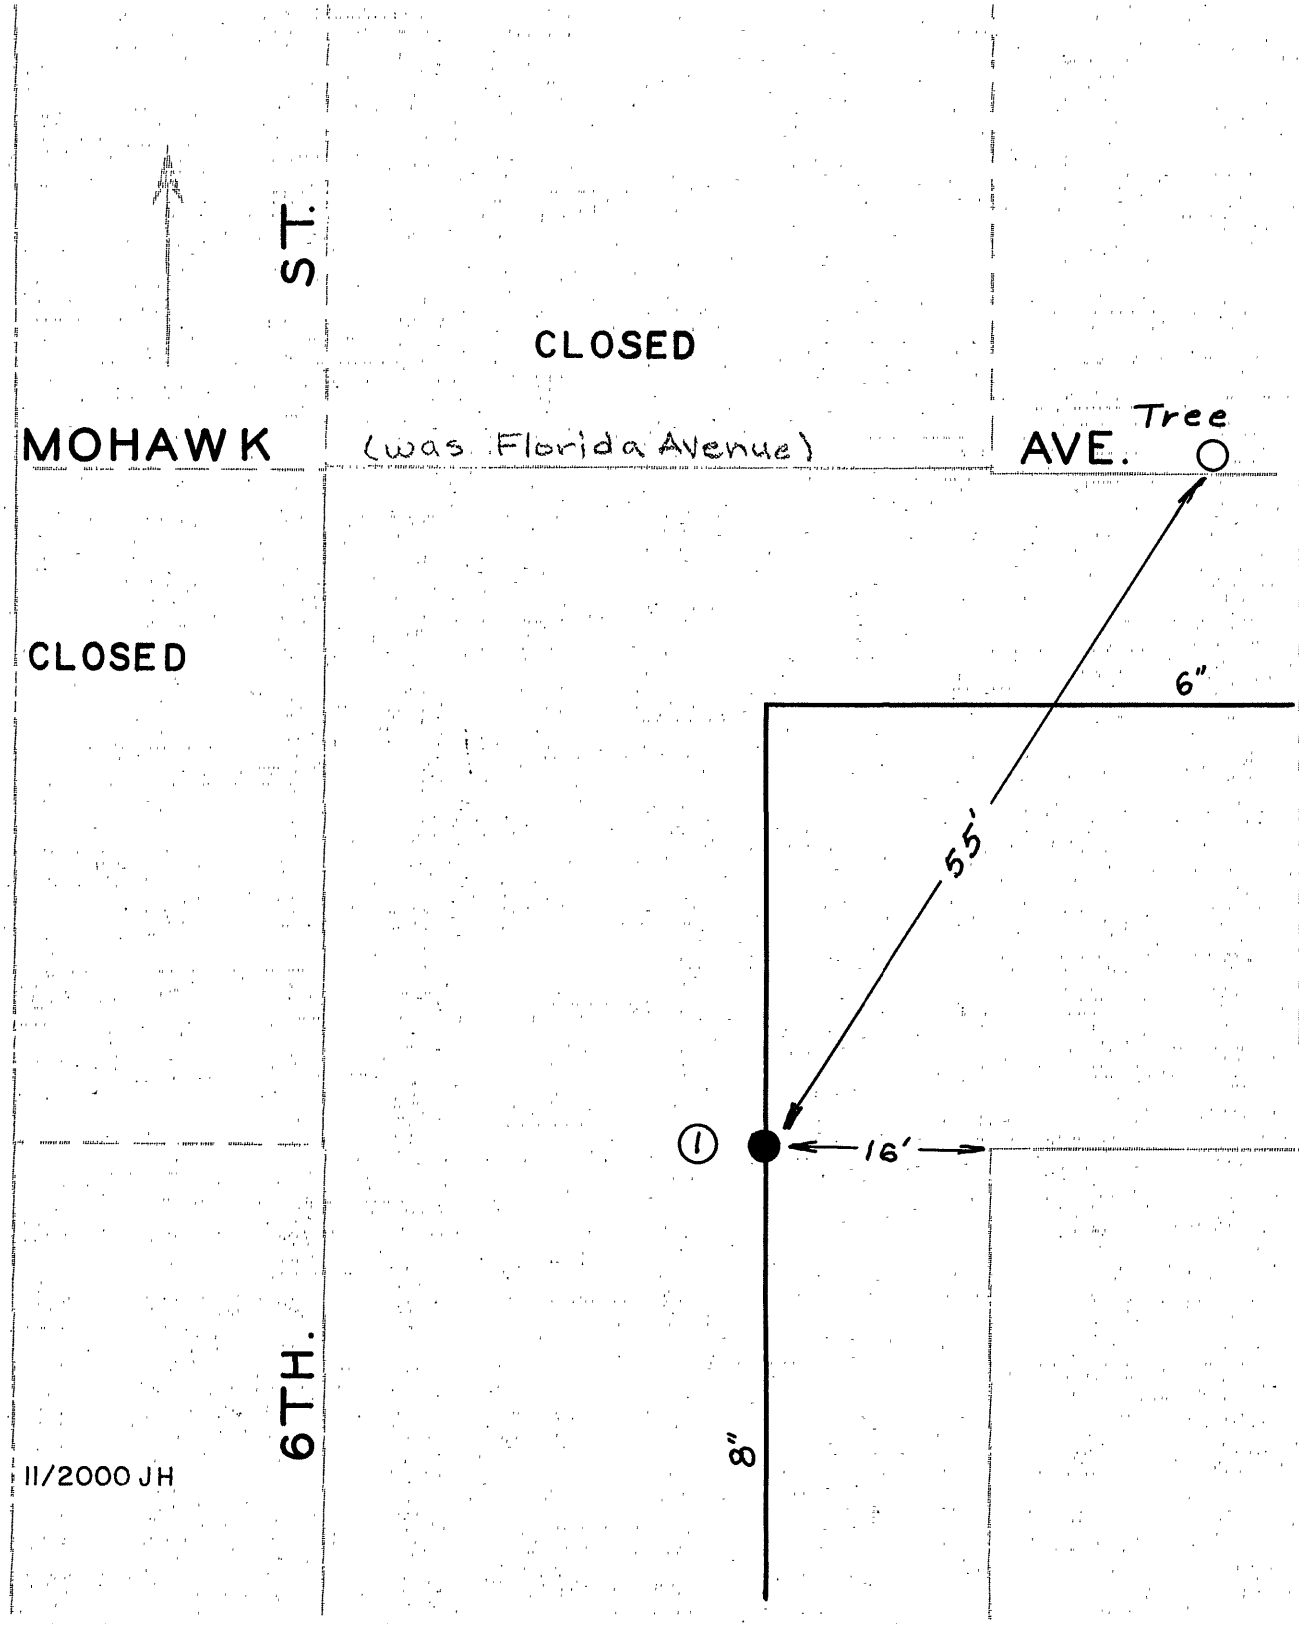

DATE	NO.	SIZE	MAKE	OPEN	TURNS
9-52	1	8"	MUELLER	R	26½
	1	0	SPL		

CITY OF ROANOKE—WATER DEPT

VALVE DIAGRAM

MOHAWK AVE. & [illegible]

6th. STREET

SEC. MAP 304, 307 N.E.

DATE PAGE 10