

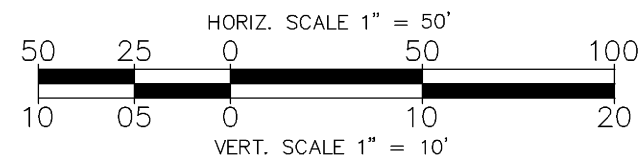
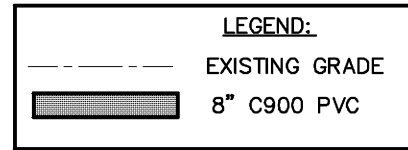


Mar 14, 2012 - 10:32am V:\LandProjects\20080815\dwg\Asbults-WL-ASBULT-P-Water.dwg

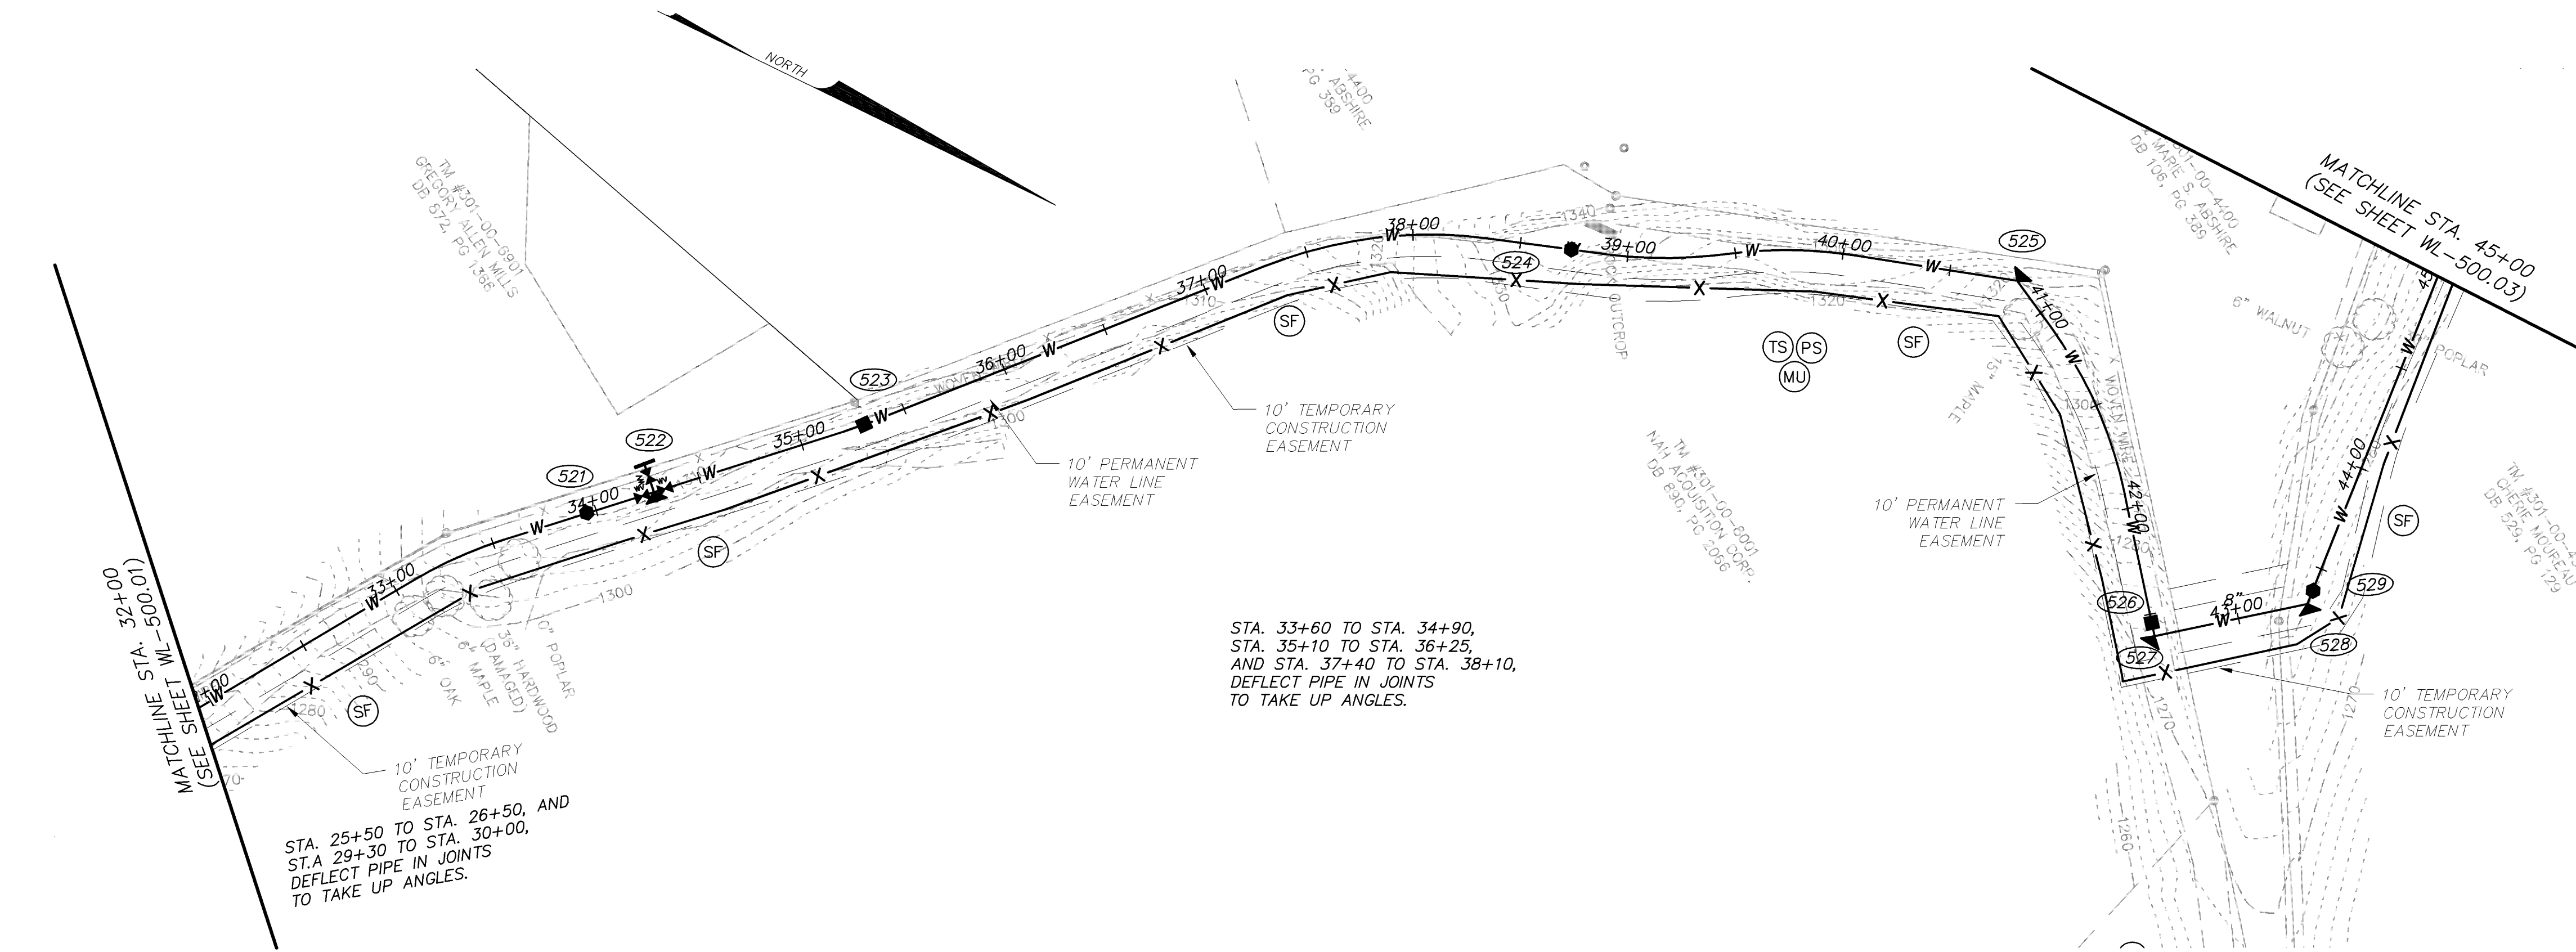

- WATER LINE STRUCTURE SCHEDULE
- (521) STA. 33+96±
REQ'D:
1-AIR RELEASE VALVE
(SEE DETAIL AR-2)
- (522) STA. 34+28±
REQ'D:
1-8" X 8" TEE
3-8" GATE VALVE AND BOX
1-BULKHEAD ASSEMBLY
1-CONCRETE ANCHOR
CONTRACTOR TO COORDINATE EXACT LOCATION OF TEE WITH TOWN
- (523) STA. 35+30±
REQ'D:
1-BLOW OFF ASSEMBLY
(SEE DETAIL BC-1)
- (524) STA. 38+74±
REQ'D:
1-AIR RELEASE VALVE
(SEE DETAIL AR-2)
- (525) STA. 40+81±
REQ'D:
1-8" 45° BEND
1-CONCRETE ANCHOR
- (526) STA. 42+54±
REQ'D:
1-BLOW OFF ASSEMBLY
(SEE DETAIL BC-1)
- (527) STA. 42+61±
REQ'D:
1-8" 90° BEND
1-CONCRETE ANCHOR
- (528) STA. 43+33±
REQ'D:
1-8" 45° BEND
1-CONCRETE ANCHOR
- (529) STA. 43+39±
REQ'D:
1-AIR RELEASE VALVE
(SEE DETAIL AR-2)

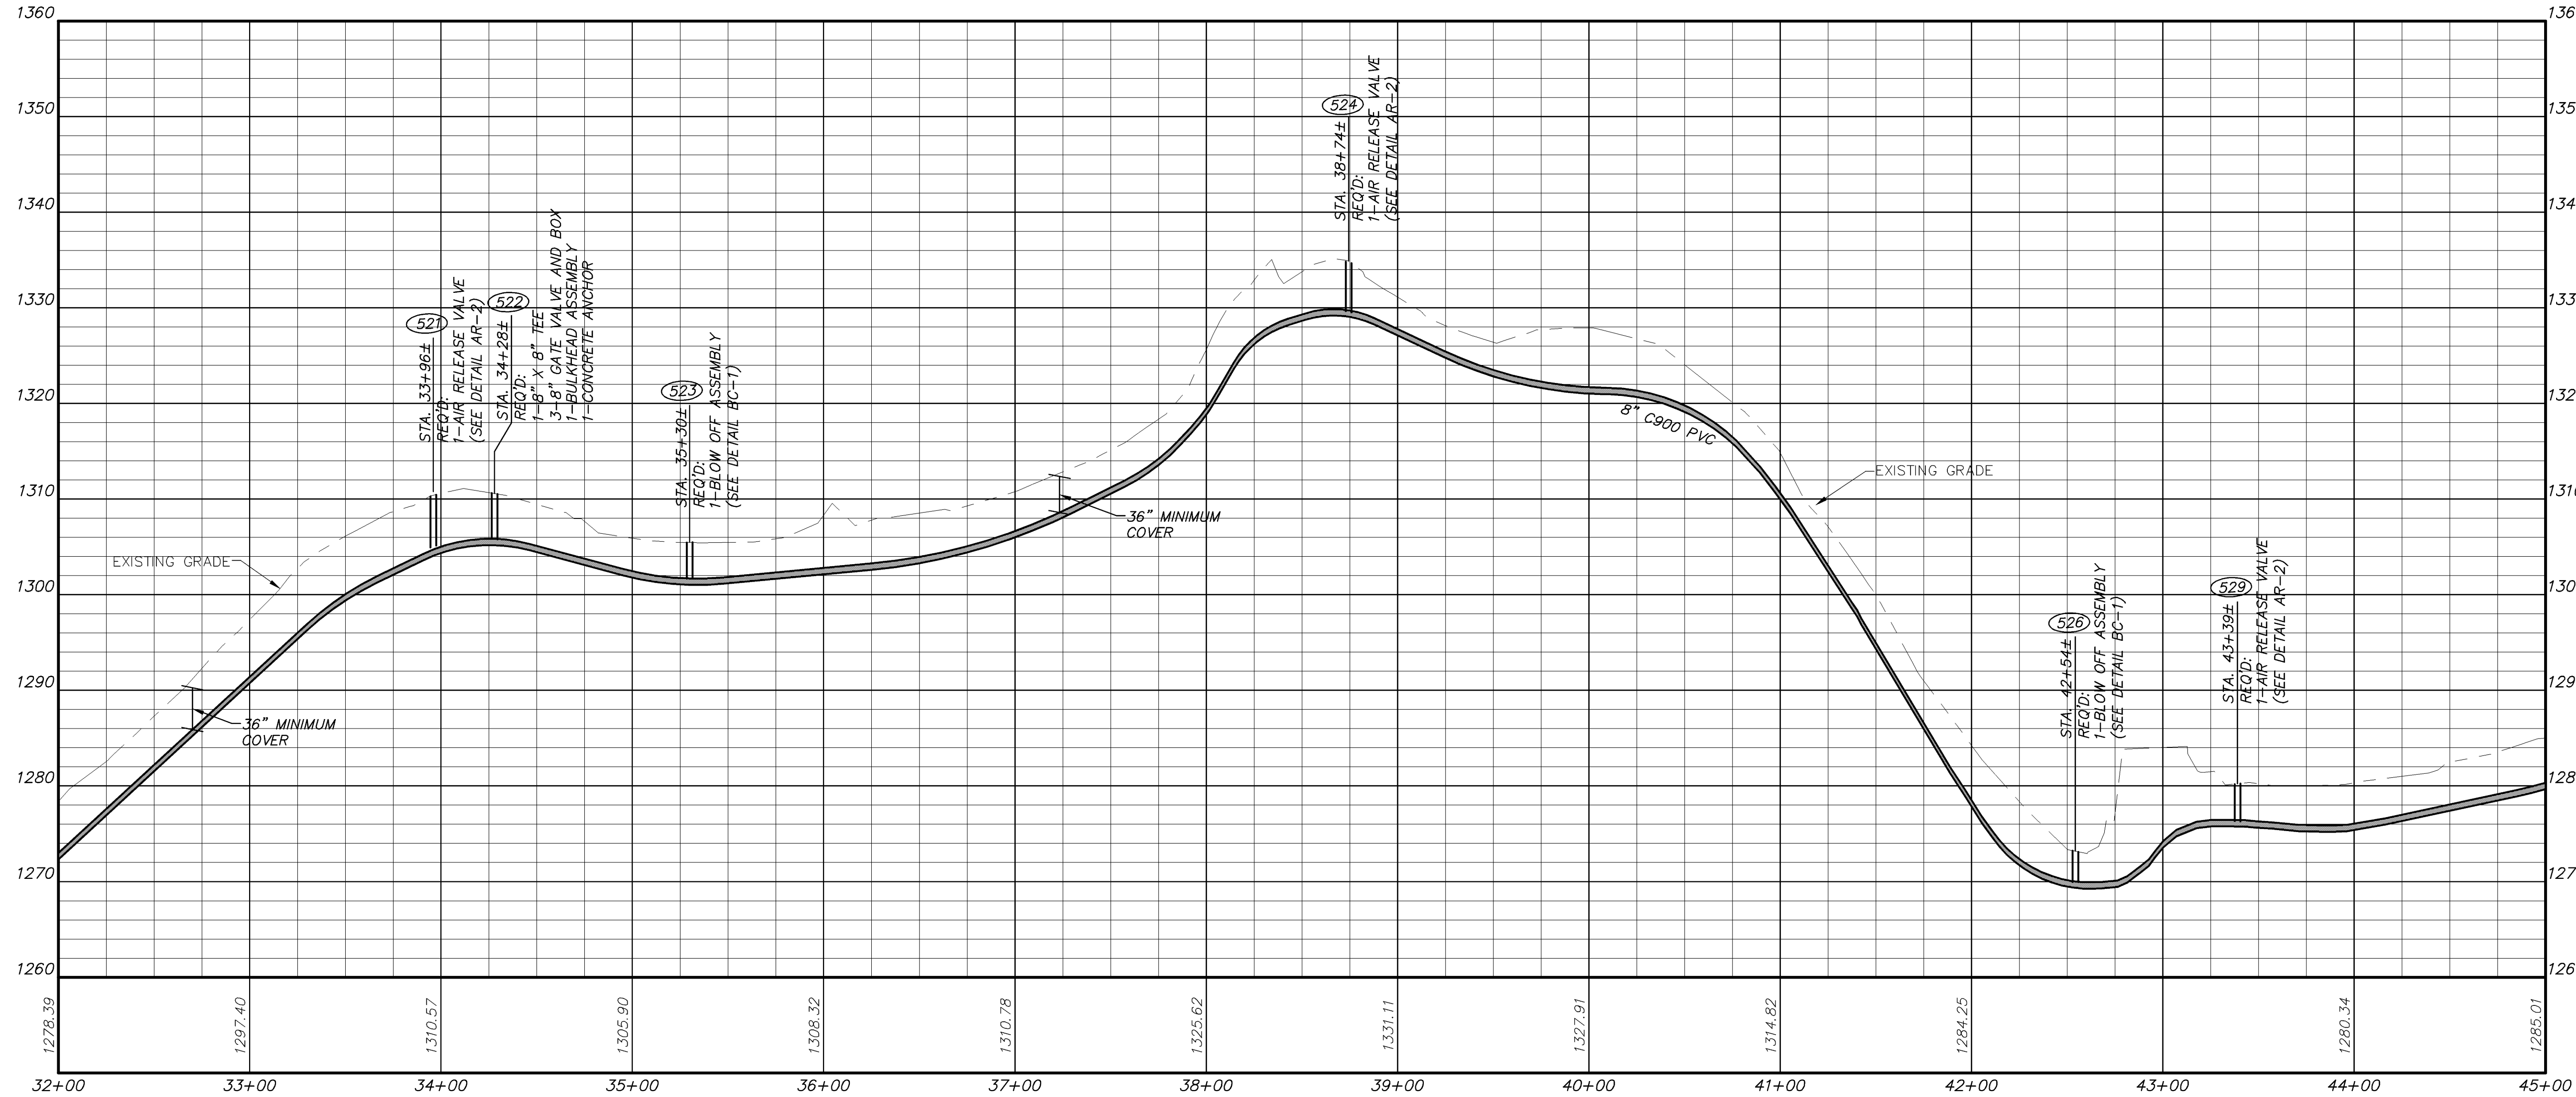


- EXISTING LEGEND
- ELECTRIC POLE
 - GUY WIRE
 - UTILITY PEDESTAL
 - LIGHT POLE
 - EDGE OF PAVEMENT
 - EDGE OF GRAVEL
 - BENCHMARK
 - SIGN
 - CONCRETE PAD
 - EDGE OF WOODS
 - EXISTING FENCE LINE
 - OVERHEAD ELECTRIC
 - UG ELECTRIC LINE
 - UG GAS LINE
 - UG TELEPHONE LINE
 - UG FIBER OPTIC LINE
 - UG WATER LINE
 - DITCH LINE

- PROPOSED LEGEND
- WATER METER
 - WATER LINE
 - BLOW OFF ASSEMBLY
 - AIR RELEASE
 - FIRE HYDRANT
 - CONCRETE ANCHOR
 - GATE VALVE
 - STEEL CASING
 - SLOPE ANCHOR
 - E.O.L. END OF LINE

1	8/28/09	VDH COMMENTS
2	9/3/09	OWNER COMMENTS
4	3/14/12	ASBULTS

*ENGINEERING >> SURVEYING >> PLANNING

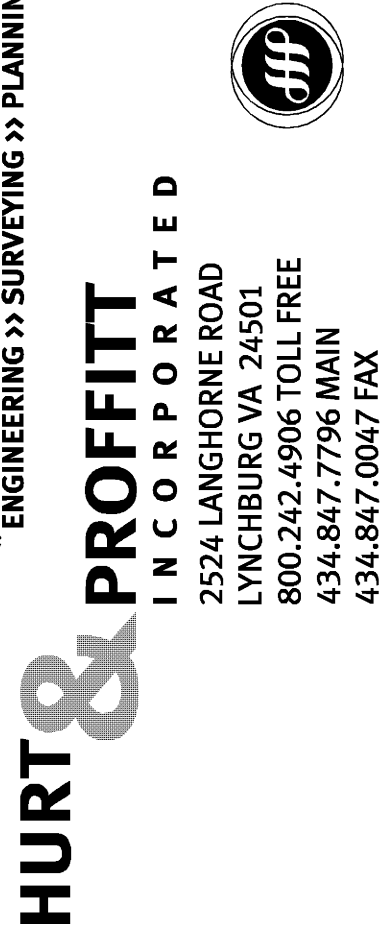

STA. 32+00 - 45+00± WINDING WAY-ASBULT
FOR
TOWN OF BOONES MILL WATER SYSTEM REPLACEMENT, VOLUME 1
TOWN OF BOONES MILL, BOONE DISTRICT, FRANKLIN COUNTY, VA

PROJECT NO. 20080815
G.L. NO. 297-03-A3.9
FILE NO. G-12675
DATE: 7/31/09
DRAWN BY: WCH
CHECKED BY: BLC

HURT & PROFFITT

SHEET NO.
WL-500.02