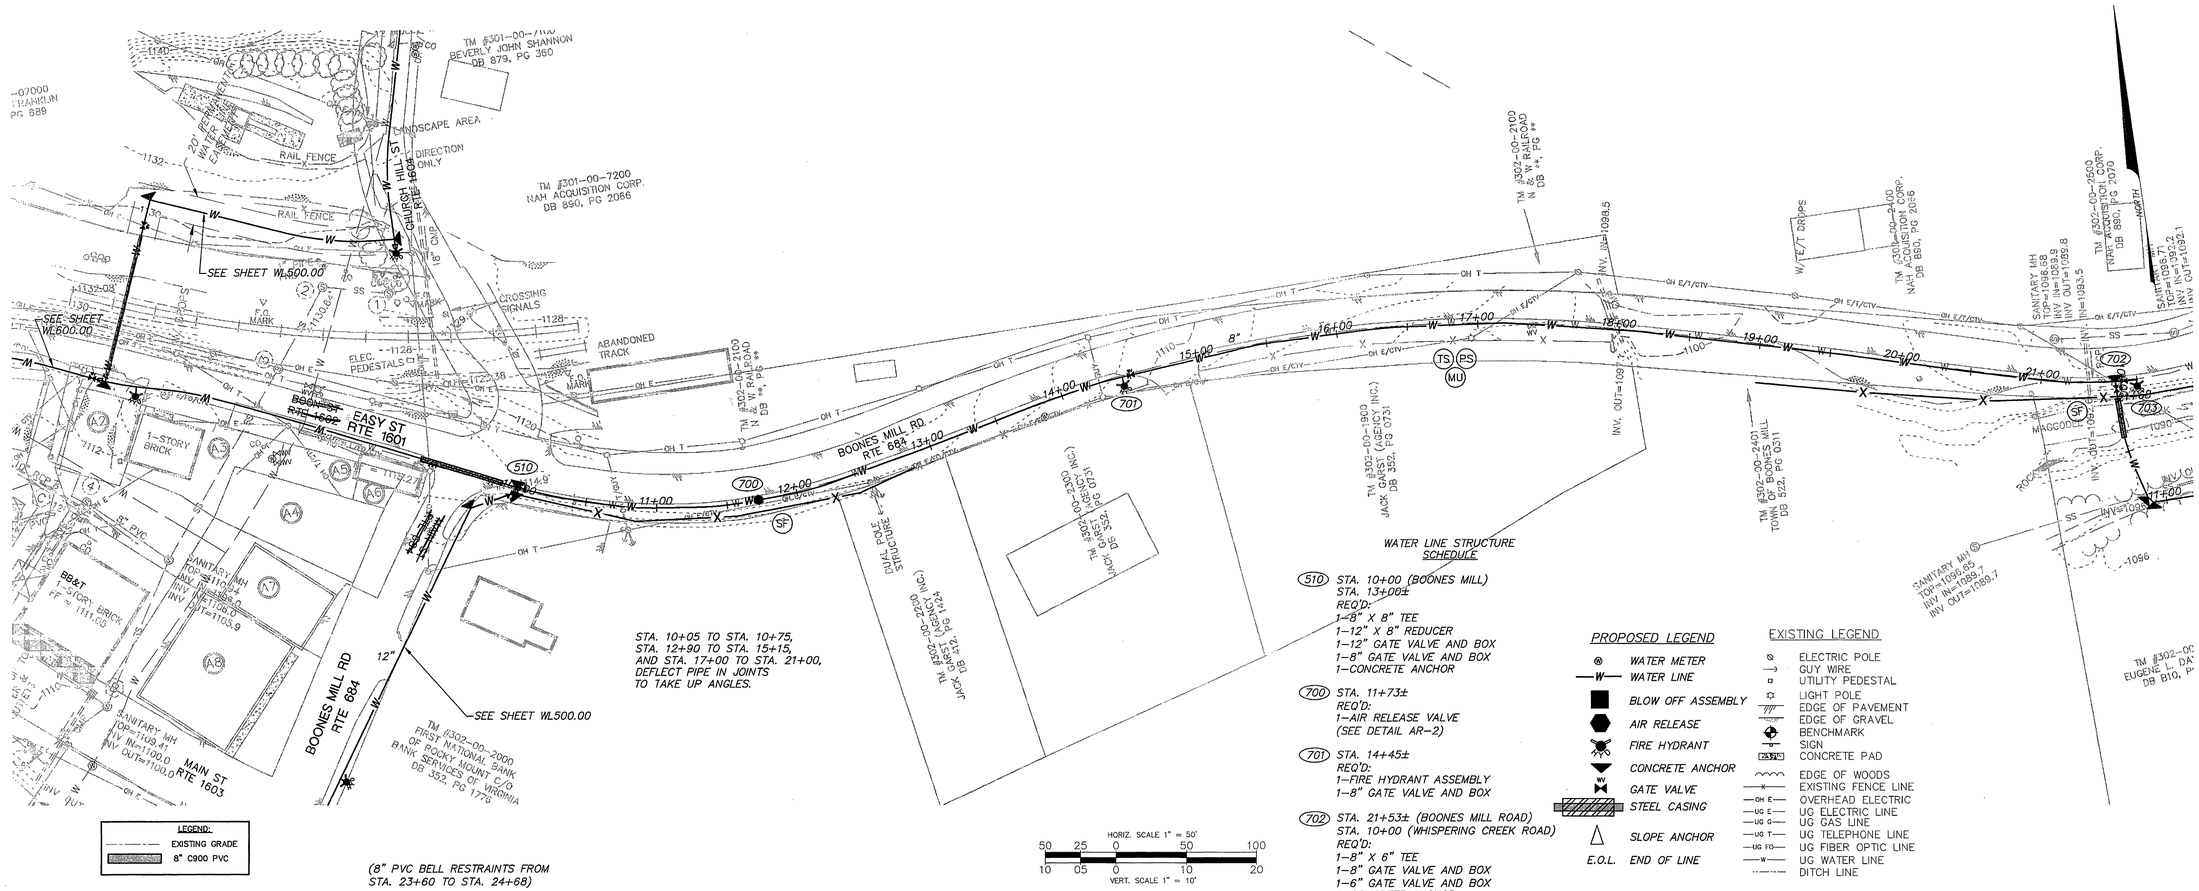

WATER LINE STRUCTURE SCHEDULE

(510) STA. 10+00 (BOONES MILL)
STA. 13+00±
REQ'D:
1–8" X 8" TEE
1–12" X 8" REDUCER
1–12" GATE VALVE AND BOX
1–8" GATE VALVE AND BOX
1–CONCRETE ANCHOR

(700) STA. 11+73±
REQ'D:
1–AIR RELEASE VALVE
(SEE DETAIL AR–2)

(701) STA. 14+45±
REQ'D:
1–FIRE HYDRANT ASSEMBLY
1–8" GATE VALVE AND BOX

(702) STA. 21+53± (BOONES MILL ROAD)
STA. 10+00 (WHISPERING CREEK ROAD)
REQ'D:
1–8" X 6" TEE
1–8" GATE VALVE AND BOX
1–6" GATE VALVE AND BOX
1–CONCRETE ANCHOR

(703) STA. 21+68± EOL
REQ'D:
1–FIRE HYDRANT ASSEMBLY

PROPOSED LEGEND

- WATER METER
- WATER LINE
- BLOW OFF ASSEMBLY
- AIR RELEASE
- FIRE HYDRANT
- CONCRETE ANCHOR
- GATE VALVE
- STEEL CASING
- SLOPE ANCHOR
- E.O.L. END OF LINE

EXISTING LEGEND

- ELECTRIC POLE
- GUY WIRE
- UTILITY PEDESTAL
- LIGHT POLE
- EDGE OF PAVEMENT
- EDGE OF GRAVEL
- BENCHMARK
- SIGN
- CONCRETE PAD
- EDGE OF WOODS
- EXISTING FENCE LINE
- OH E — OVERHEAD ELECTRIC
- UG E — UG ELECTRIC LINE
- UG G — UG GAS LINE
- UG T — UG TELEPHONE LINE
- UG FO — UG FIBER OPTIC LINE
- W — UG WATER LINE
- DITCH LINE

PROFILE INFORMATION TAKEN FROM RECORD DRAWINGS

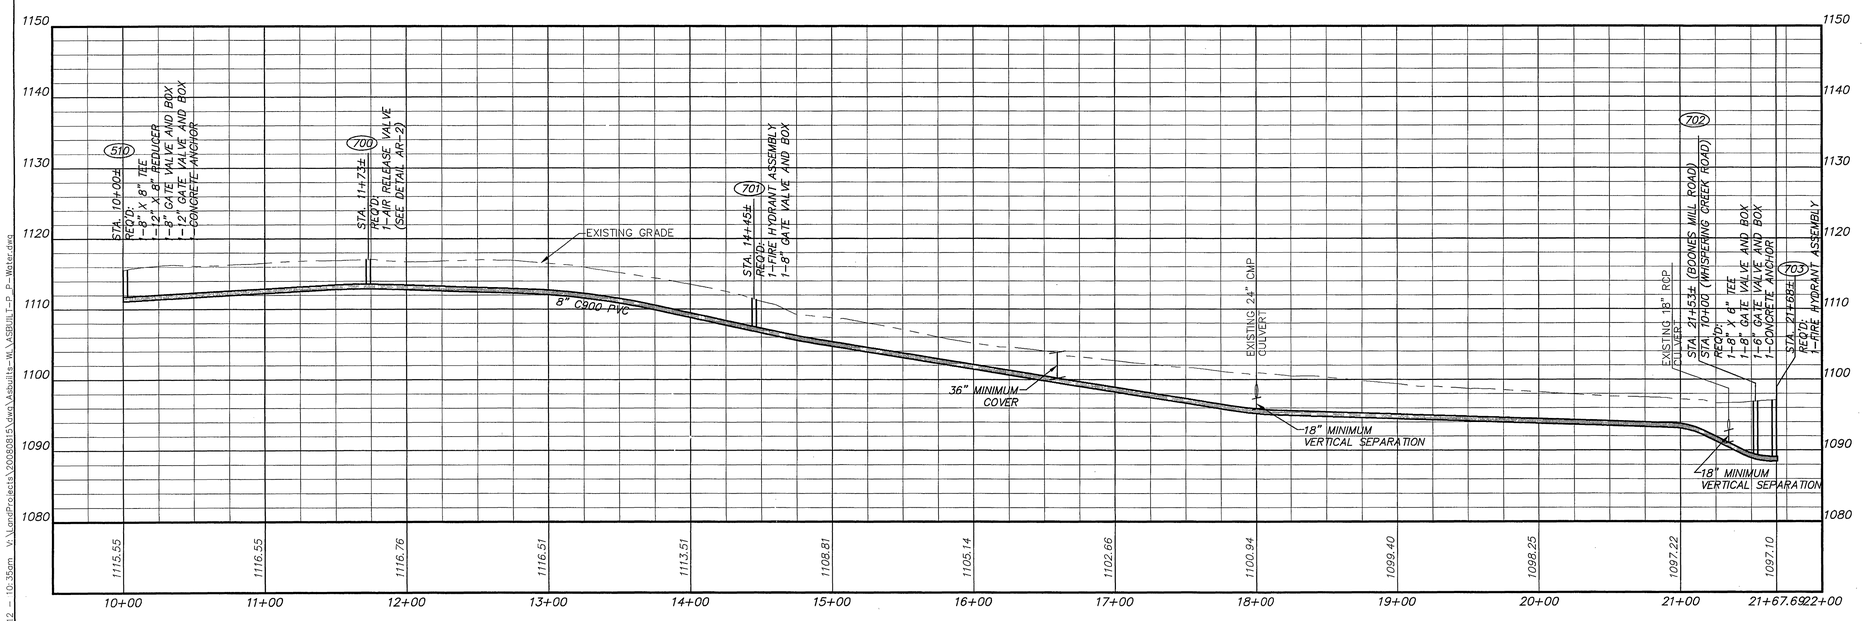

1	8/28/09	VDH COMMENTS
2	9/3/09	OWNER COMMENTS
3	2/17/10	REVISED ALIGNMENT
4	3/14/12	ASBUILTS

*ENGINEERING »» SURVEYING »» PLANNING
HURT & PROFFITT
INCORPORATED
2524 LANGHORNE ROAD
LYNCHBURG VA 24501
800.242.4906 TOLL FREE
434.847.7796 MAIN
434.847.0047 FAX

STA. 10+00 - 21+68 EOL BOONES MILL ROAD-ASBUILT
FOR
TOWN OF BOONES MILL WATER SYSTEM REPLACEMENT, VOLUME 1
TOWN OF BOONES MILL, BOONE DISTRICT, FRANKLIN COUNTY, VA

PROJECT NO.	20080815
G.L. NO.	297-03-A3.9
FILE NO.	G-12675
DATE:	7/31/09
DRAWN BY:	WCH
CHECKED BY:	BLC

HURT & PROFFITT

SHEET NO.
WL-700.00

Mar 14, 2012 – 10:35am V:\LandProjects\20080815\dwg\Asbuilts-WL\ASBUILT-P-Water.dwg