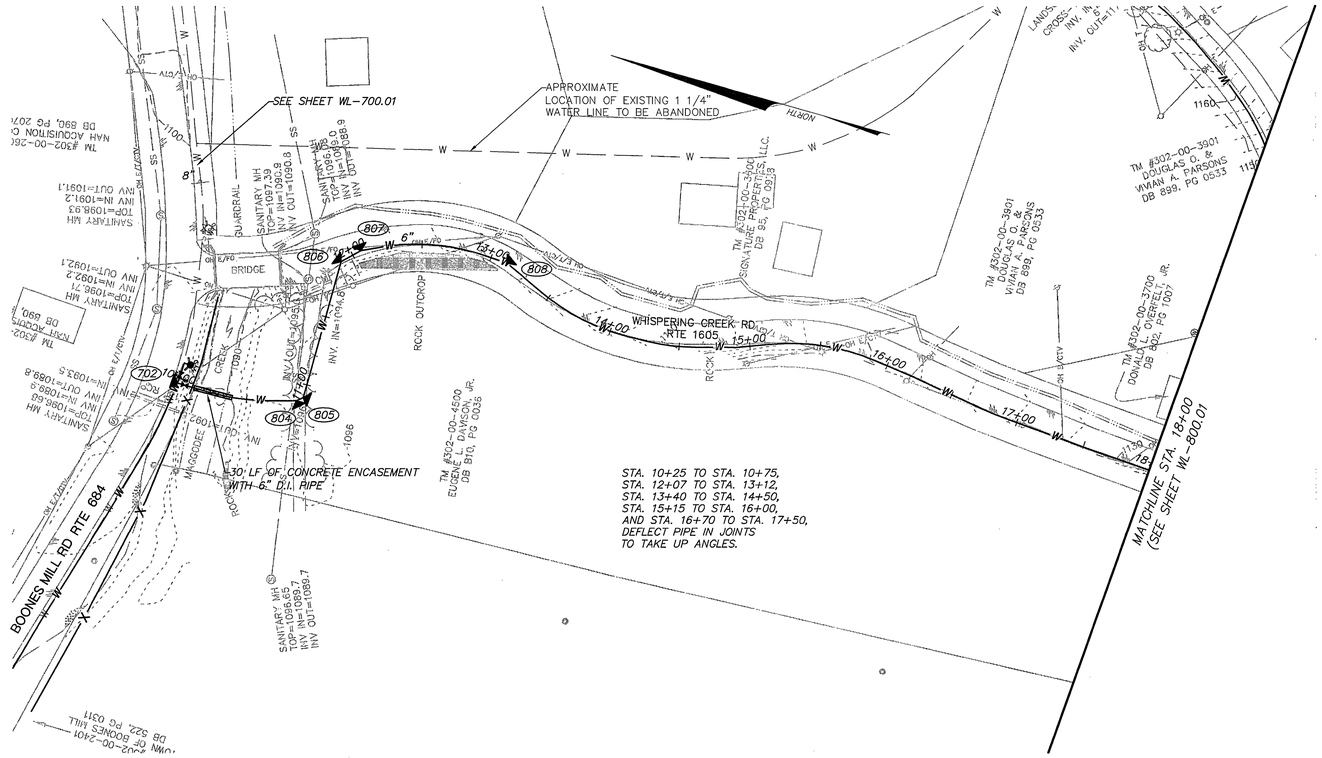


## PROPOSED LEGEND

- WATER METER
- WATER LINE
- BLOW OFF ASSEMBLY
- AIR RELEASE
- FIRE HYDRANT
- CONCRETE ANCHOR
- GATE VALVE
- STEEL CASING
- SLOPE ANCHOR
- E.O.L. END OF LINE

## EXISTING LEGEND

- ELECTRIC POLE
- GUY WIRE
- UTILITY PEDESTAL
- LIGHT POLE
- EDGE OF PAVEMENT
- EDGE OF GRAVEL
- BENCHMARK
- SIGN
- CONCRETE PAD
- EDGE OF WOODS
- EXISTING FENCE LINE
- OH E — OVERHEAD ELECTRIC
- UG E — UG ELECTRIC LINE
- UG G — UG GAS LINE
- UG T — UG TELEPHONE LINE
- UG FO — UG FIBER OPTIC LINE
- W — UG WATER LINE
- DITCH LINE

## WATER LINE STRUCTURE SCHEDULE

(702) STA. 10+00 (WHISPERING CREEK ROAD)
STA. 21+53± (BOONES MILL)
REQ'D:
1–8" X 6" TEE
1–8" GATE VALVE AND BOX
1–6" GATE VALVE AND BOX
1–CONCRETE ANCHOR

(800) STA. 10+06±
REQ'D:
1–6" 22.5° VERTICAL BEND
1–CONCRETE ANCHOR

(801) STA. 10+09±
REQ'D:
1–6" 22.5° VERTICAL BEND
1–CONCRETE ANCHOR

(802) STA. 10+45±
REQ'D:
1–6" 22.5° VERTICAL BEND
1–CONCRETE ANCHOR

(803) STA. 10+54±
REQ'D:
1–6" 22.5° VERTICAL BEND
1–CONCRETE ANCHOR

(804) STA. 10+85±
REQ'D:
1–6" 22.5° BEND
1–CONCRETE ANCHOR

(805) STA. 10+91±
REQ'D:
1–6" 45° BEND
1–CONCRETE ANCHOR

(806) STA. 11+91±
REQ'D:
1–6" 45° BEND
1–CONCRETE ANCHOR

(807) STA. 12+07±
REQ'D:
1–6" 22.5° BEND
1–CONCRETE ANCHOR

(808) STA. 13+12±
REQ'D:
1–6" 22.5° BEND
1–CONCRETE ANCHOR

LEGEND:
- EXISTING GRADE
- 6" C900 PVC




HORIZ. SCALE 1" = 50'
50 25 0 50 100
10 05 0 10 20
VERT. SCALE 1" = 10'

| | | |
|---|---|---|
| 1 | 8/28/09 | VDH COMMENTS |
| 2 | 9/3/09 | OWNER COMMENTS |
| 4 | 3/14/12 | ASBUILTS |


HURT & PROFFITT
INCORPORATED
ENGINEERING >> SURVEYING >> PLANNING
2524 LANGHORNE ROAD
LYNCHBURG VA 24501
800.242.4906 TOLL FREE
434.847.7796 MAIN
434.847.0047 FAX


# STA. 10+00 - 18+00 WHISPERING CREEK ROAD-ASBUILT
FOR
## TOWN OF BOONES MILL WATER SYSTEM REPLACEMENT, VOLUME 1
## TOWN OF BOONES MILL, BOONE DISTRICT, FRANKLIN COUNTY, VA
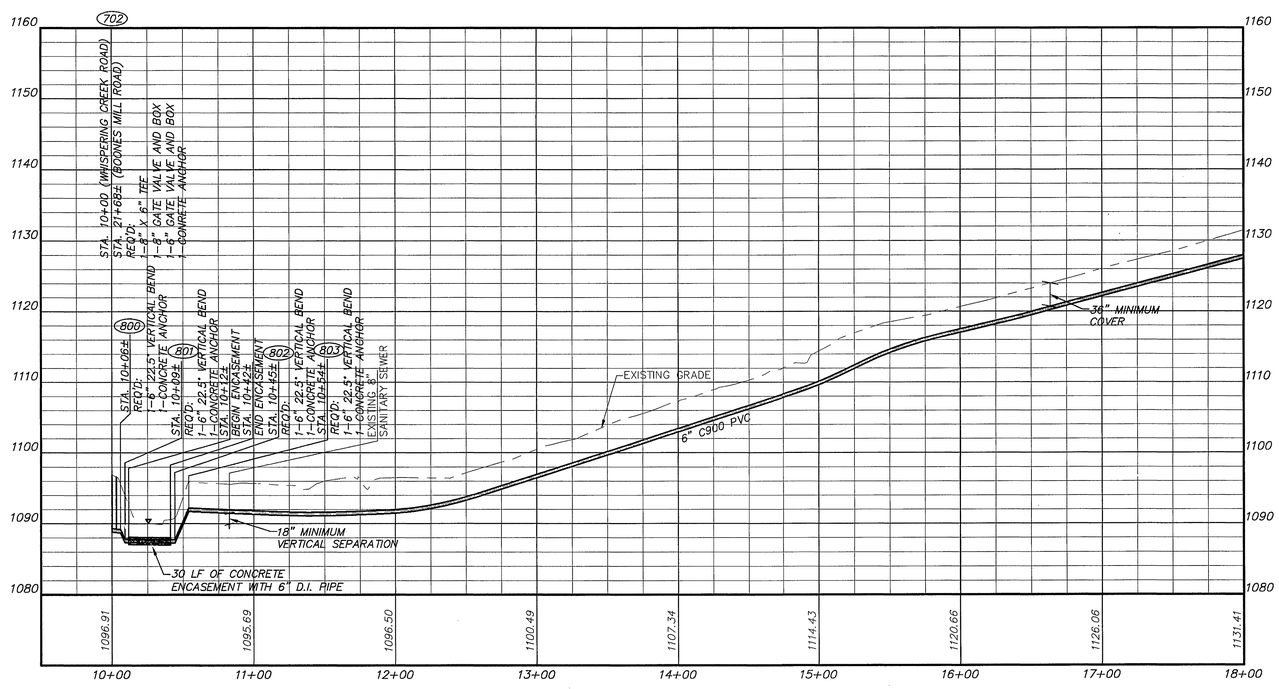
| | |
|---|---|
| PROJECT NO. | 20080815 |
| G.L. NO. | 297-03-A3.9 |
| FILE NO. | G-12675 |
| DATE: | 7/31/09 |
| DRAWN BY: | WCH |
| CHECKED BY: | BLC |

HURT & PROFFITT

SHEET NO.
**WL-800.00**

Mar 14, 2012 – 10:36am V:\LandProjects\20080815\dwg\Asbuilts-WL\ASBUILT-P_P-Water.dwg