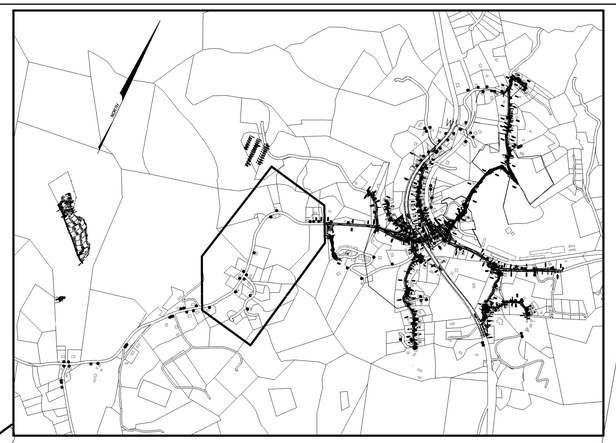

VICINITY MAP
N.T.S.

NOTE: ALL METERS ON THIS SHEET WILL BE REPLACED. NO MODIFICATIONS TO METER BOXES ARE REQUIRED. NO SERVICE LINES WILL BE REPLACED.

1	8/28/09	VDH COMMENTS
2	9/3/09	OWNER COMMENTS
4	3/14/12	ASBUILTS

*ENGINEERING >> SURVEYING >> PLANNING
HURT & PROFFITT
INCORPORATED
2524 LANGHORNE ROAD
LYNCHBURG VA 24501
800.242.4906 TOLL FREE
434.847.7796 MAIN
434.847.0047 FAX

METER MAP 2-ASBUILT

FOR

TOWN OF BOONES MILL WATER SYSTEM REPLACEMENT, VOLUME 1
TOWN OF BOONES MILL, BOONE DISTRICT, FRANKLIN COUNTY, VA

PROJECT NO.	20080815
G.L. NO.	297-03-A3.9
FILE NO.	G-12675
DATE:	8/28/09
DRAWN BY:	WCH
CHECKED BY:	BLC

HURT & PROFFITT

SHEET NO.
M2.0

Mar 14, 2012 – 10:39am V:\LongProjects\20080815\dwg\Asbuilts-WL\ASBUILT-Water Meter.dwg