


Mar 14, 2012 - 10:39am V:\LandProjects\20080815\dwg\Asbults-WL\ASBULT-Water Meter.dwg

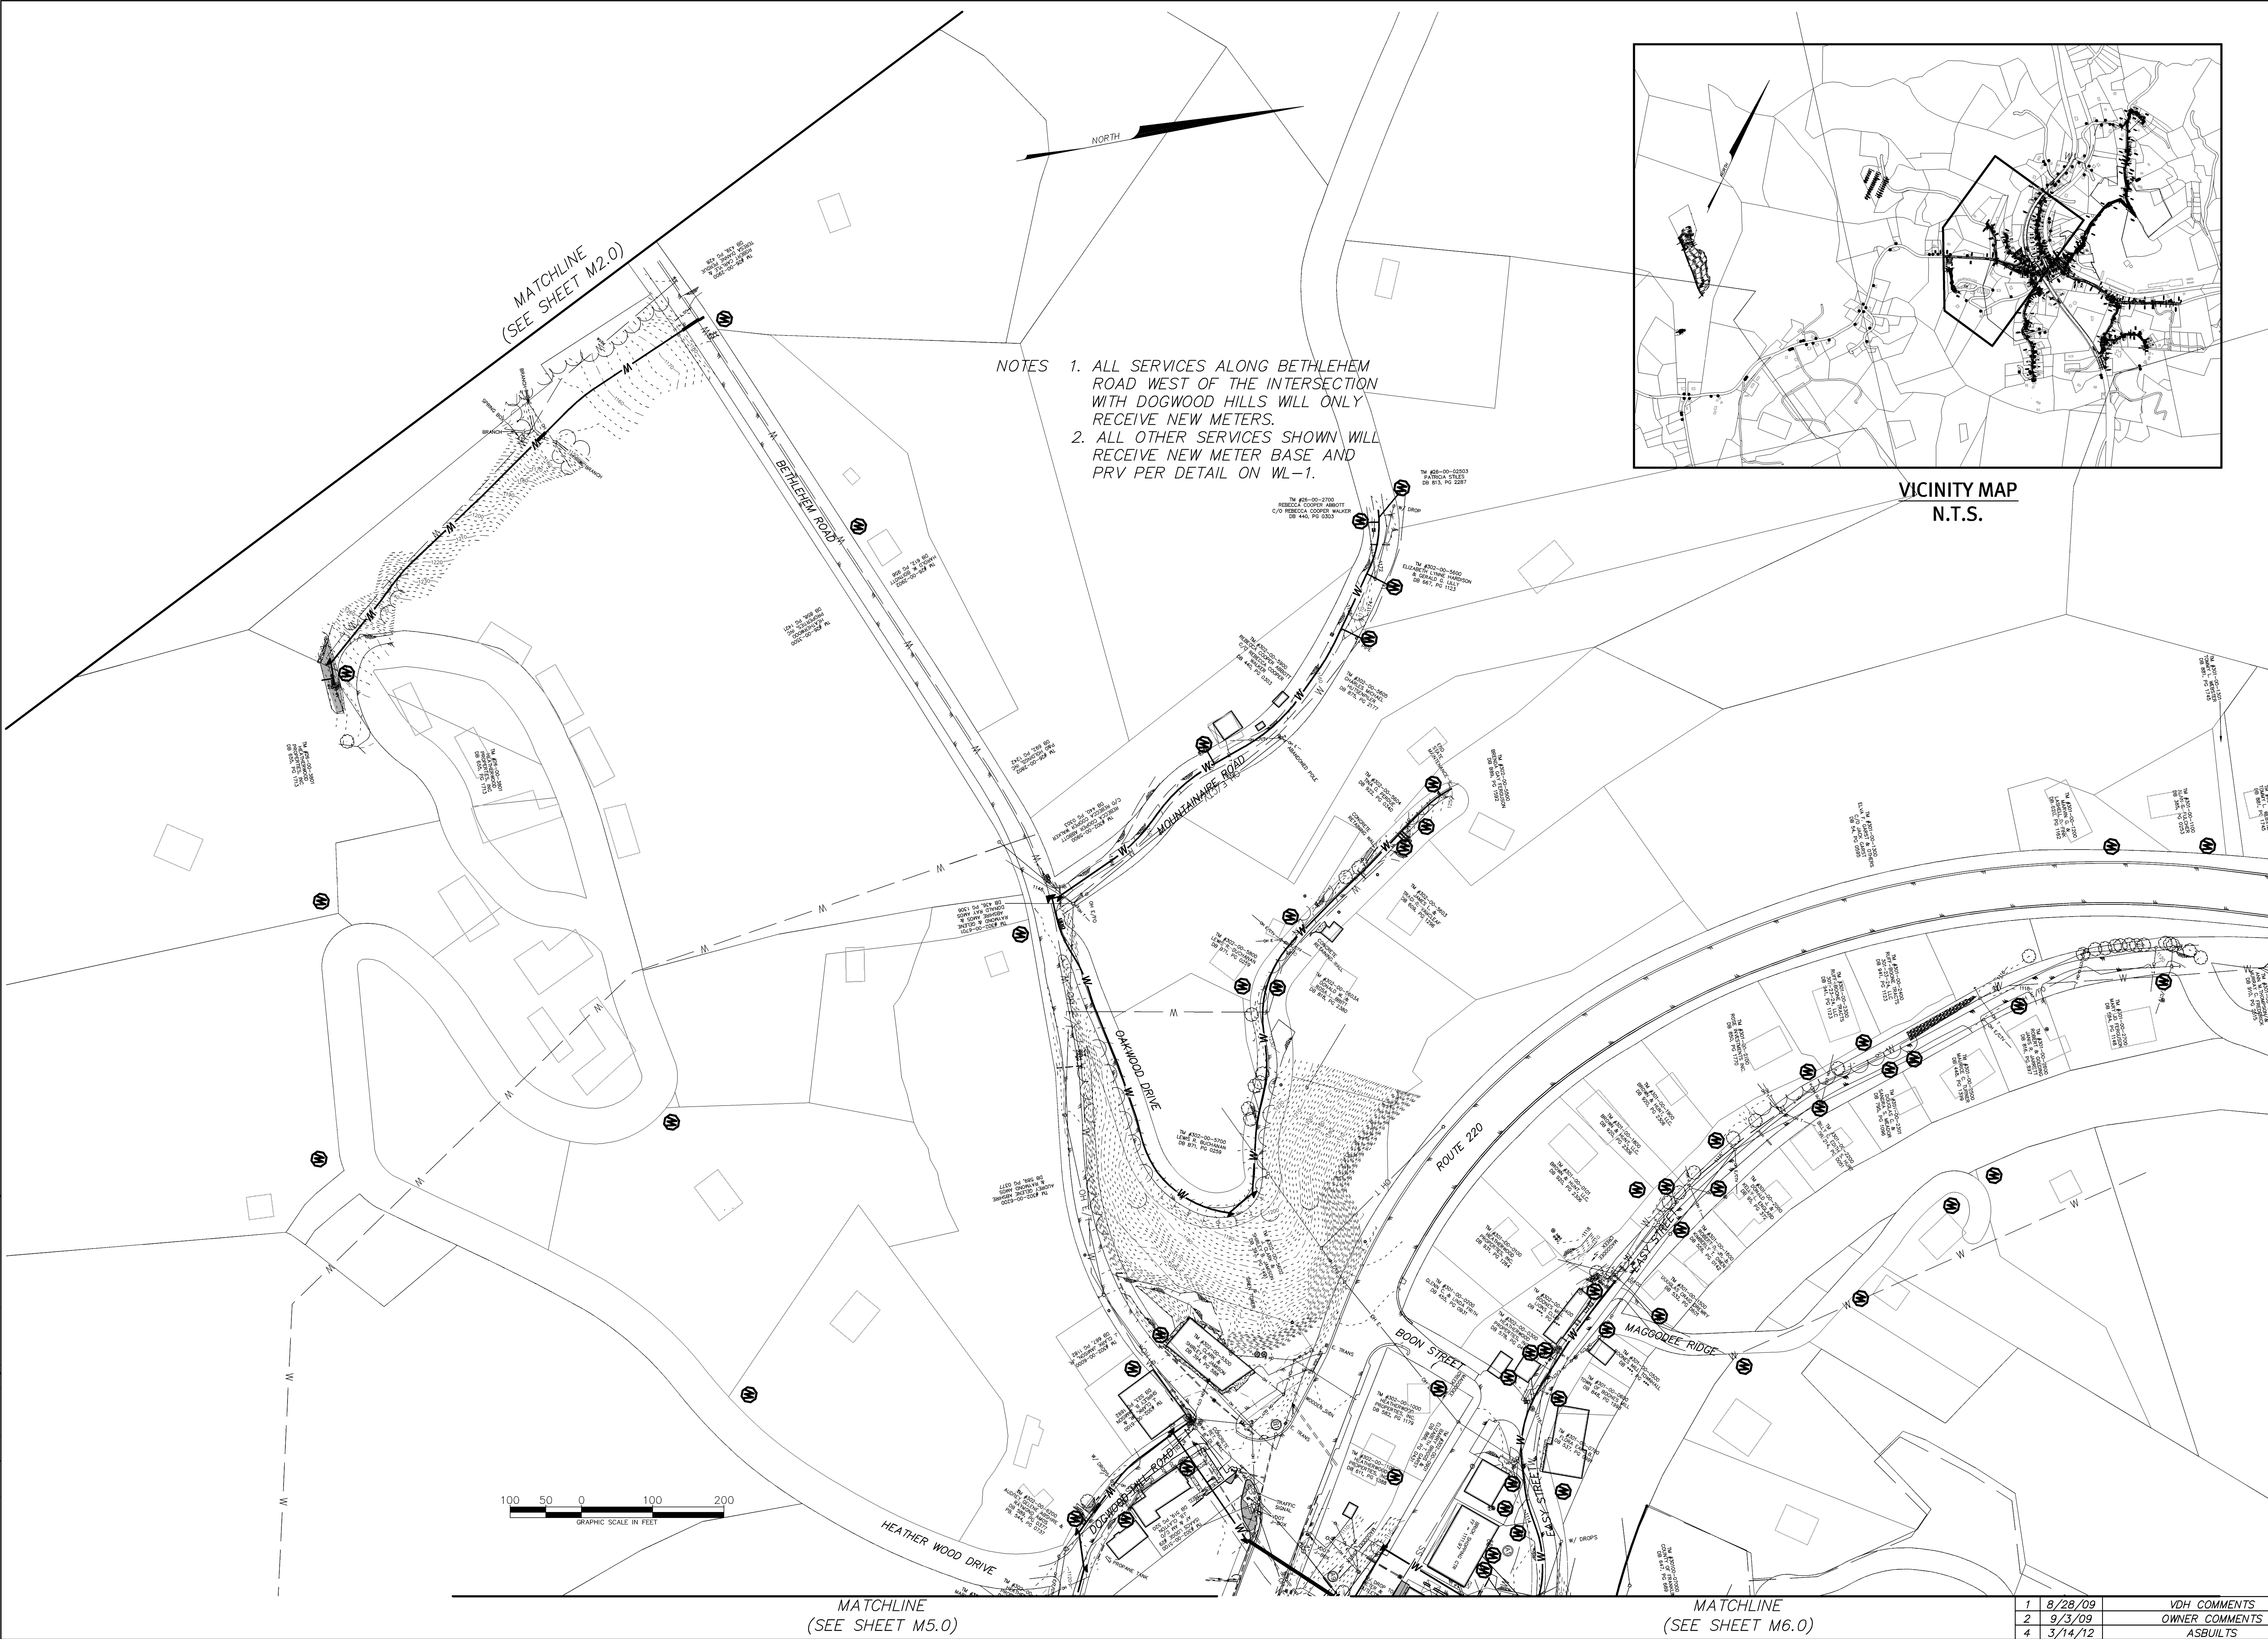

VICINITY MAP
N.T.S.

MATCHLINE
(SEE SHEET M4.0)

METER MAP 3-ASBULT
FOR
TOWN OF BOONES MILL WATER SYSTEM REPLACEMENT, VOLUME 1
TOWN OF BOONES MILL, BOONE DISTRICT, FRANKLIN COUNTY, VA

PROJECT NO. 20080815
G.L. NO. 297-03-A3.9
FILE NO. G-12675
DATE: 8/28/09
DRAWN BY: WCH
CHECKED BY: BLC

HURT & PROFFITT

SHEET NO.
M3.0

HURT & PROFFITT
INCORPORATED
2524 LANGHORNE ROAD
LYNCHBURG VA 24501
800.242.4906 TOLL FREE
434.847.7796 MAIN
434.847.0047 FAX

*ENGINEERING >> SURVEYING >> PLANNING



1	8/28/09	VDH COMMENTS
2	9/3/09	OWNER COMMENTS
4	3/14/12	ASBULTS