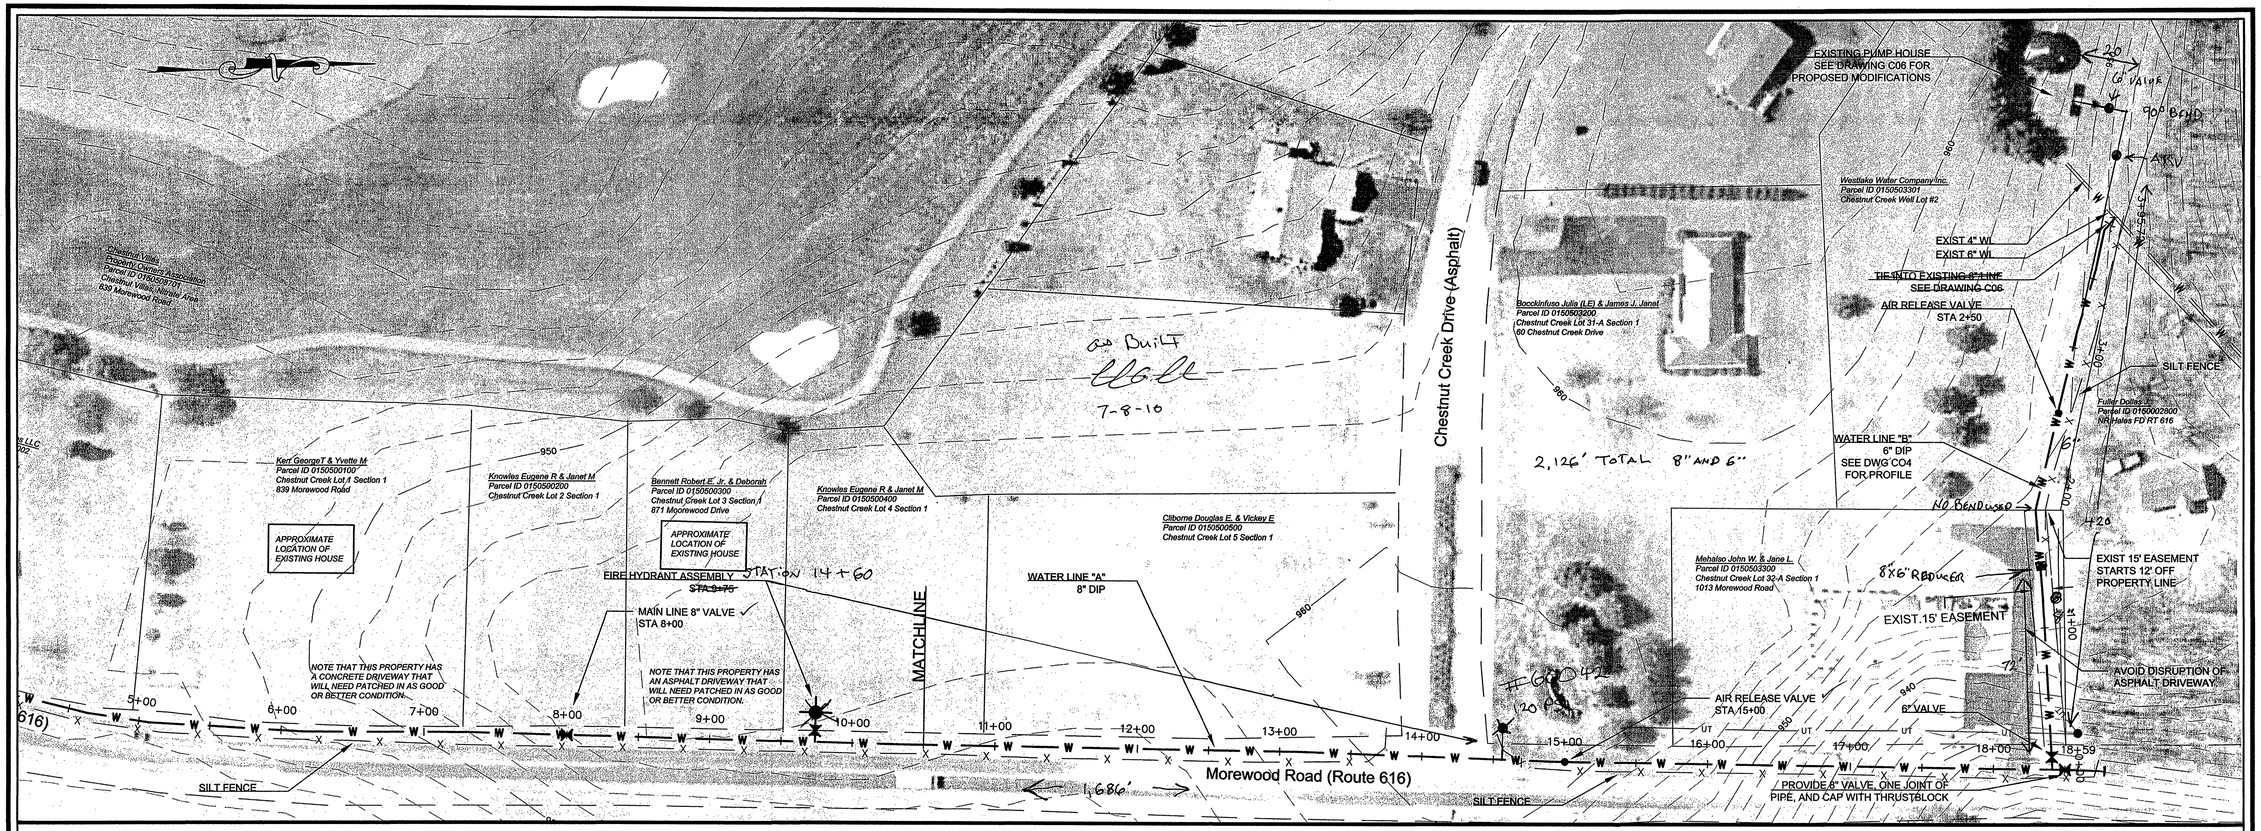

WATER LINE "A" PROFILE

SCALE: HORZ. 1" = 50' VERT. 1" = 10'

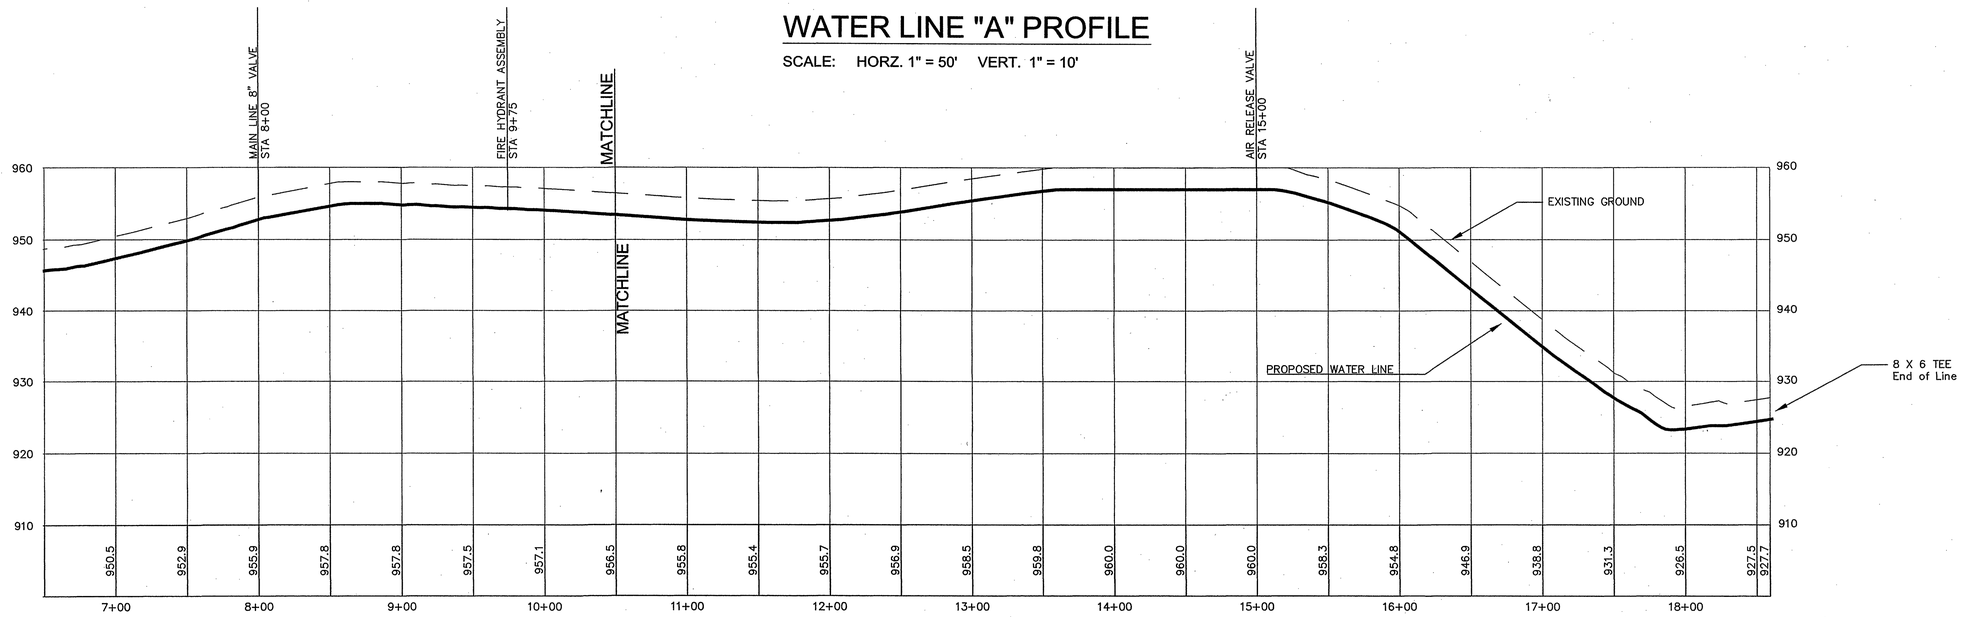

MAPPING IS ACCUMULATION OF GOOGLE MAPS TOPOGRAPHIC INFORMATION, FRANKLIN COUNTY GIS INFORMATION AND VARGIS IMAGERY. NO ACTUAL FIELD SURVEY WORK WAS COMPLETED.

WATER LINE IS 8" DIP, CLASS 50
WATER LINE TO BE BURIED A MINIMUM OF 36" TO TOP OF PIPE
MAINTAIN A MINIMUM OF 7.5' TO EDGE OF PAVEMENT

parker
DESIGN GROUP
ENGINEERS • SURVEYORS • PLANNERS • LANDSCAPE ARCHITECTS
816 Boulevard
Salem, Virginia 24153
Phone: 540-387-1153
Fax: 540-389-5767
www.parkerdg.com

These documents are the property of Parker Design Group(PDG) and may not be reproduced or used without the express permission of PDG. Any reuse of these documents without authorization of PDG will be at the sole risk of the individual or entity utilizing said documents.

COMMONWEALTH OF VIRGINIA
GREGORY S. TAYLOR
Lic. No. 038009
3/31/10
PROFESSIONAL ENGINEER

Westlake Water Company
Water System Modifications
Franklin County, Virginia

REVISIONS:

DESIGNED BY:	GST
DRAWN BY:	GST
CHECKED BY:	GST
SCALE:	As Noted
DATE:	March 30, 2010

SHEET TITLE:

Water Line 2nd Section

C03
03 OF 07
PROJECT NUMBER:
09-0154-01