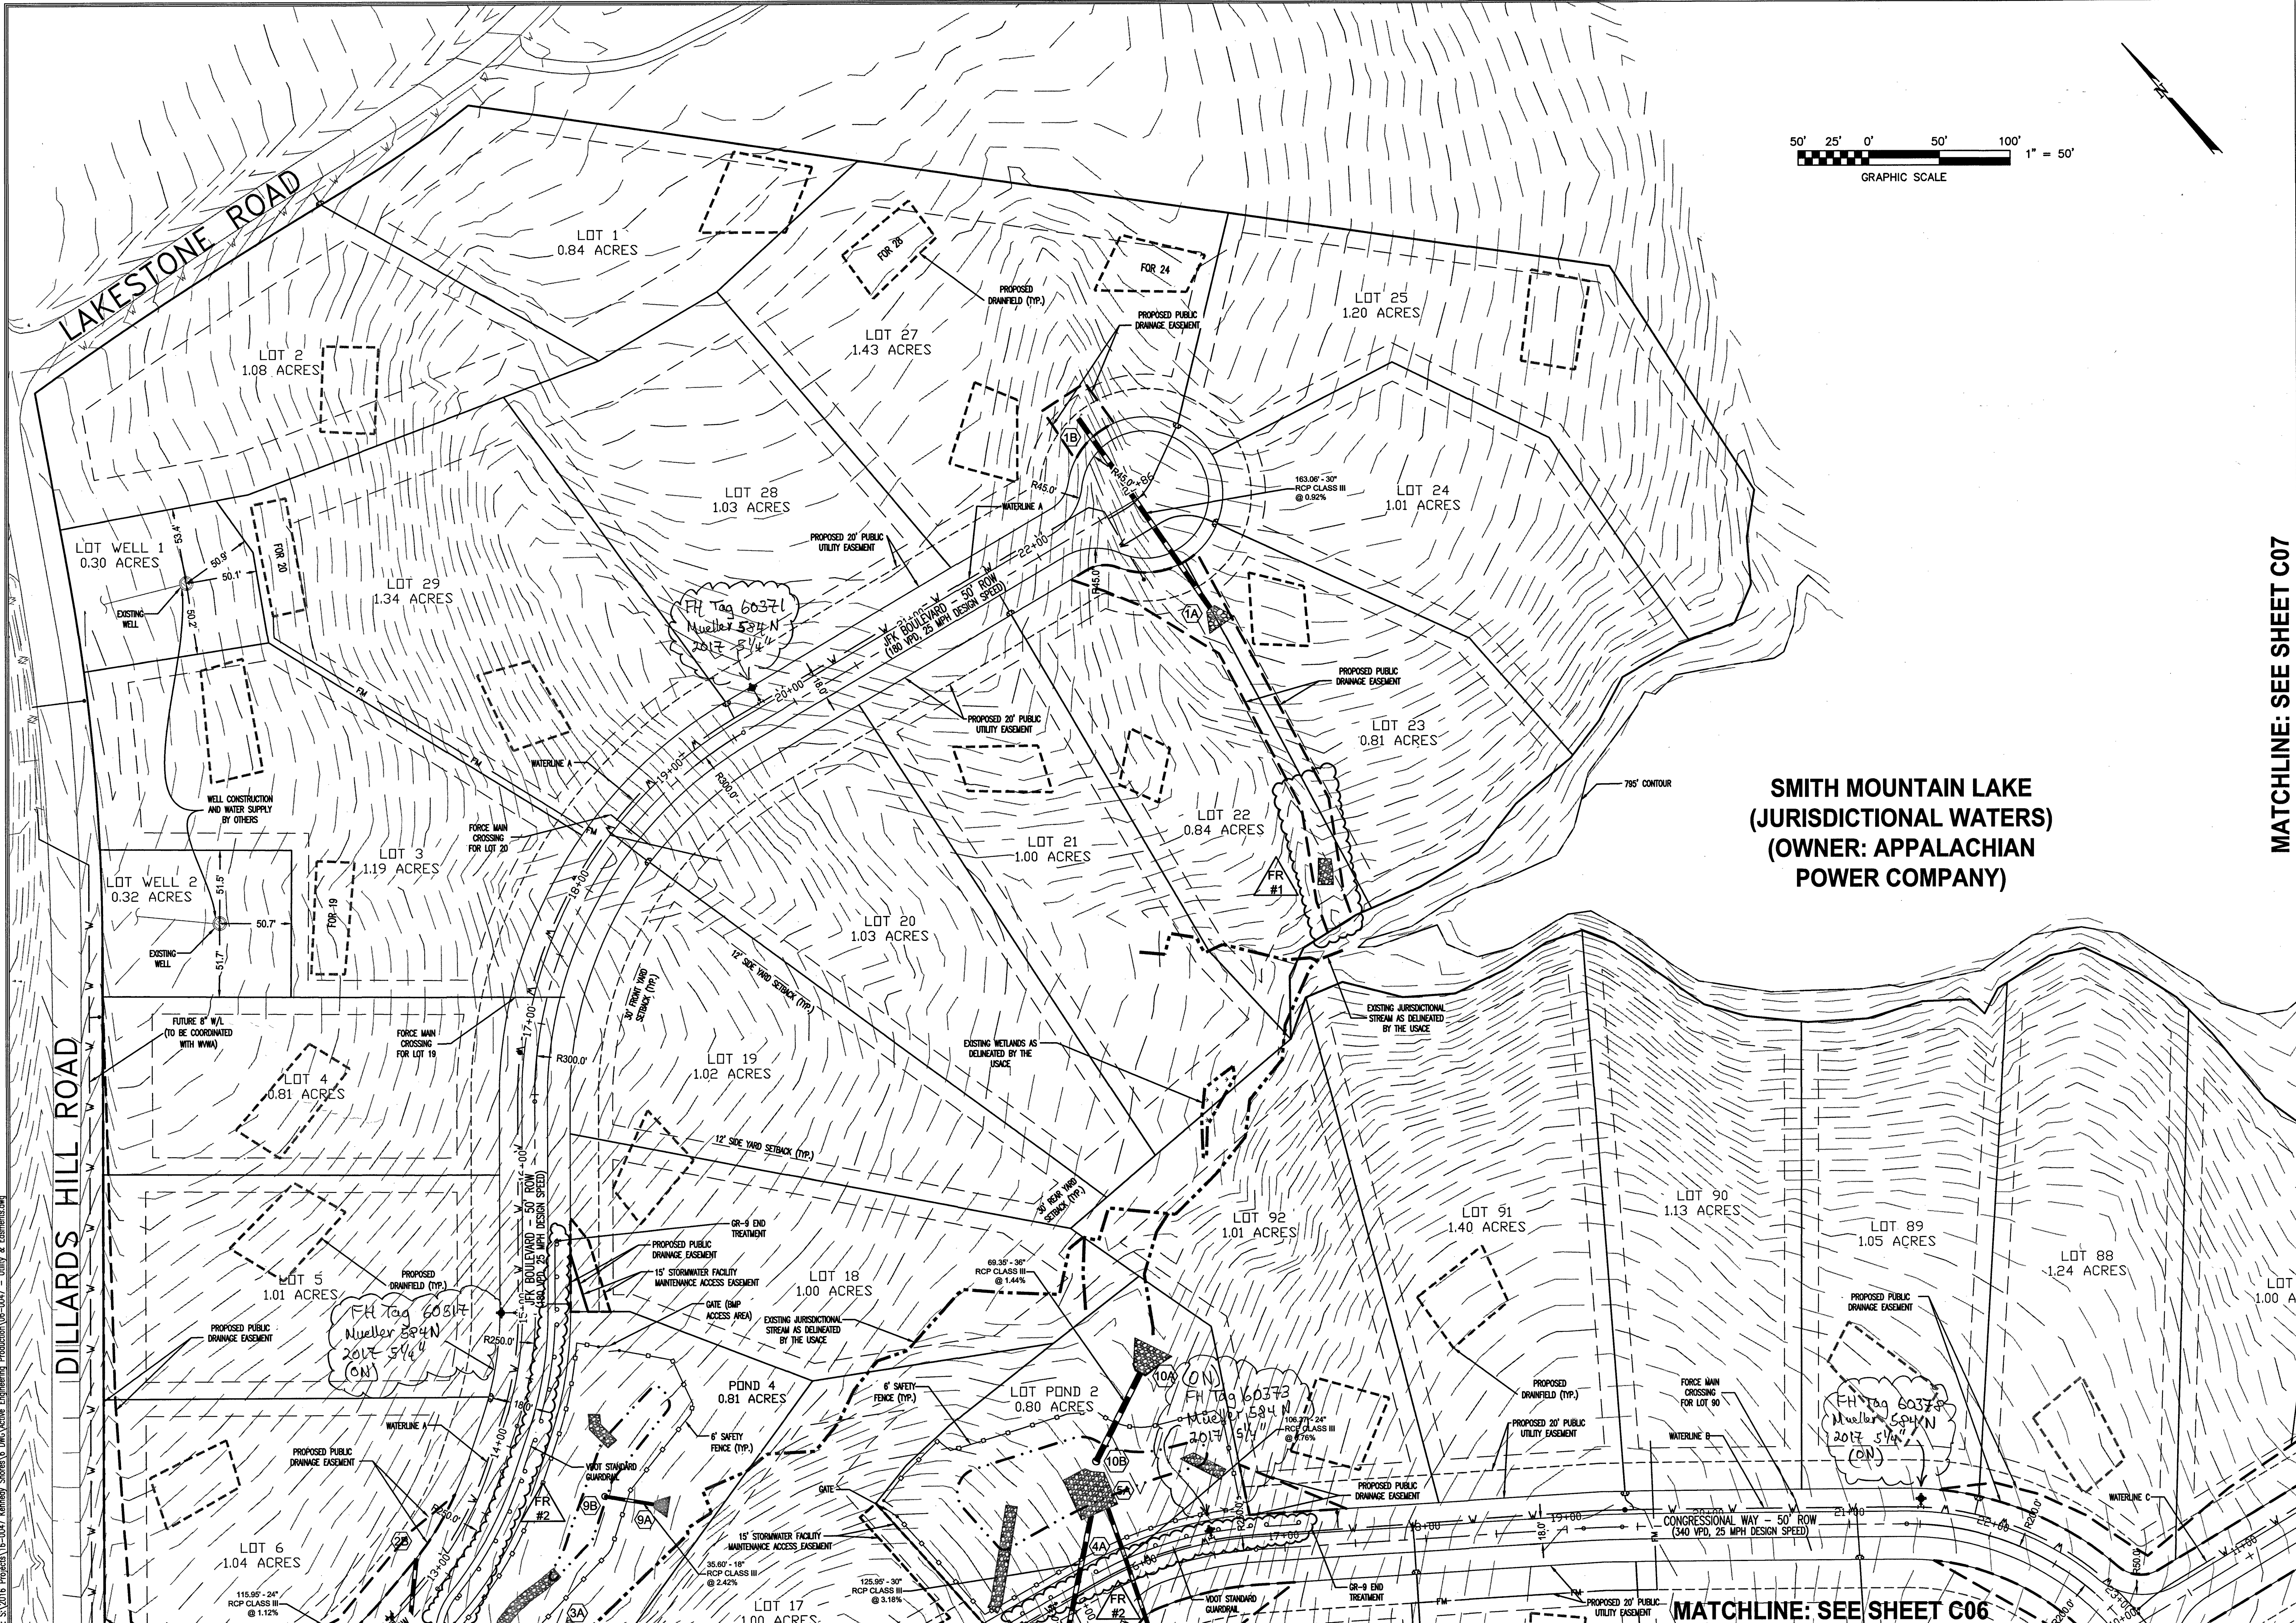


**SMITH MOUNTAIN LAKE
(JURISDICTIONAL WATERS)
(OWNER: APPALACHIAN
POWER COMPANY)**

parker
DESIGN GROUP
2122 Carolina Ave. SW
Roanoke, VA 24014
Ph: 540-387-1153
Fax: 540-389-5767
1915-B W. Cary Street
Richmond, VA 23220
Phone: 804-358-2947
Fax: 804-359-9645
www.parkerdgd.com

COMMONWEALTH OF VIRGINIA
SHELDON R. BOWER
Lic. No. 039439
08/09/2017
PROFESSIONAL ENGINEER

MATCHLINE: SEE SHEET C07

**KENNEDY SHORES
SUBDIVISION DEVELOPMENT PLAN**
Tax # 0510001500
Franklin County, Virginia

REVISIONS:

2/10/2017	- 1ST SUB COMMENTS
3/21/2017	- 2ND SUB COMMENTS
4/14/2017	- 3RD SUB COMMENTS
6/23/2017	- FIELD REVISION #1
7/6/2017	- FIELD REVISION #2
8/4/2017	- FIELD REVISION #3
8/9/2017	- FIELD REVISION #4

DESIGNED BY: JMM/SRB
DRAWN BY: JMM/JLK
CHECKED BY: SRB

DATE:
6 JANUARY, 2017
SHEET TITLE:
LAYOUT PLAN
SCALE:
1" = 50'
SHEET NO.

C05

MATCHLINE: SEE SHEET C06

Path: S:\2016 Projects\16-007 Kennedy Shores\6 DWG\Utility Engineering Production\06-0047 - Utility & Easements.dwg