
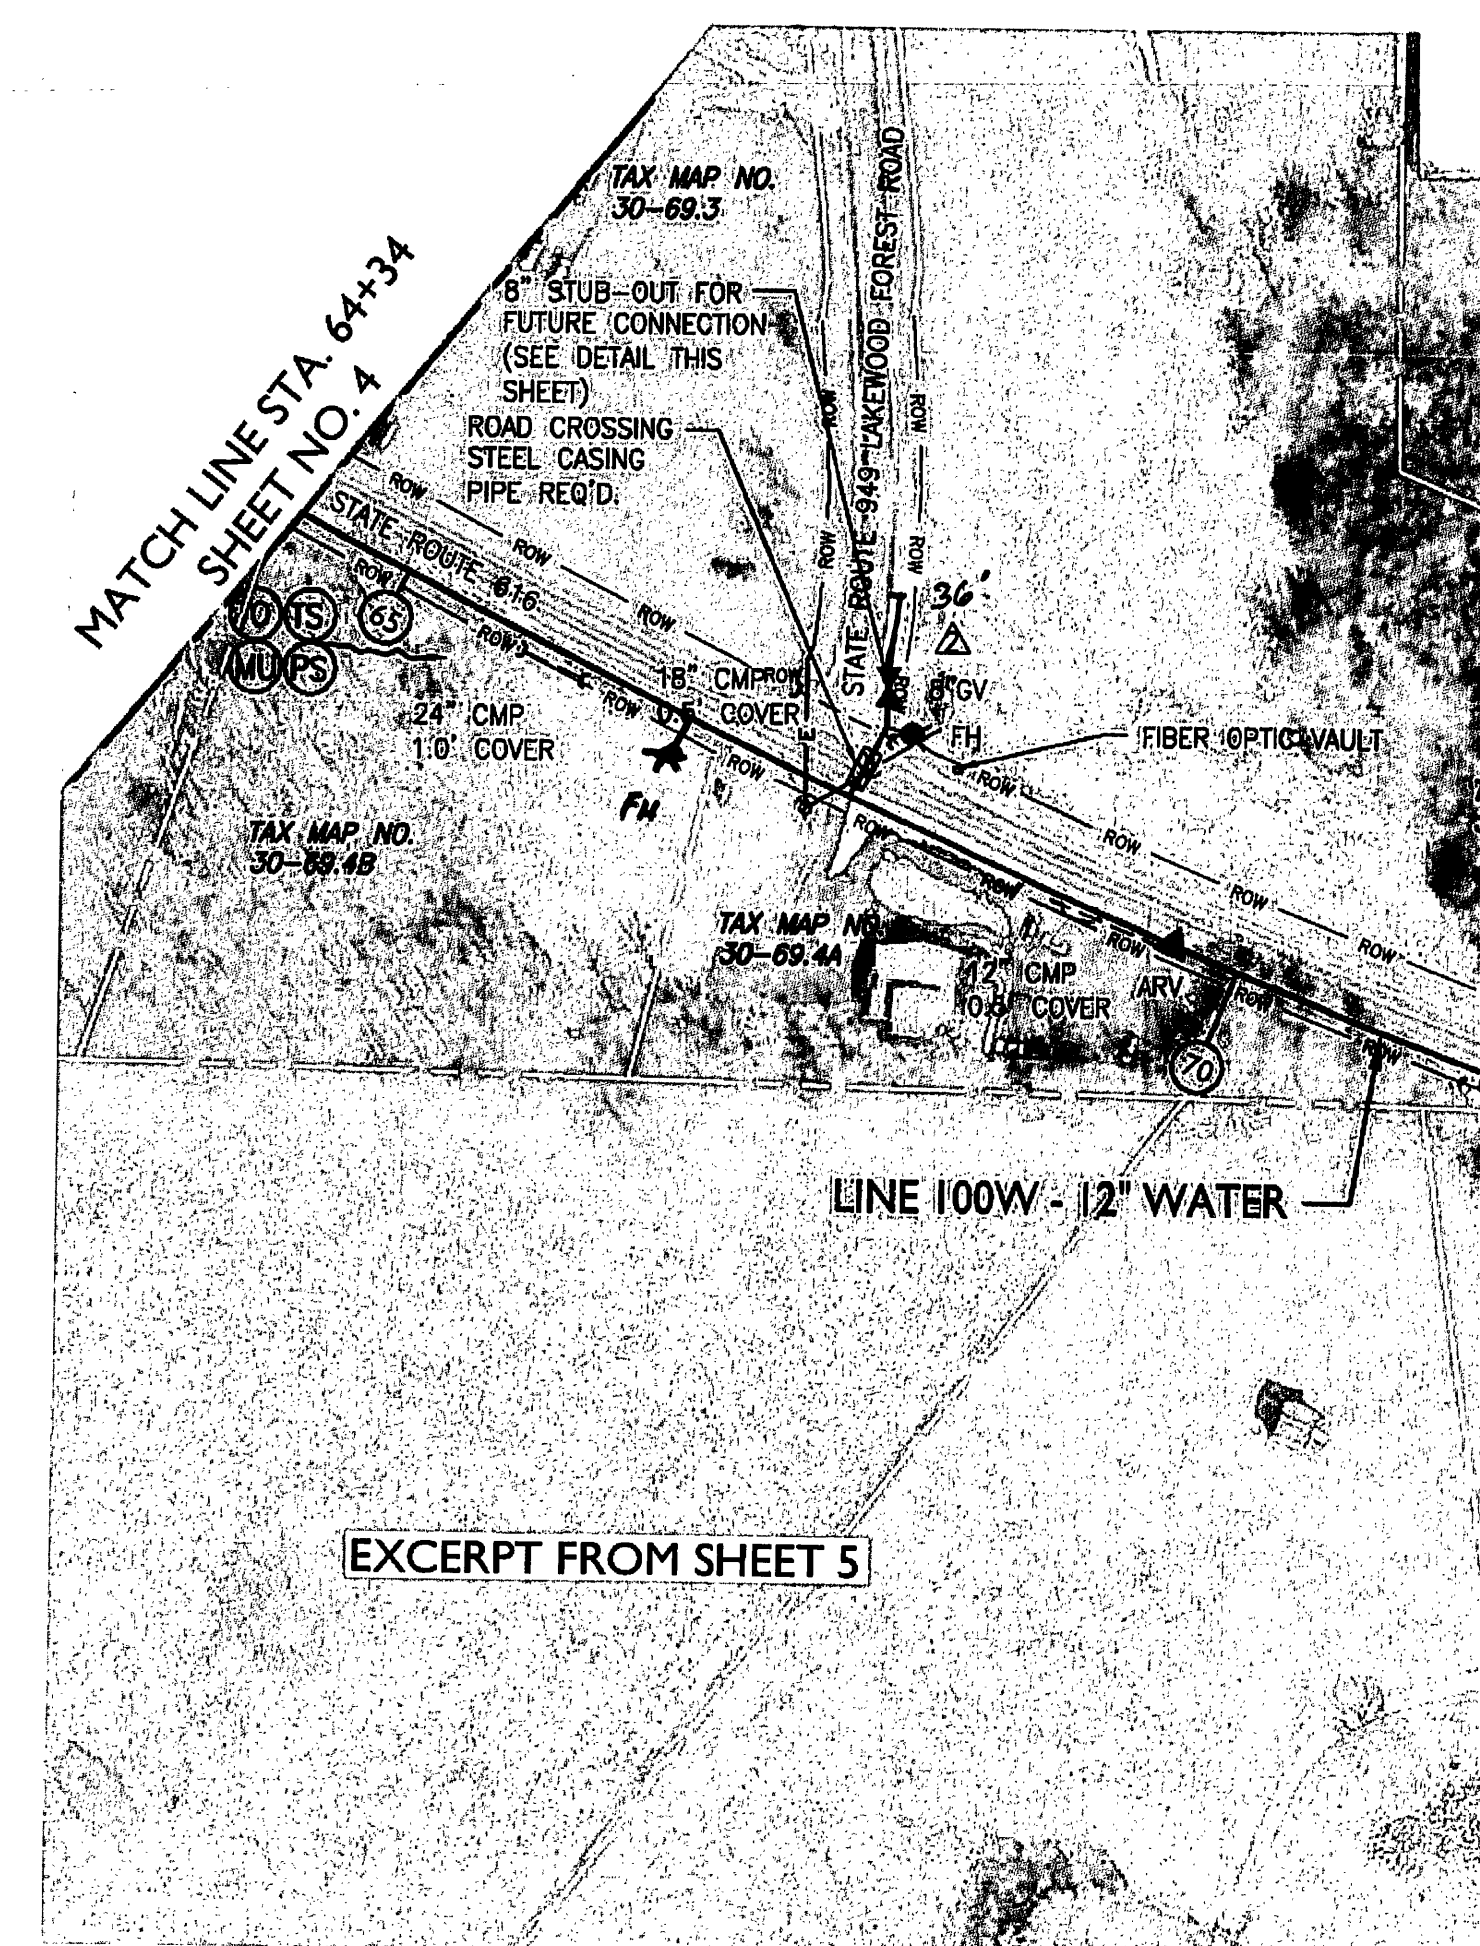
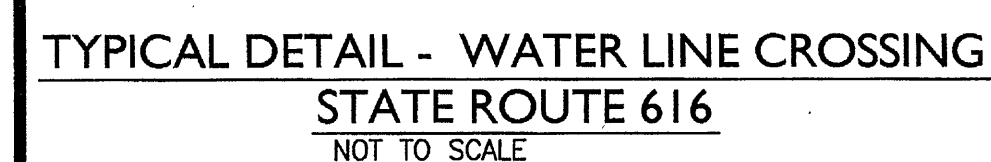


SCALE:  
1" = 100' HORIZONTAL  
1" = 10' VERTICAL

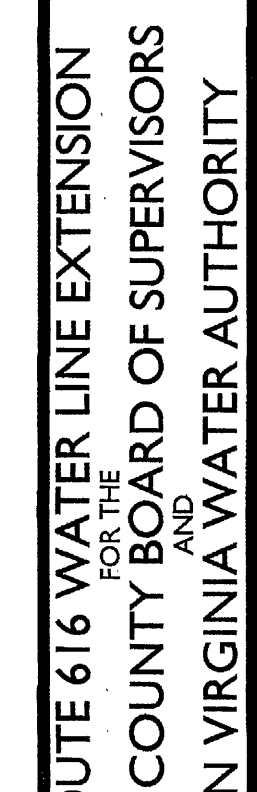

PLAN &amp; PROFILE - LINE 100W