

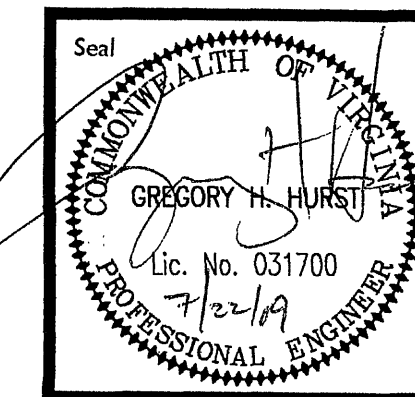
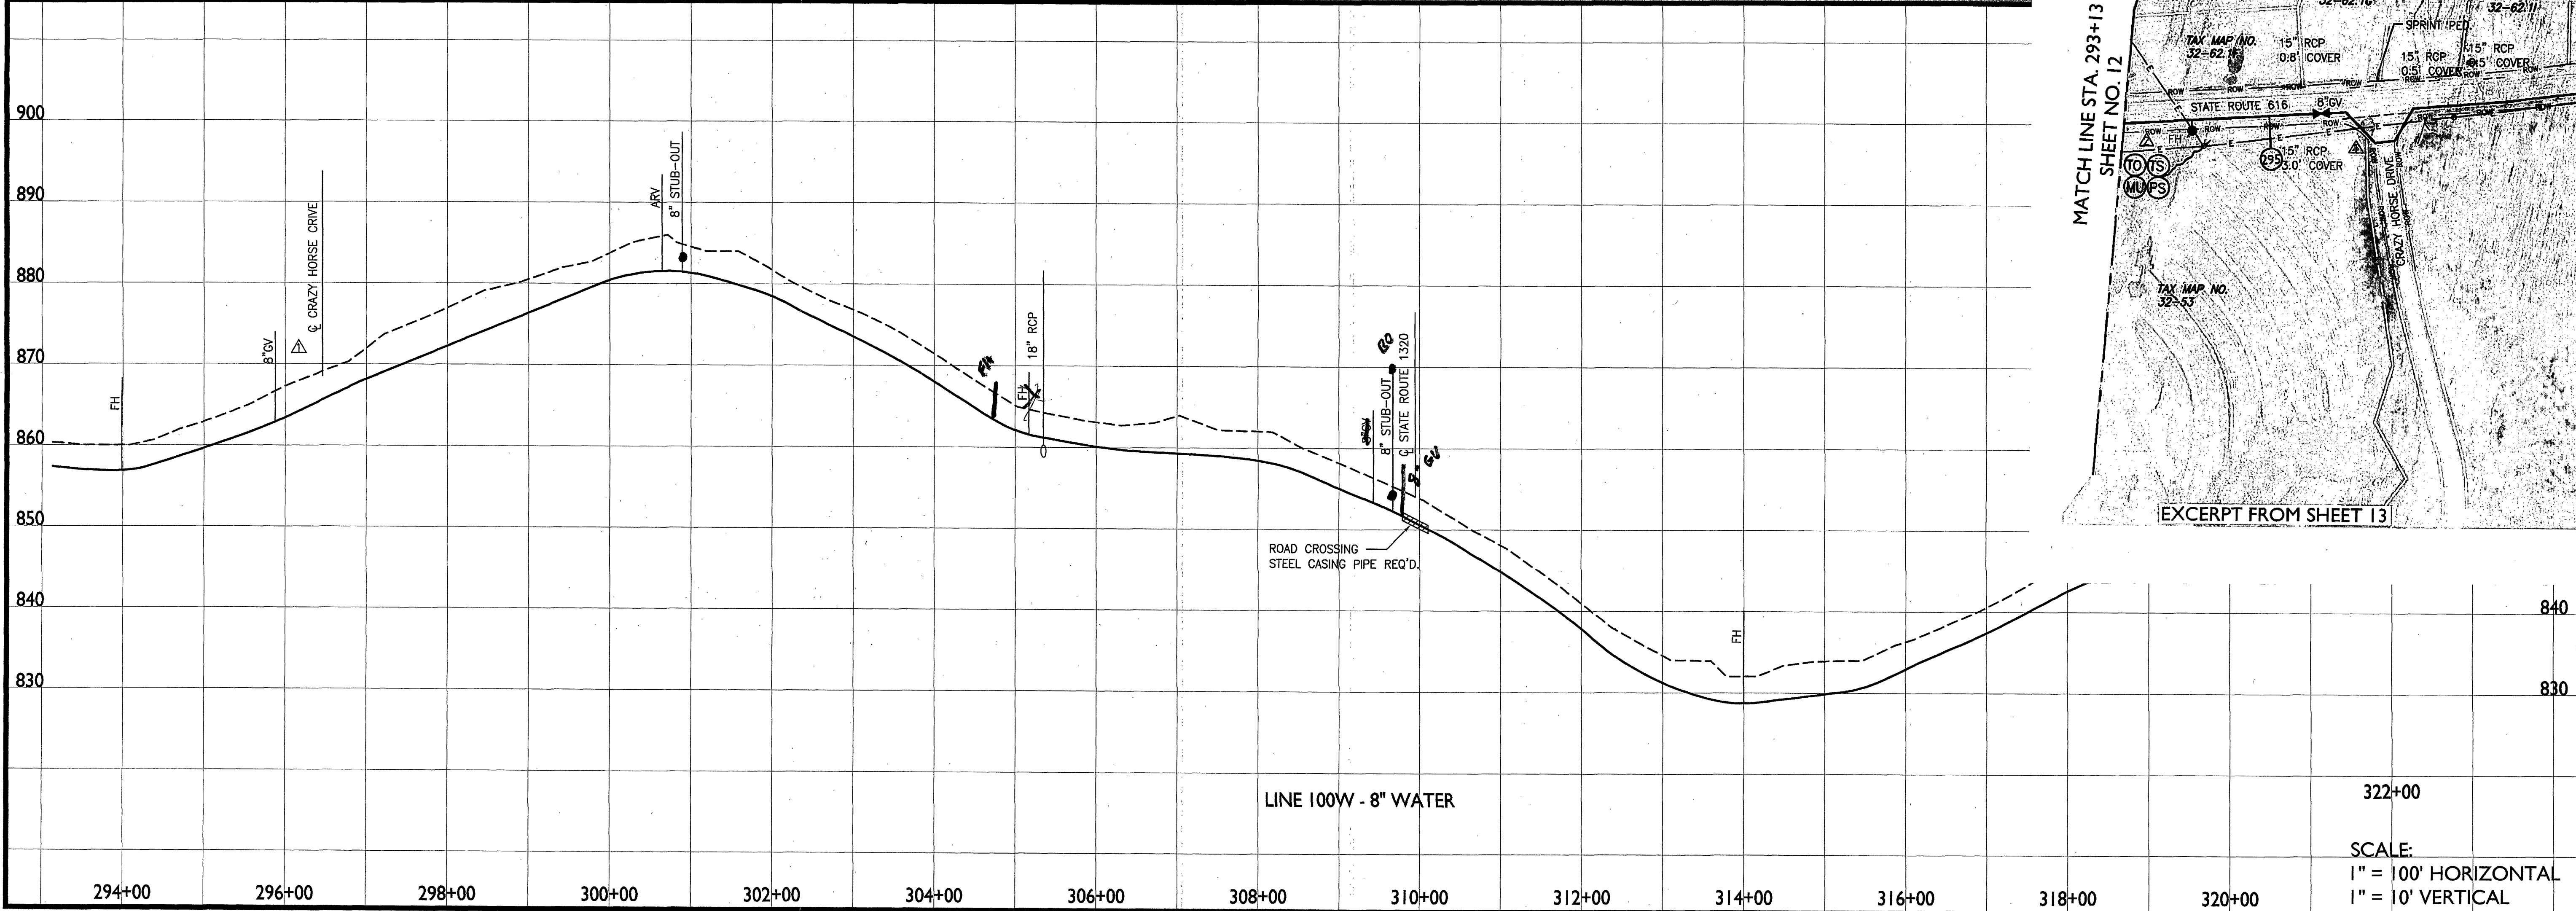
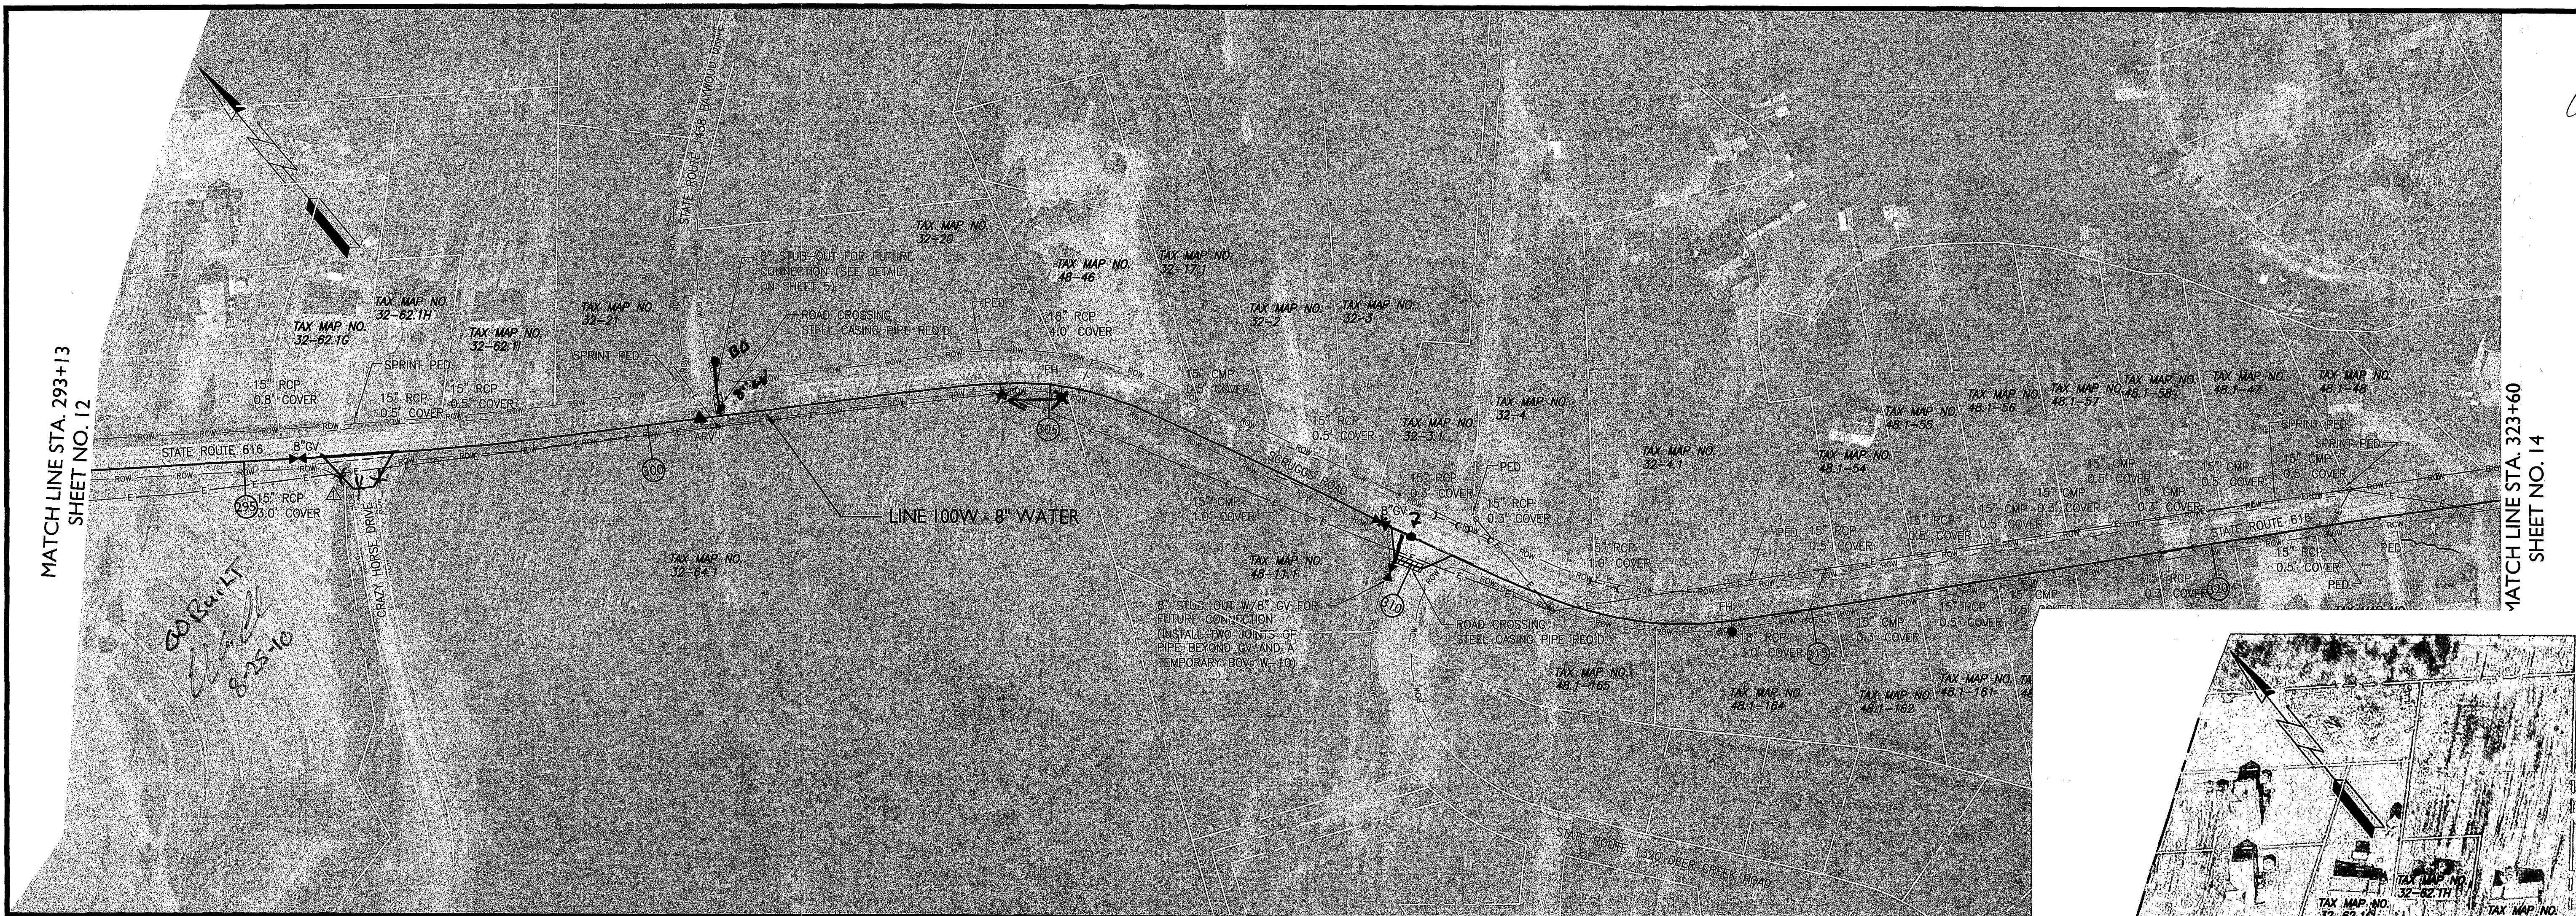


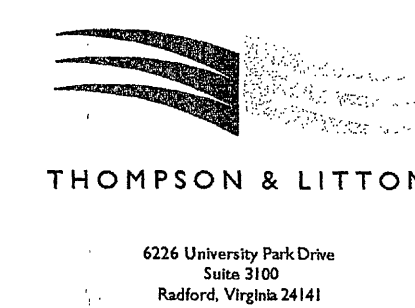

E 616 WATER LINE EXTENSION
FOR THE
COUNTY BOARD OF SUPERVISORS
AND
VIRGINIA WATER AUTHORITY

PLAN & PROFILE - LINE 100W

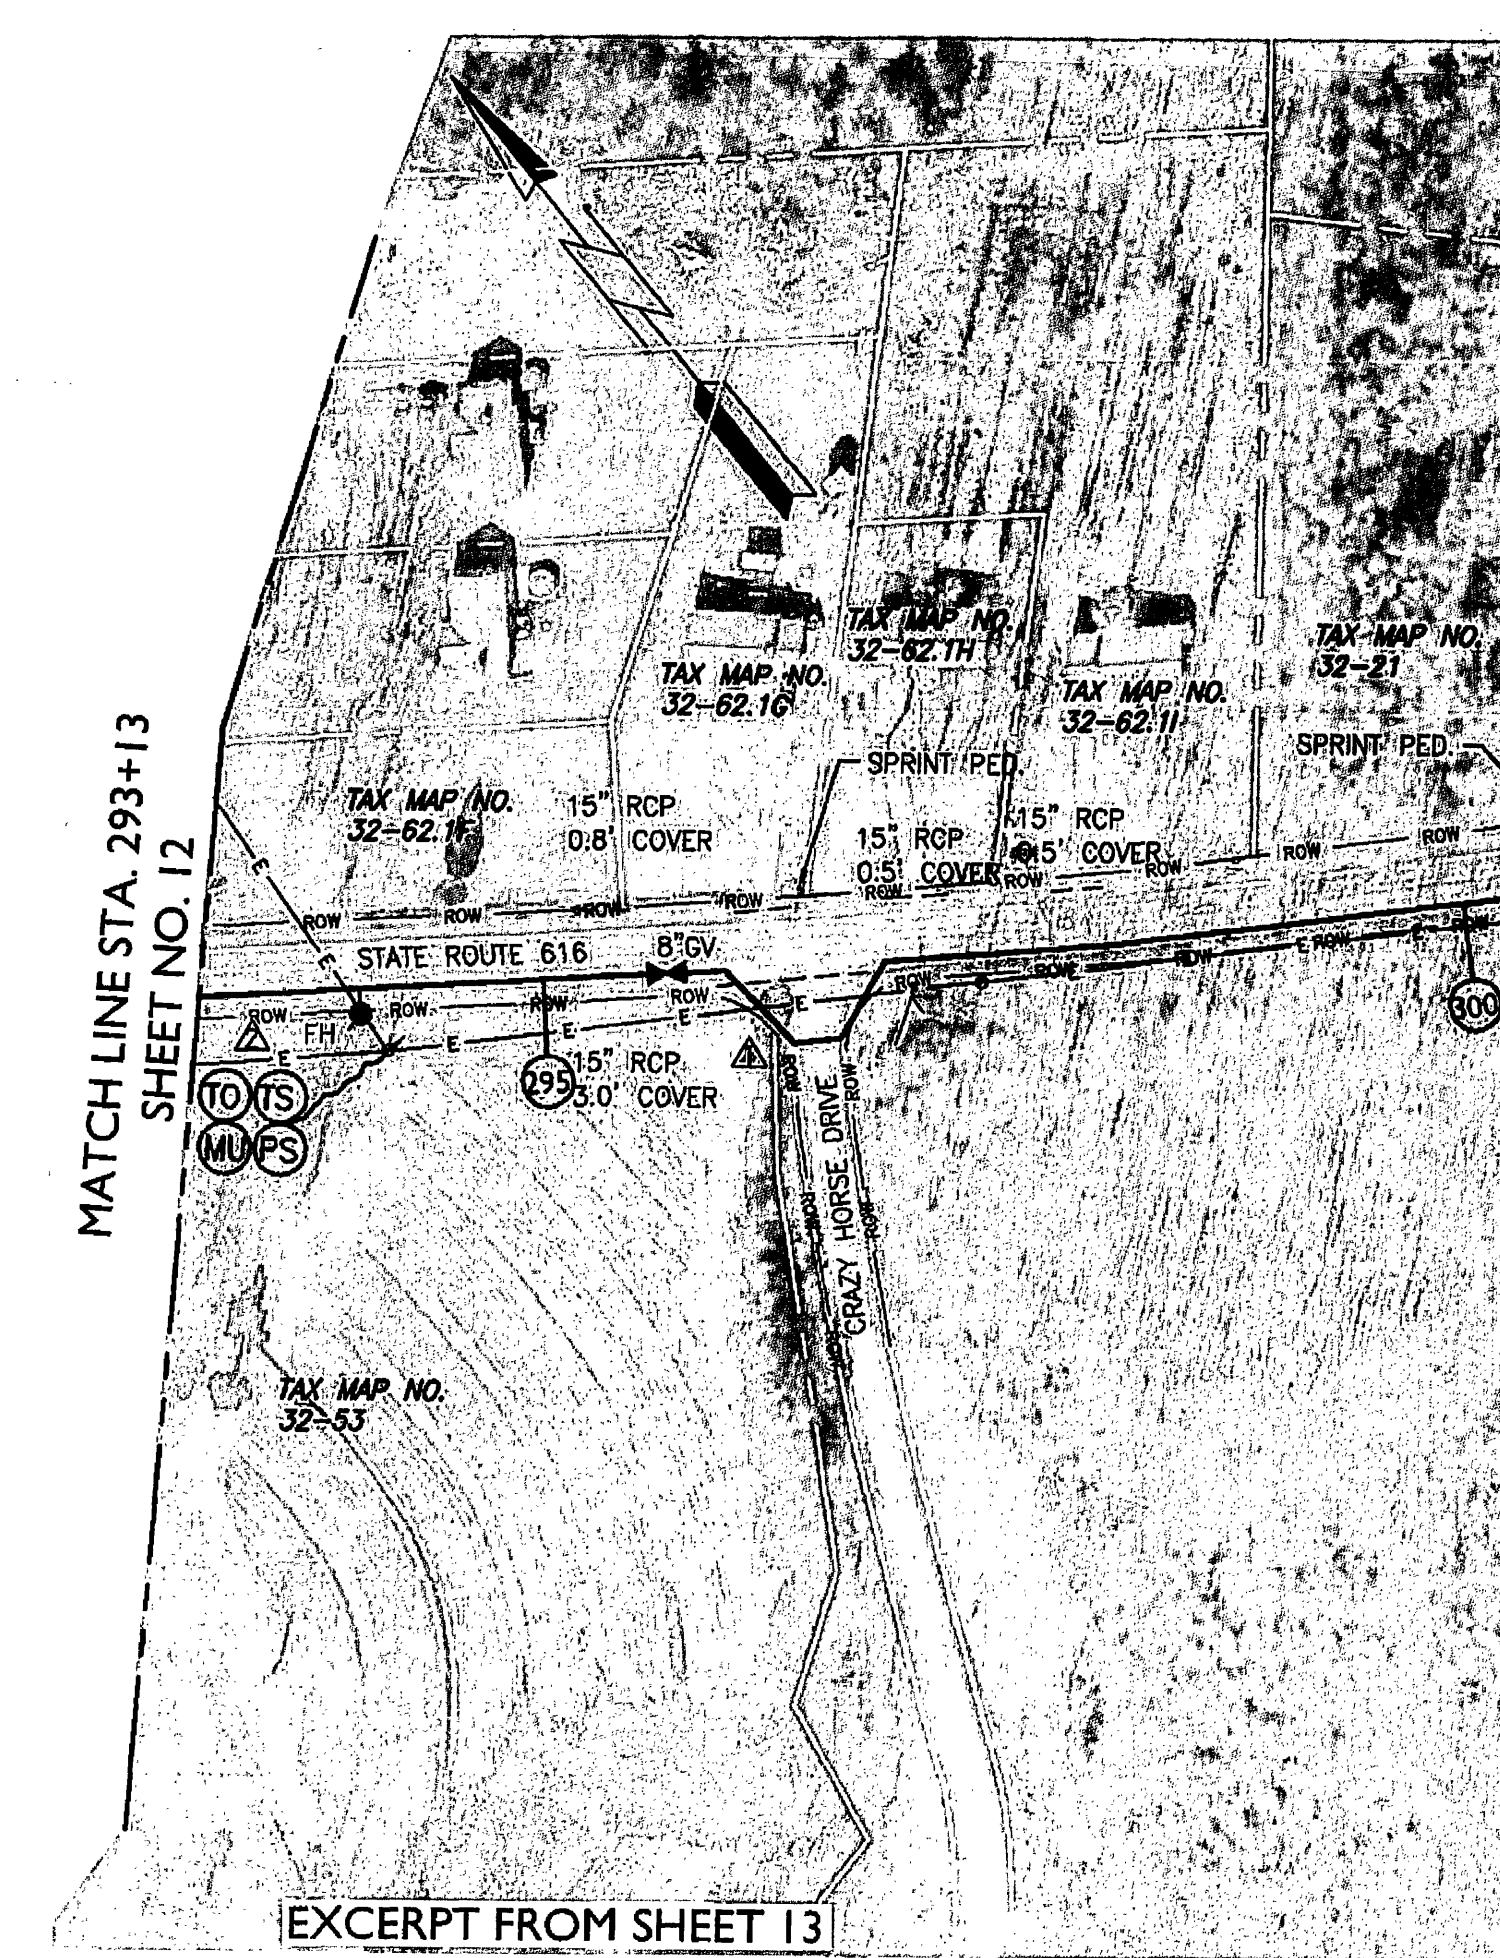

Sheet No.
13