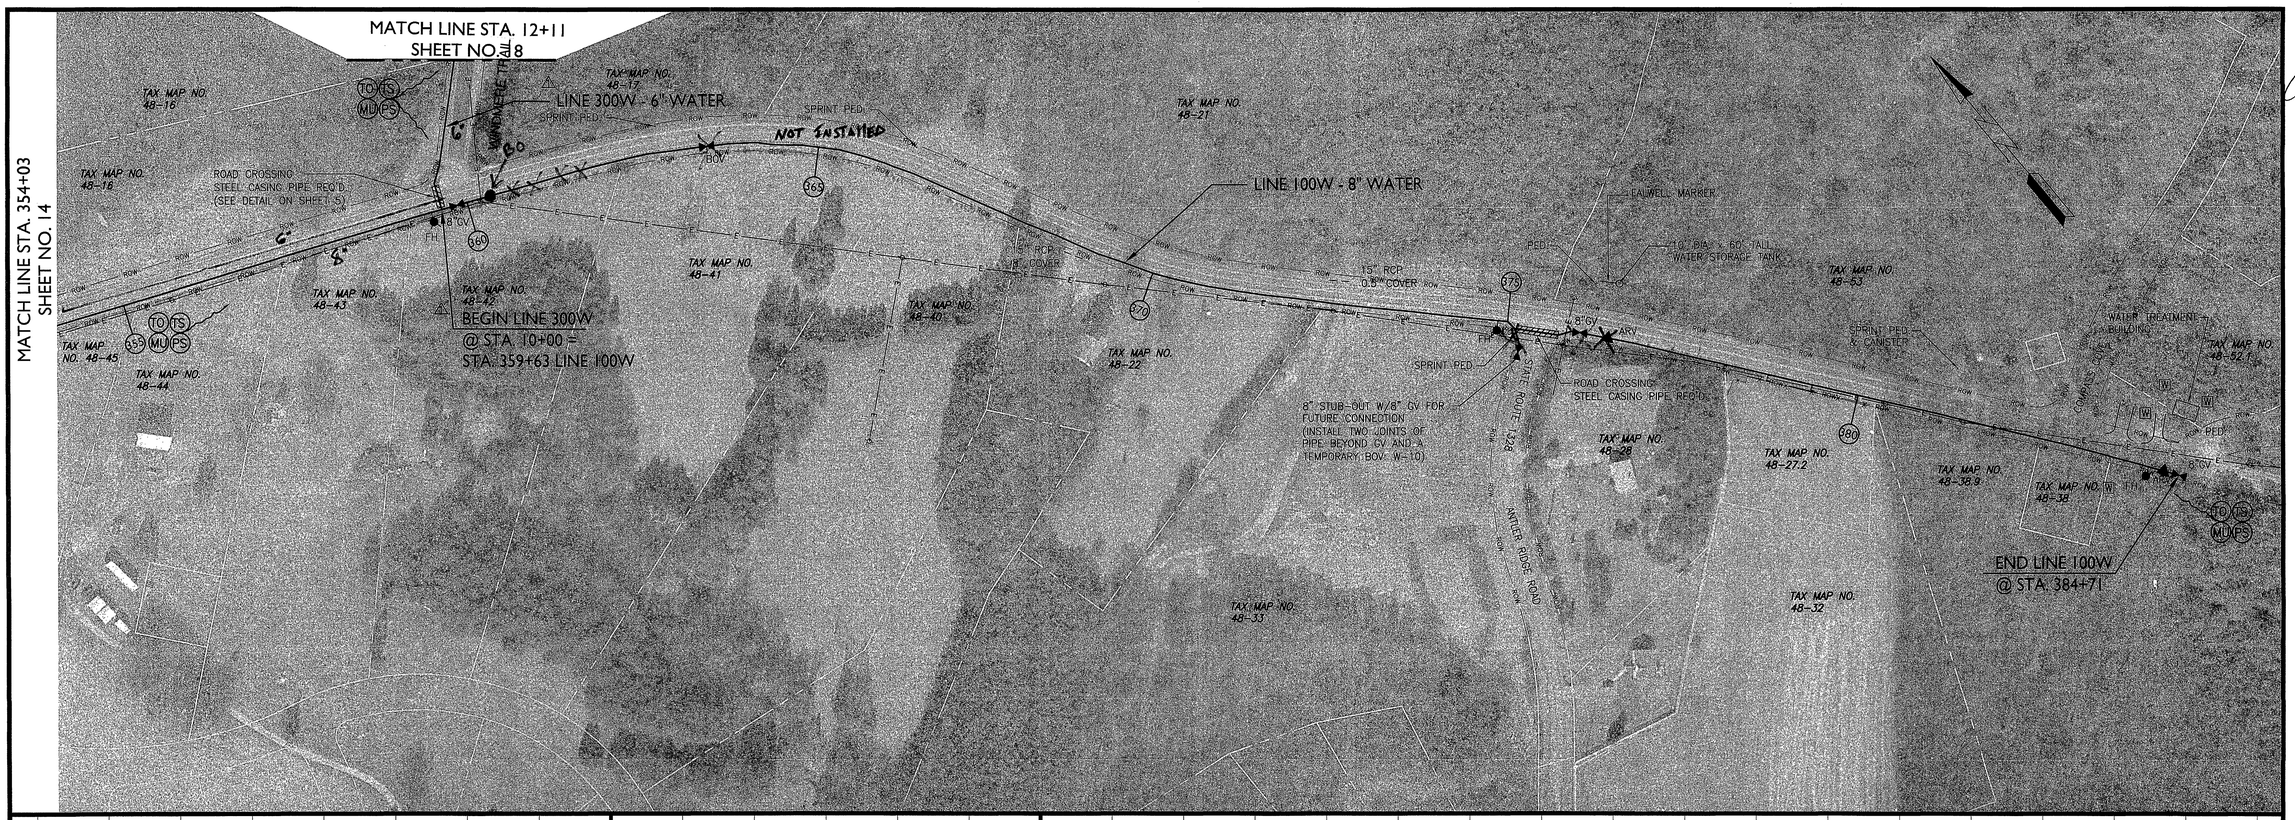

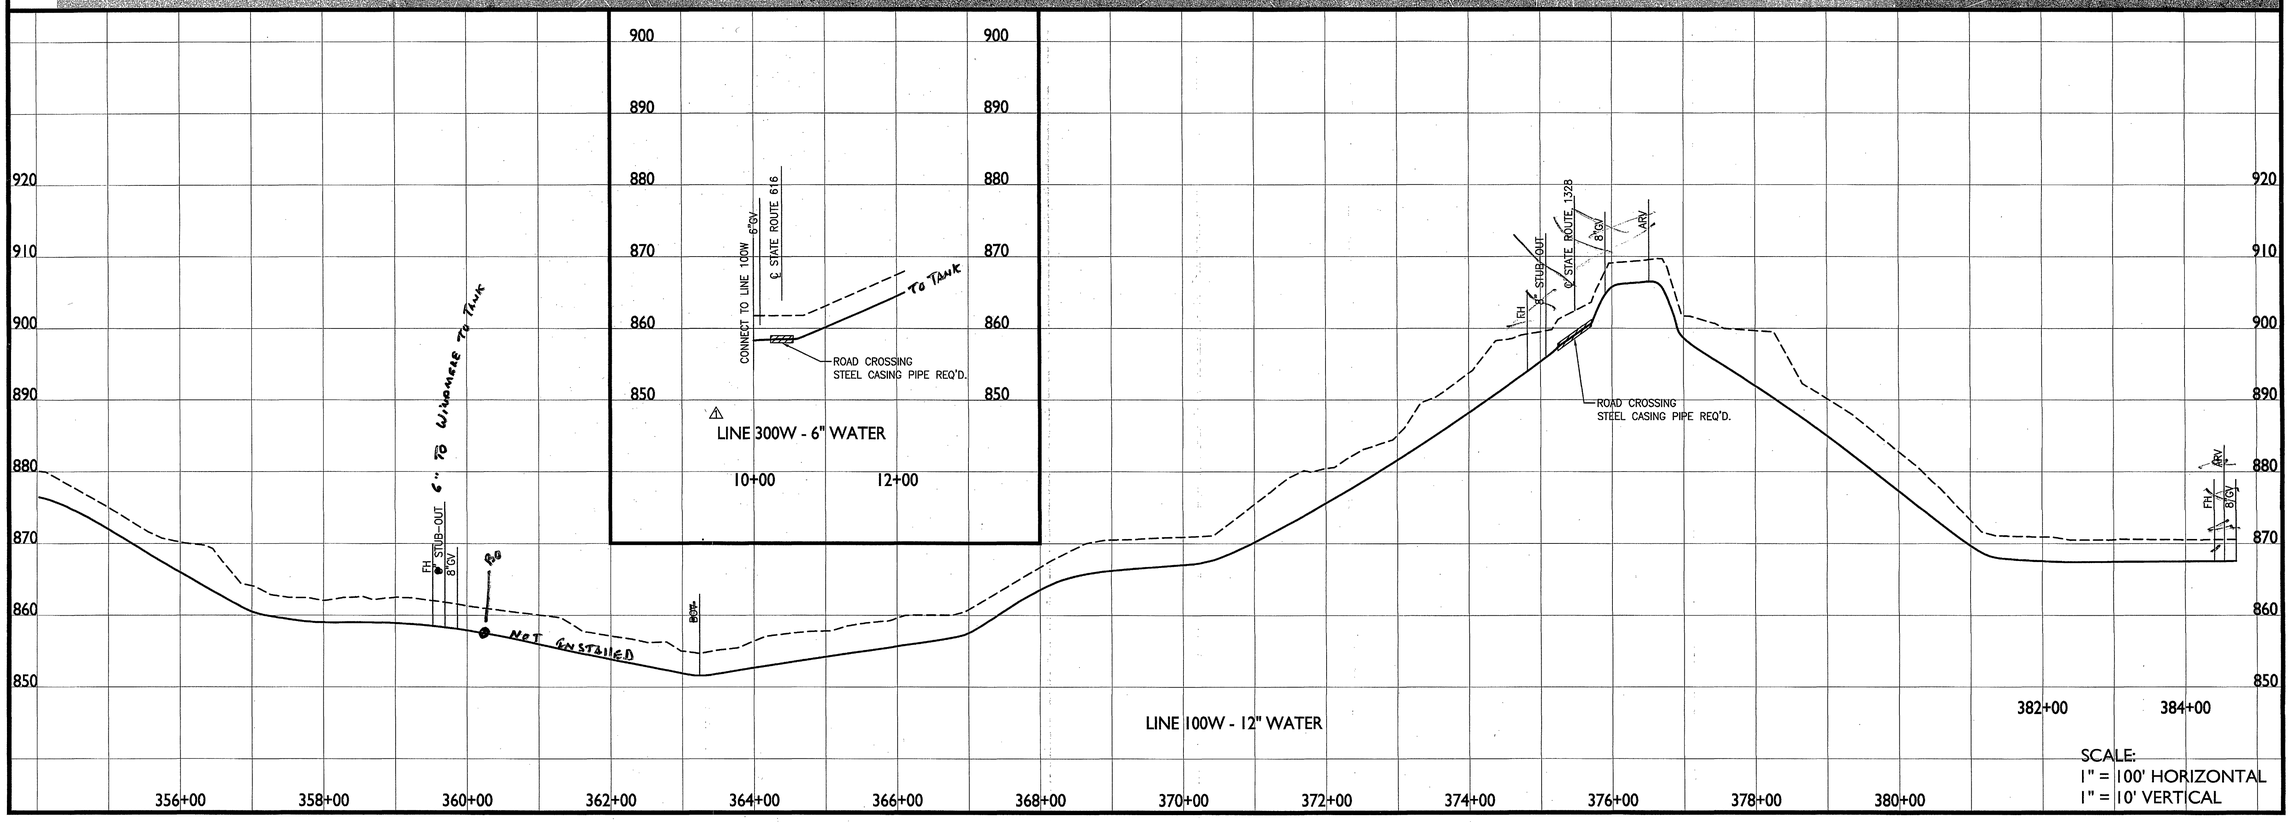

Seal: COMMONWEALTH OF VIRGINIA — GREGORY M. HURST — Lic. No. 031700 — PROFESSIONAL ENGINEER — 7/22/09

STATE ROUTE 616 WATER LINE EXTENSION
FOR THE
FRANKLIN COUNTY BOARD OF SUPERVISORS
AND
WESTERN VIRGINIA WATER AUTHORITY

PLAN & PROFILE - LINES 100W & 300W

No.	Date	Purpose of Document Issue
	07/02/09	REVIEW DOCUMENTS ISSUED
1	07/17/09	OWNER COMMENTS 07/13/09
	07/22/09	FINAL DOCUMENTS ISSUED

Designed	
Drawn	
Checked	
Date	JULY 2009
File No.	WATER LINE PLANS

Project No. 9343-02

THOMPSON & LITTON
6226 University Park Drive
Suite 3100
Radford, Virginia 24141

Sheet No. 15