



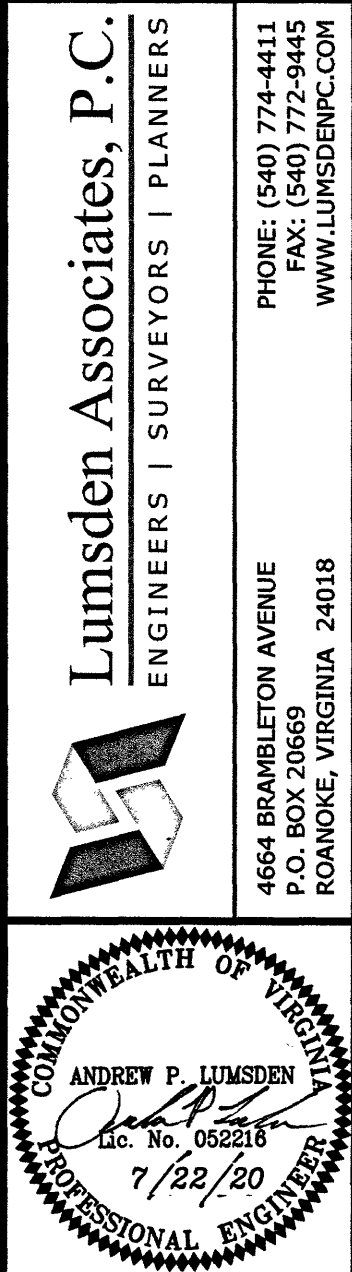

PLAN & PROFILE

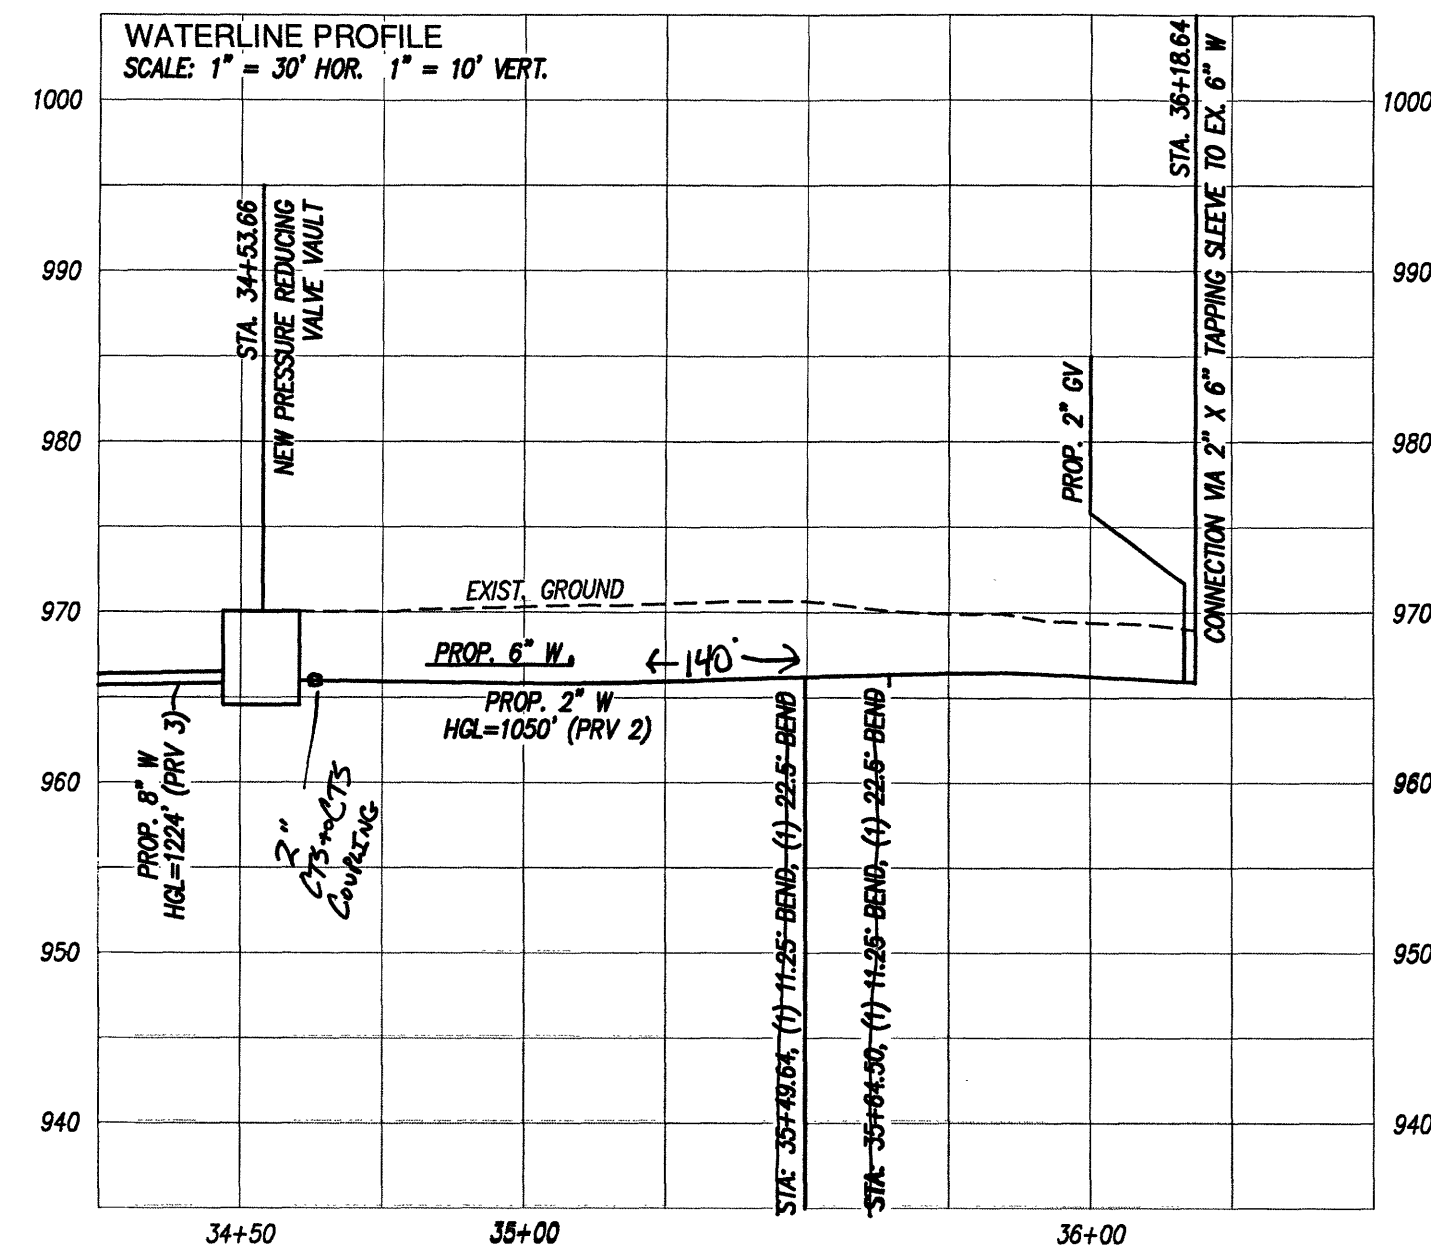

**STRIPER'S LANDING
WATERLINE EXTENSION**
PREPARED FOR
WESTERN VIRGINIA WATER AUTHORITY
SITUATED IN
FRANKLIN COUNTY, VIRGINIA

REVISED		DESCRIPTION
NO.	DATE	
1		
2		
3		
4		
5		

DATE: July 22, 2020

SCALE: 1" = 30'

COMMISSION NO: 19-284

SHEET 8 OF 11