
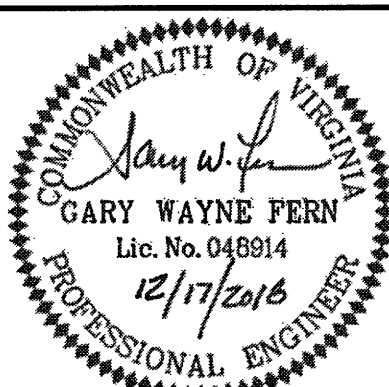


NOTE:

1. ALL PIPE MATERIALS SHALL BE AS SPECIFIED ON THE PIPE SCHEDULE SHOWN ON DRAWING C1.06.
2. IN THE EVENT CONTRACTOR DAMAGES EXISTING PAVEMENT, CONTRACTOR SHALL MILL AND RE-PAVE WITH SURFACE MIX (1.5-INCH DEEP) ONE LANE OF ROADWAY AT NO COST TO THE OWNER.

WATER - MATCH LINE STA. 67+03 SHEET 25
SFM - MATCH LINE STA. 87+62 SHEET 25

WATER - MATCH LINE STA. 73+14 SHEET 27
SFM - MATCH LINE STA. 93+74 SHEET 27

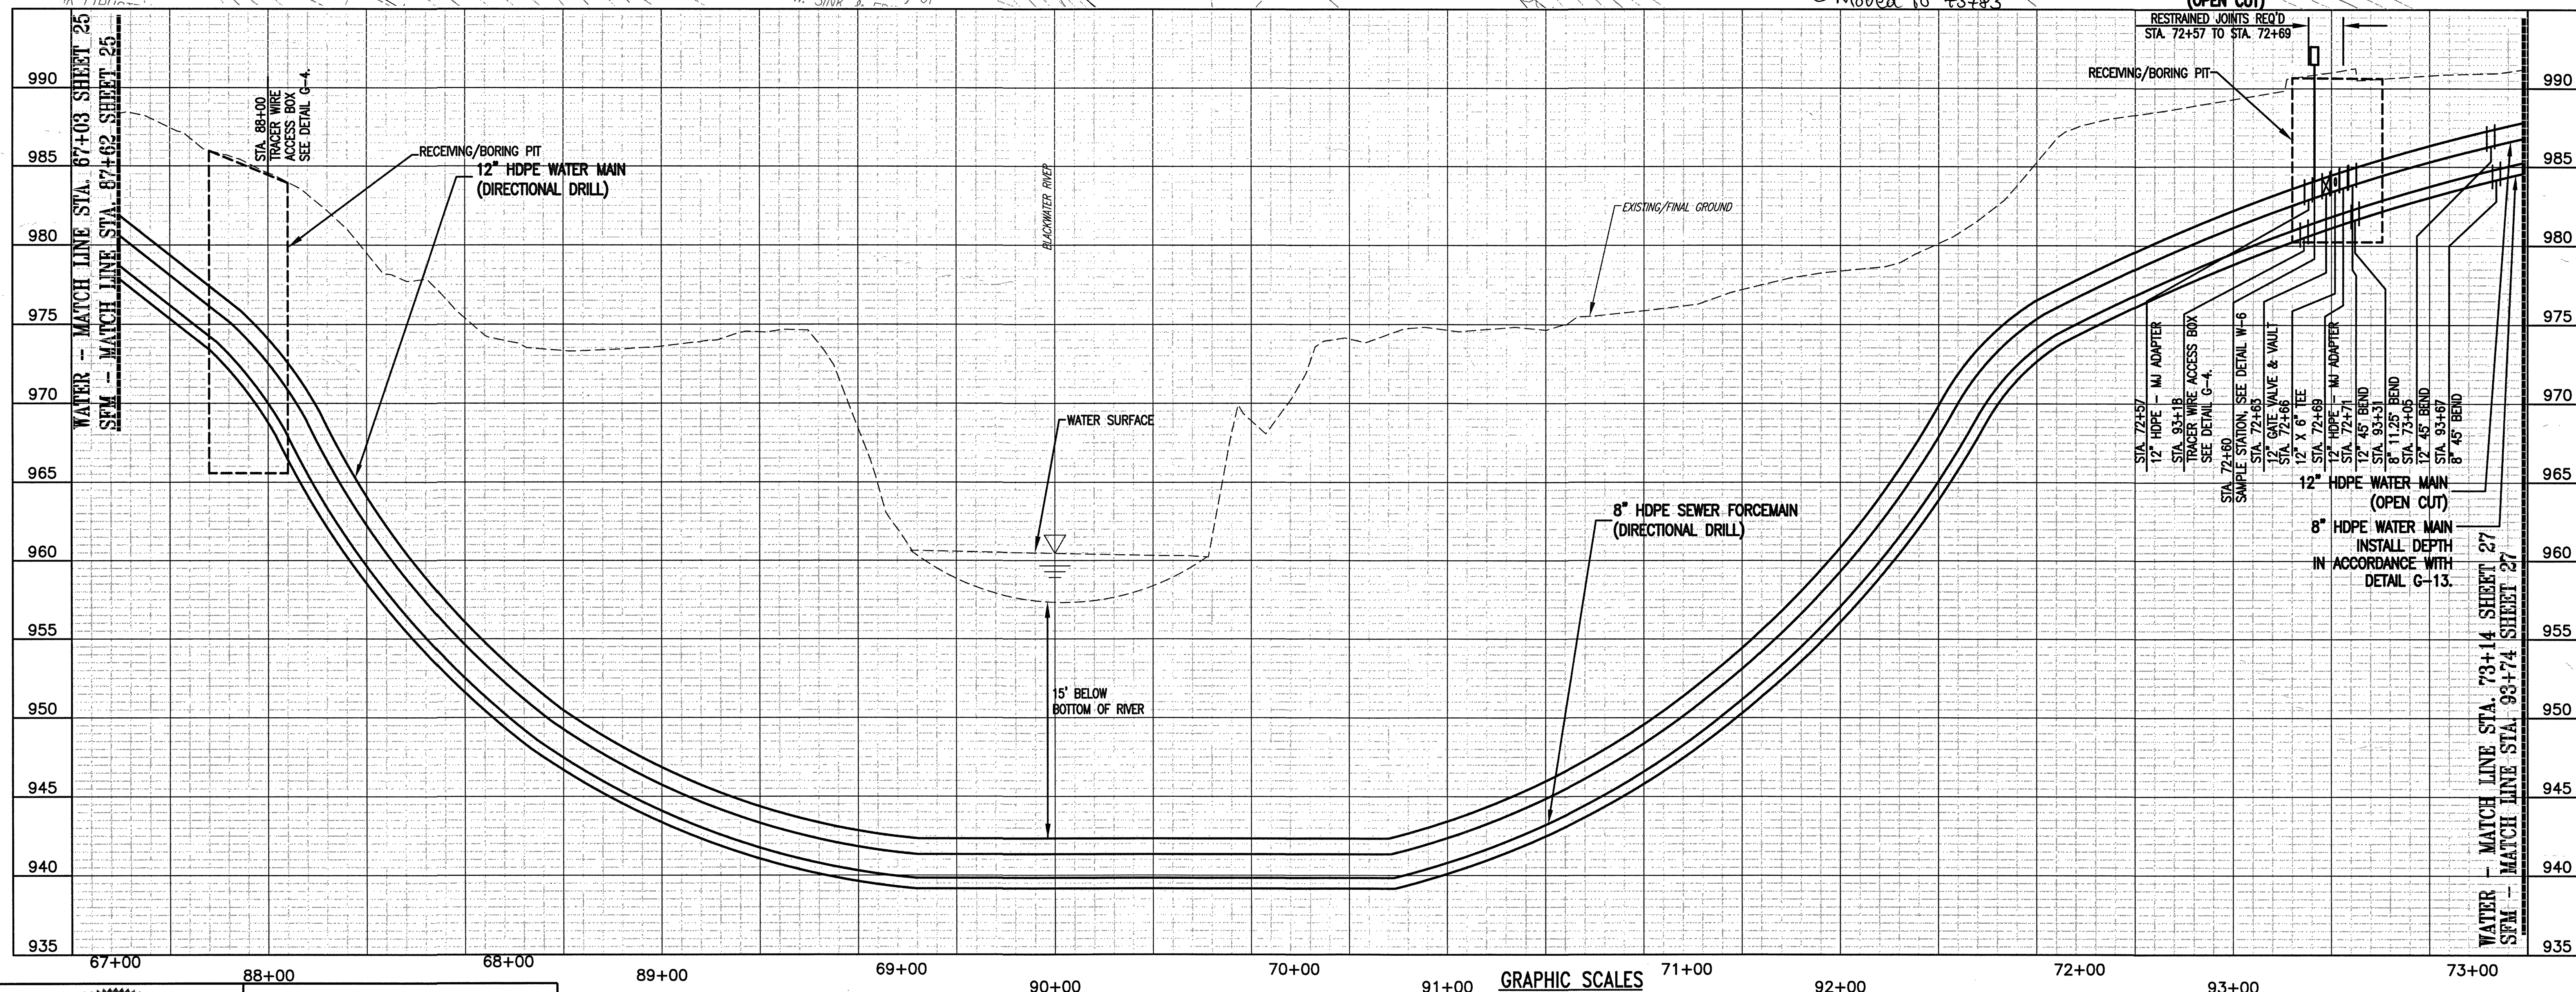

WESTERN VIRGINIA WATER AUTHORITY
601 South Jefferson Street, Suite 300
Roanoke, Virginia 24011

DES: PJM
DRAWN: JES
CHECK: GWF
DATE: 12/17/18

SCALE: AS SHOWN
HORIZ: 1" = 20'
VERT: 1" = 5'

SUMMIT VIEW BUSINESS PARK UTILITY IMPROVEMENTS
PHASE 2

8" SEWER FORCEMAIN PLAN - PROFILE
STA. 87+62 TO STA. 93+74
12" WATER MAIN PLAN - PROFILE
STA. 67+03 TO STA. 73+14

DRAWING
C1.23

SHEET
26