


19139comp-waterline-03-pp01.plt

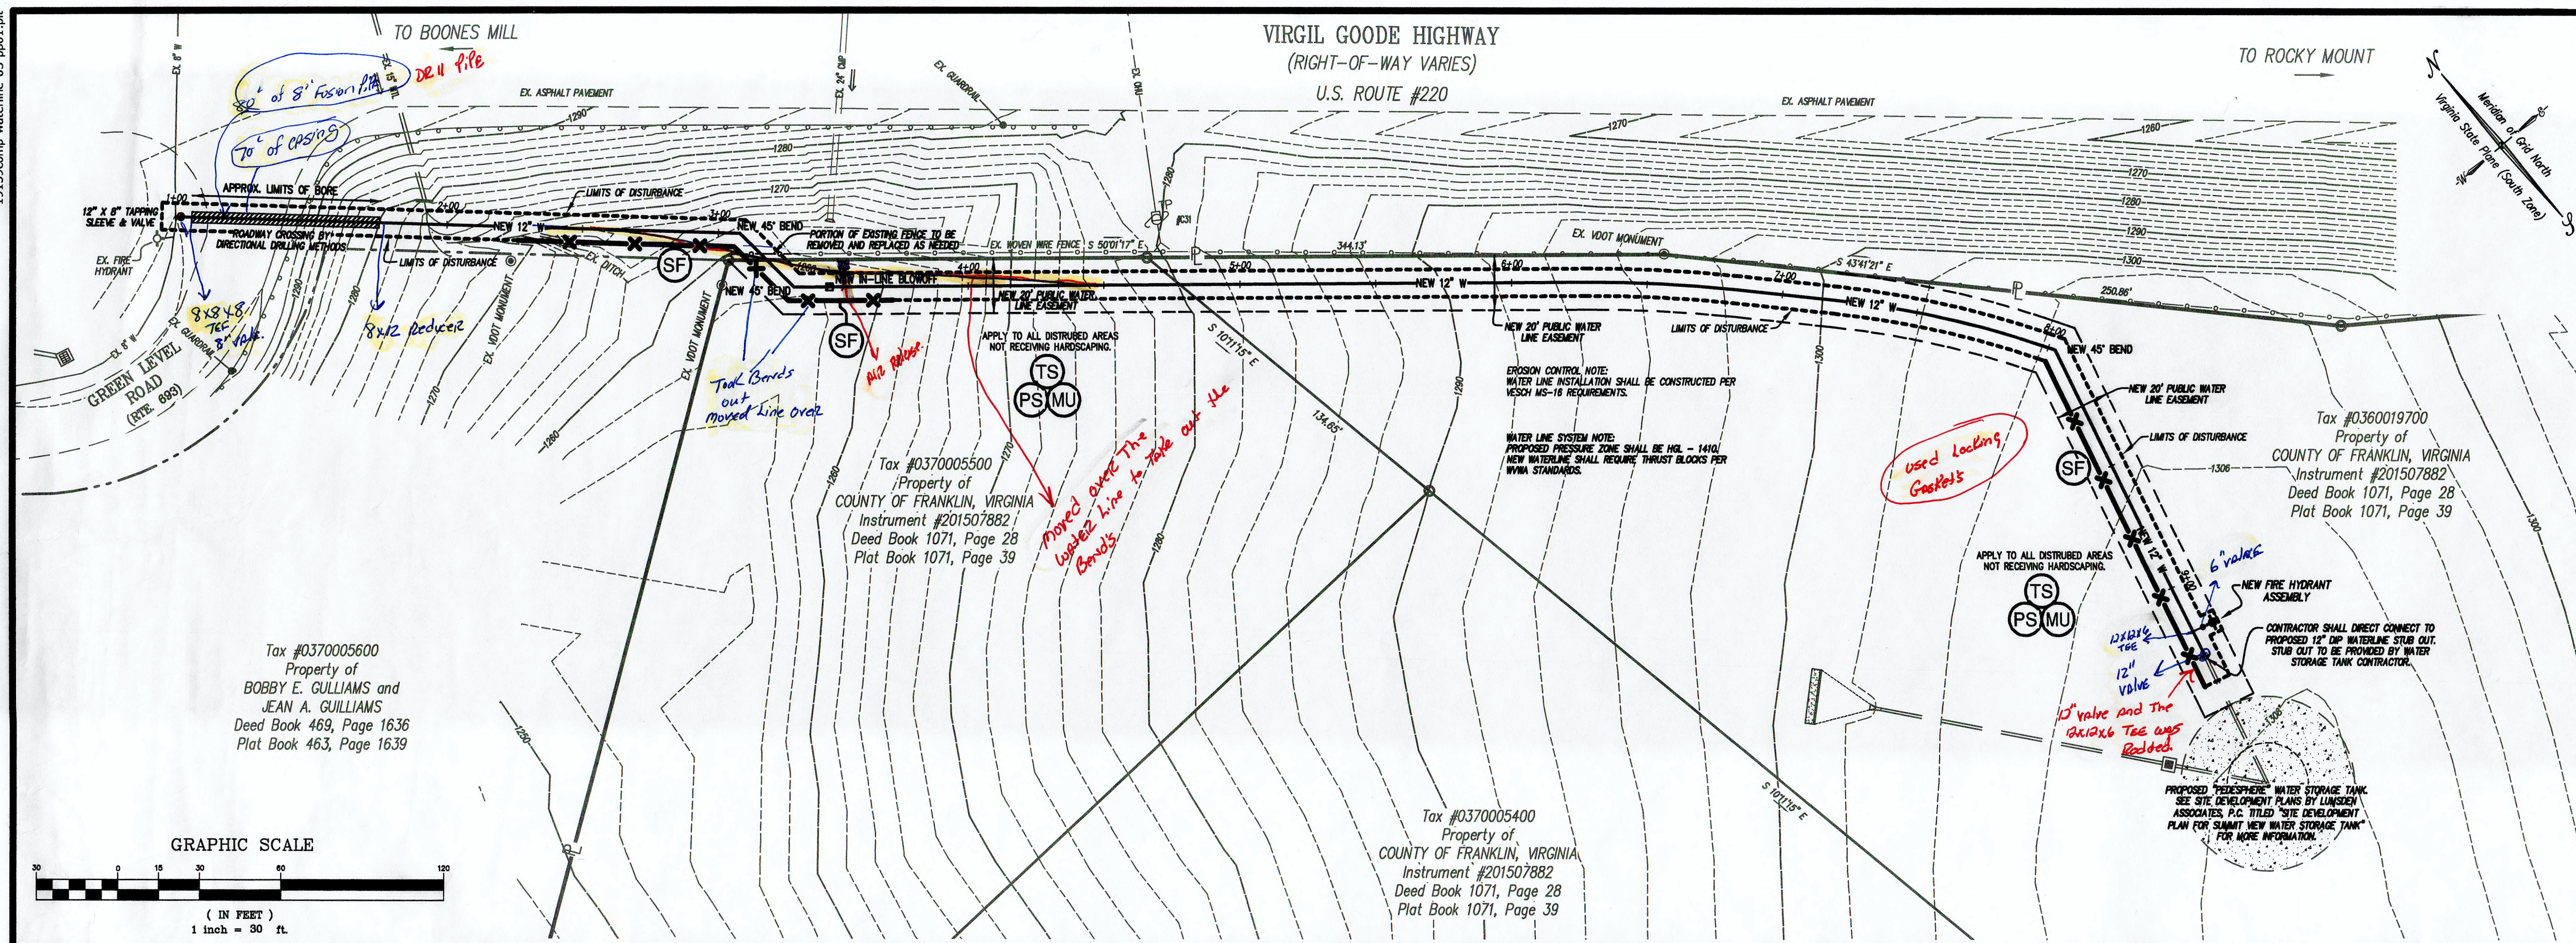

Lumsden Associates, P.C.
ENGINEERS | SURVEYORS | PLANNERS


4664 BRAMBLETON AVENUE
P.O. BOX 20669
ROANOKE, VIRGINIA 24018

PHONE: (540) 774-4411
FAX: (540) 772-9445
WWW.LUMSDENPC.COM

COMMONWEALTH OF VIRGINIA
ANDREW P. LUMSDEN
Lic. No. 052218
11/2/19
PROFESSIONAL ENGINEER

**WATER LINE
PLAN & PROFILE**

w:\drawings\2019-139\01-engineering\01-preliminary\19139comp-waterline.dwg

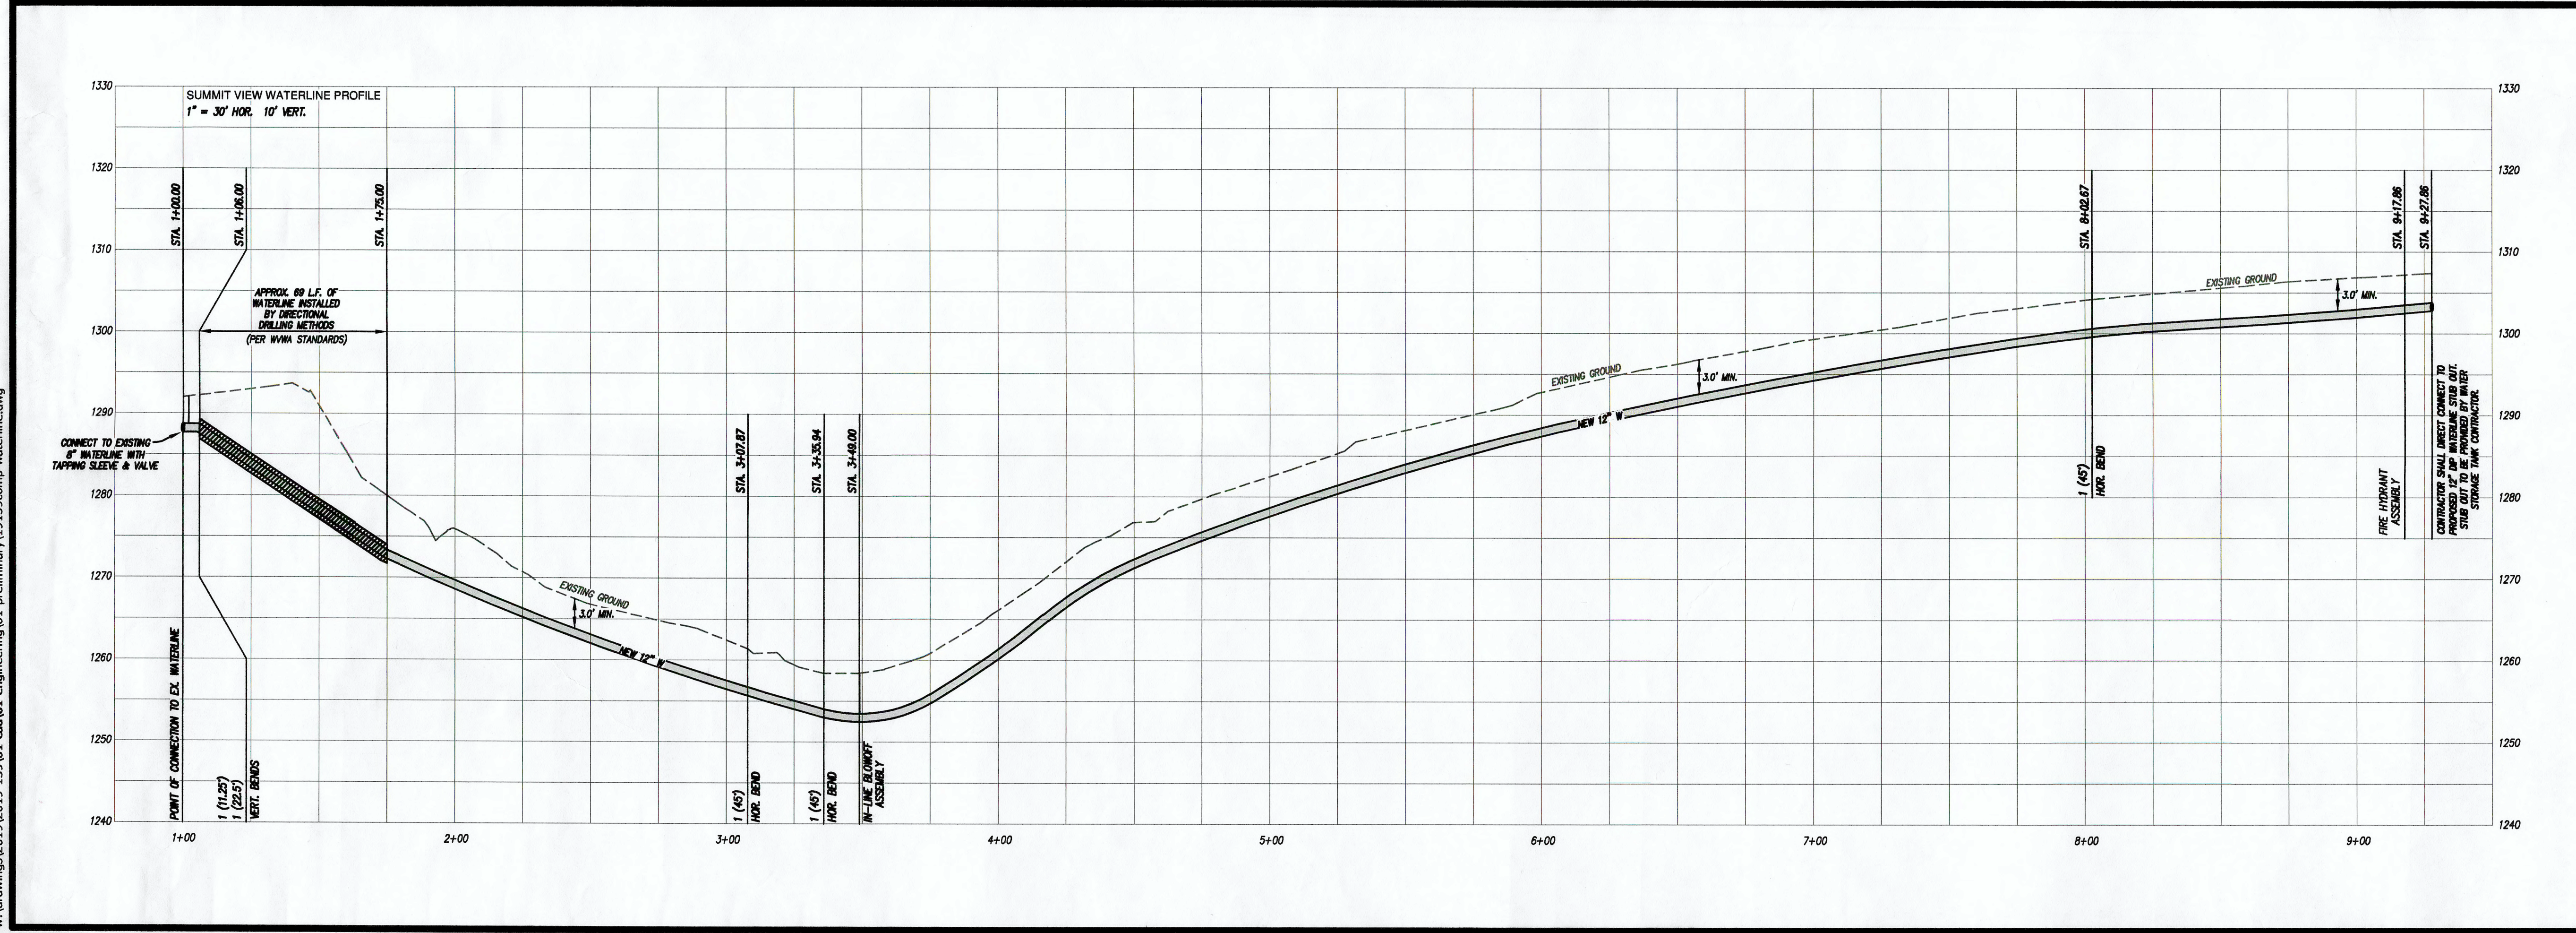

WATER LINE EXTENSION PLAN
FOR
Summit View Water Storage Tank
PREPARED FOR
Western Virginia Water Authority
SITUATED ALONG VIRGIL GOODE HIGHWAY
FRANKLIN COUNTY, VIRGINIA

NO.	DATE	DESCRIPTION
1		
2		
3		
4		
5		

DATE:
November 21, 2019
SCALE:
1" = 30'
COMMISSION NO:
19-139W
SHEET 3 OF 5