


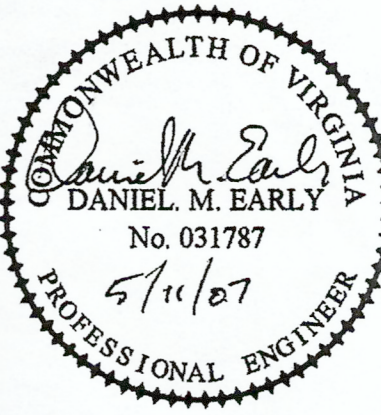

ACS DESIGN

ENGINEERING • SURVEYING
LANDSCAPE ARCHITECTURE
CONSTRUCTION MANAGEMENT

2203 PETERS CREEK ROAD
ROANOKE, VIRGINIA 24017
P 540.562.2345 F 562.2344
INFO@ACSDSIGNLLC.COM
WWW.ACSDSIGNLLC.COM


The Coves at Smith Mountain Lake
Optima Properties-Smith Mountain Lake, LLC
Franklin County, Virginia

DRAWN BY: dme
DESIGNED BY: dme
CHECKED BY: dme
DATE: 15 May 2006
JOB NUMBER: 05271

REVISIONS:	
No. 1	08/28/2006
Per FCACS	
No. 2	08/31/2006
E&S Rev Per FCACS	
No. 3	04/16/2007
Grading Plan Revisions	
No. 4	05/11/2007
Grading Plan Revisions	

SHEET NO.:
C1.7

GRADING PLAN
E&S PLAN
UTILITY PLAN

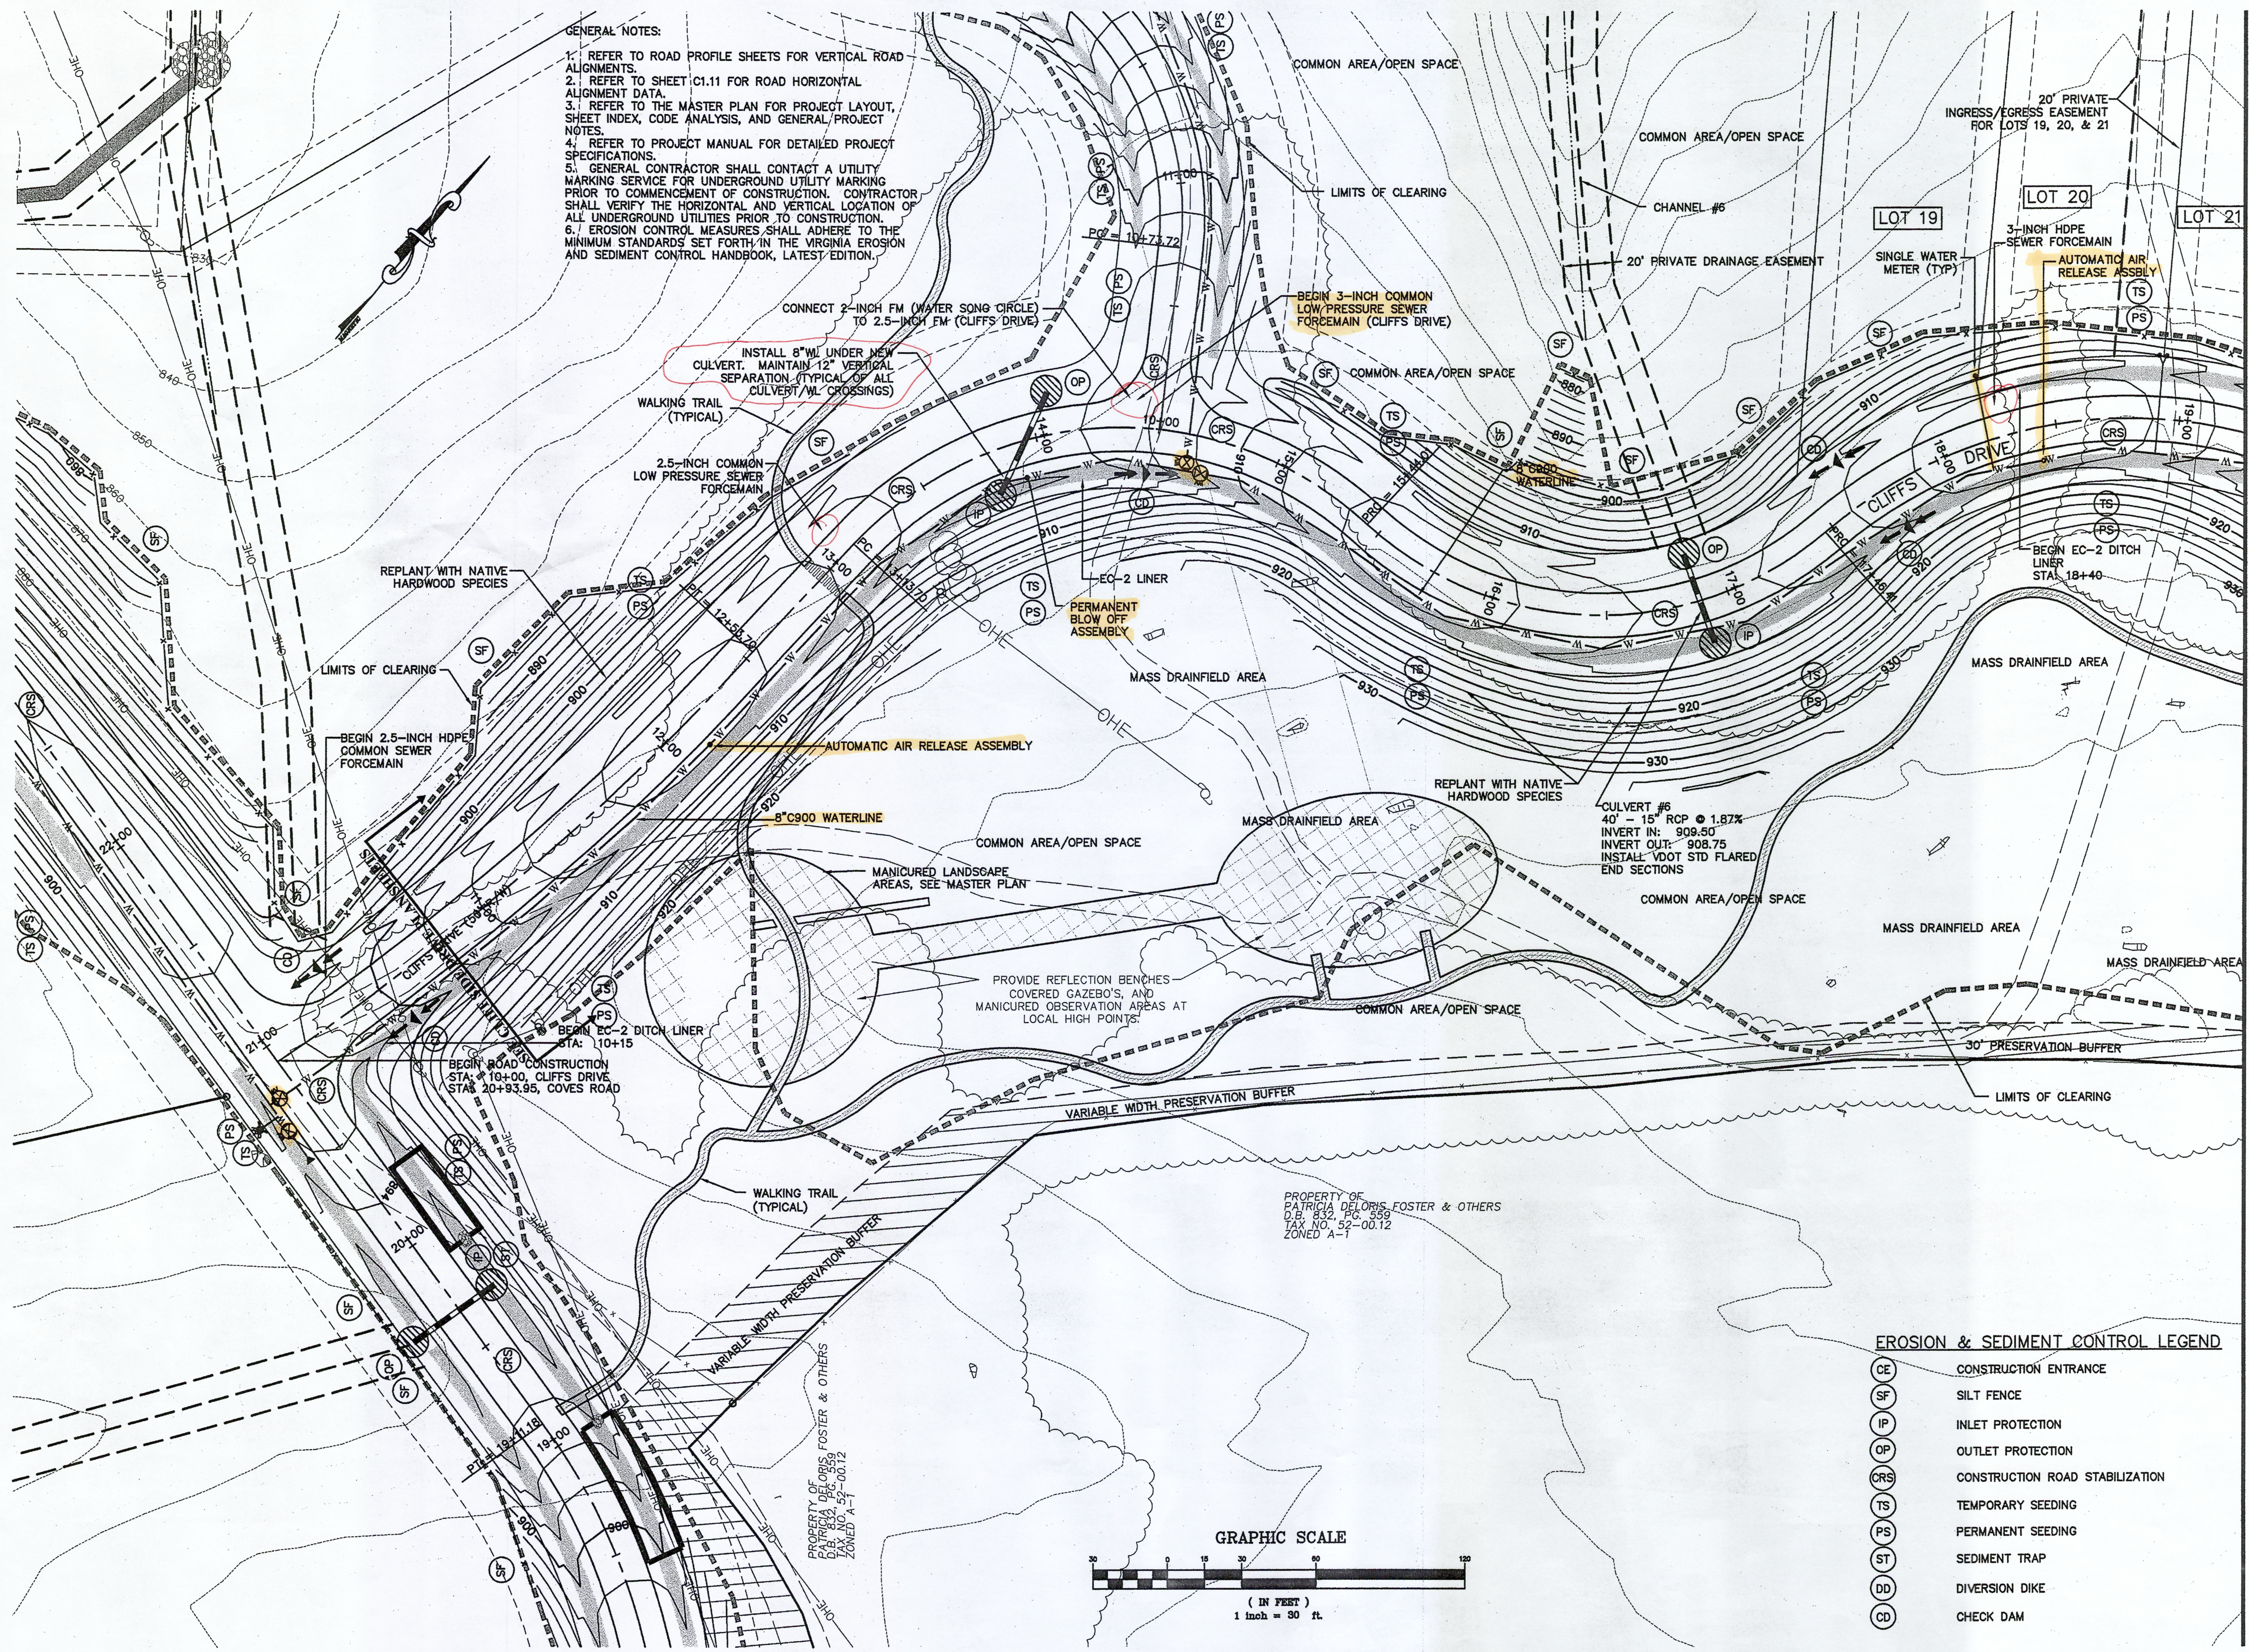

MATCHLINE SHEET C1.8

EROSION & SEDIMENT CONTROL LEGEND

- CE CONSTRUCTION ENTRANCE
- SF SILT FENCE
- IP INLET PROTECTION
- OP OUTLET PROTECTION
- CRS CONSTRUCTION ROAD STABILIZATION
- TS TEMPORARY SEEDING
- PS PERMANENT SEEDING
- ST SEDIMENT TRAP
- DD DIVERSION DIKE
- CD CHECK DAM

