* Water Re-Locations Done as part of Garden City Blvd Waterline Replacement CIP Project. Phase I

* 10-16-15 Contractor Re-Located 6" Line to Fire Hydrant # 10477.

As-Built

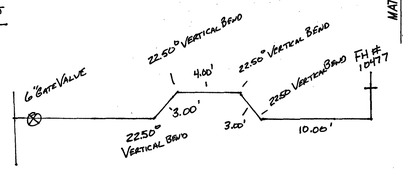

* Material Used: National 6" DR 14 C900 PVC

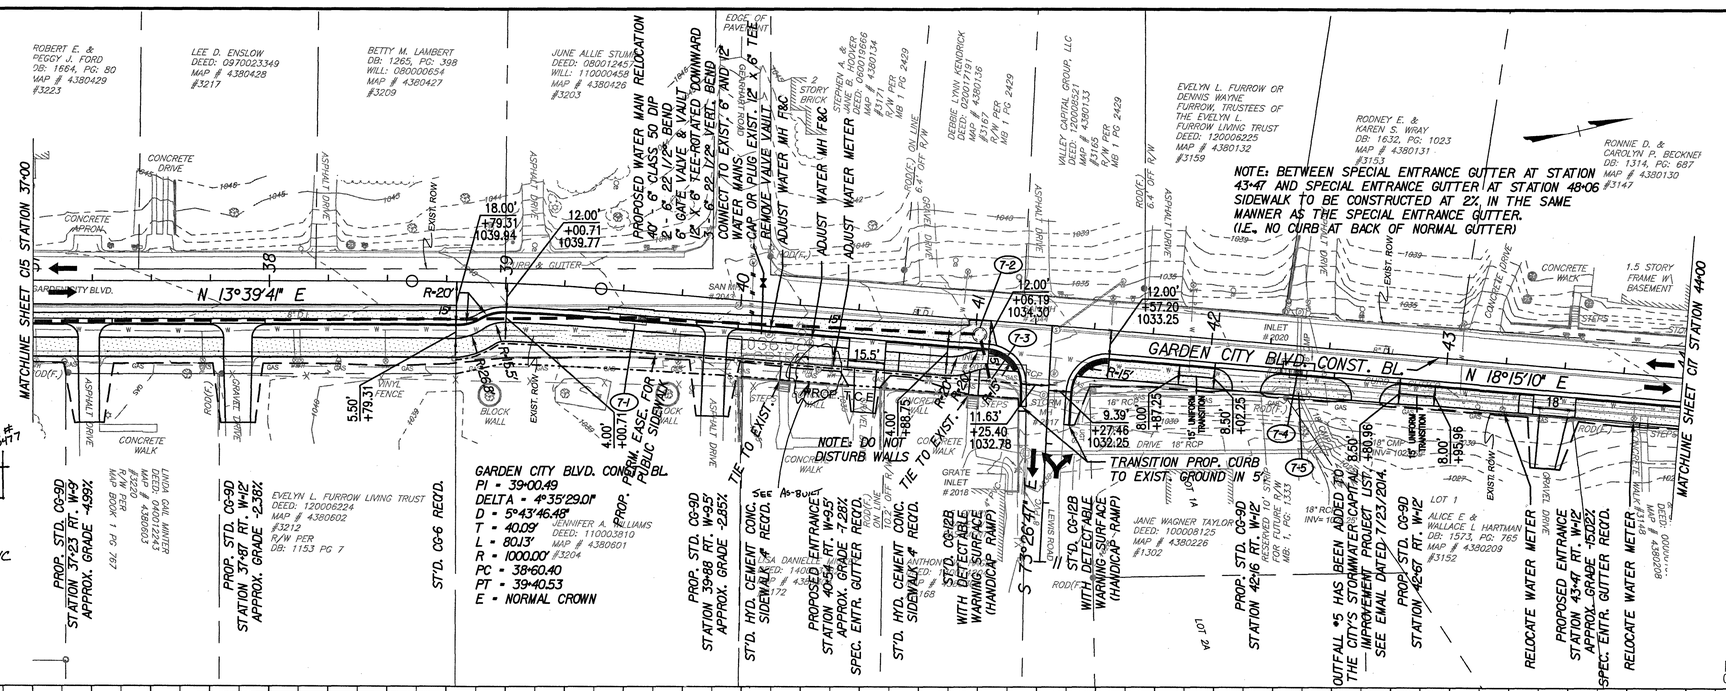
MATCHLINE SHEET C15 STATION 37+00
MATCHLINE SHEET C17 STATION 44+00
N 13°39'41" E
GARDEN CITY BLVD. CONST. BL.
N 18°15'10" E
GARDEN CITY BLVD. CONST. BL.
PI = 39+00.49
DELTA = 4°35'29.01"
D = 5°43'46.48"
T = 40.09'
L = 80.13'
R = 1000.00'
PC = 38+60.40
PT = 39+40.53
E = NORMAL CROWN
NOTE: DO NOT DISTURB WALLS
TRANSITION PROP. CURB TO EXIST. GROUND IN 5'
NOTE: BETWEEN SPECIAL ENTRANCE GUTTER AT STATION 43+47 AND SPECIAL ENTRANCE GUTTER AT STATION 48+06 SIDEWALK TO BE CONSTRUCTED AT 2% IN THE SAME MANNER AS THE SPECIAL ENTRANCE GUTTER. (I.E., NO CURB AT BACK OF NORMAL GUTTER)
PROPOSED WATER MAIN RELOCATION
40' - 6" CLASS 50 DIP
6" GATE VALVE & VAULT
12" X 6" TEE-ROTATED DOWNWARD
CONNECT TO EXIST. 6" AND 12" WATER MAINS, CAP OR PLUG EXIST. 12" X 6" TEE
ADJUST WATER MH F&C
ADJUST WATER METER
PROP. STD. CG-9D STATION 37+23 RT. W-9 APPROX. GRADE -4.59%
PROP. STD. CG-9D STATION 37+87 RT. W-12 APPROX. GRADE -2.38%
PROP. STD. CG-9D STATION 39+88 RT. W-9.5' APPROX. GRADE -2.85%
PROPOSED ENTRANCE STATION 40+54 RT. W-9.5' APPROX. GRADE -7.28% SPEC. ENTR. GUTTER REQ'D.
PROP. STD. CG-9D STATION 42+16 RT. W-12
PROPOSED ENTRANCE STATION 43+47 RT. W-12 APPROX. GRADE -15.02% SPEC. ENTR. GUTTER REQ'D.
RELOCATE WATER METER
OUTFALL #5 HAS BEEN ADDED TO THE CITY'S STORMWATER CAPITAL IMPROVEMENT PROJECT LIST. SEE EMAIL DATED 7/23/2014.
STD. HYD. CEMENT CONC. SIDEWALK REQ'D.
STD. CG-12B WITH DETECTABLE WARNING SURFACE (HANDICAP RAMP)
TIE TO EXIST.
ROBERT E. & PEGGY J. FORD DB: 1664, PG: 80 MAP # 4380429 #3223
LEE D. ENSLOW DEED: 0970023349 MAP # 4380428 #3217
BETTY M. LAMBERT DB: 1265, PG: 398 WILL: 080000654 MAP # 4380427 #3209
JUNE ALLIE STUMP DEED: 080012457 WILL: 110000458 MAP # 4380426 #3203
EVELYN L. FURROW OR DENNIS WAYNE FURROW, TRUSTEES OF THE EVELYN L. FURROW LIVING TRUST DEED: 120006225 MAP # 4380132 #3159
RODNEY E. & KAREN S. WRAY DB: 1632, PG: 1023 MAP # 4380131 #3153
RONNIE D. & CAROLYN P. BECKNER DB: 1314, PG: 687 MAP # 4380130 #3147
LINDA GAIL MINTER DEED: 040000453 MAP # 4380603 R/W PER MAP BOOK 1 PG 767
EVELYN L. FURROW LIVING TRUST DEED: 120006224 MAP # 4380602 #3212 R/W PER DB: 1153 PG 7
JENNIFER A. WILLIAMS DEED: 110003810 MAP # 4380601 #3204
JANE WAGNER TAYLOR DEED: 100008125 MAP # 4380226 #1302
ALICE E. & WALLACE L. HARTMAN DB: 1573, PG: 765 MAP # 4380209 #3152
LOT 1
LOT 2
1.5 STORY FRAME W/ BASEMENT
2 STORY BRICK
CONCRETE DRIVE
CONCRETE APRON
CONCRETE WALK
BLOCK WALL
VINYL FENCE
EXIST. ROW
ASPHALT DRIVE
GRAVEL DRIVE
INLET #2020
GRATE INLET #2018
18" RCP
18" CMP INV= 1031.96
UNIFORM TRANSITION
EXIST. 18" CMP
EXIST. 18" CMP
