① PK NAIL SET IN PVMT 25' FROM END OF 42" STEEL CASING PIPE, EL 926.33

② PK NAIL SET IN PVMT 35' FROM END OF 42" STEEL CASING PIPE, EL 927.19

③ PK NAIL SET IN PVMT 10' FROM END OF 42" STEEL CASING PIPE, EL 926.58

④ PK NAIL SET IN PVMT AT END OF 42" STEEL CASING PIPE, EL 926.03

T# 7050111

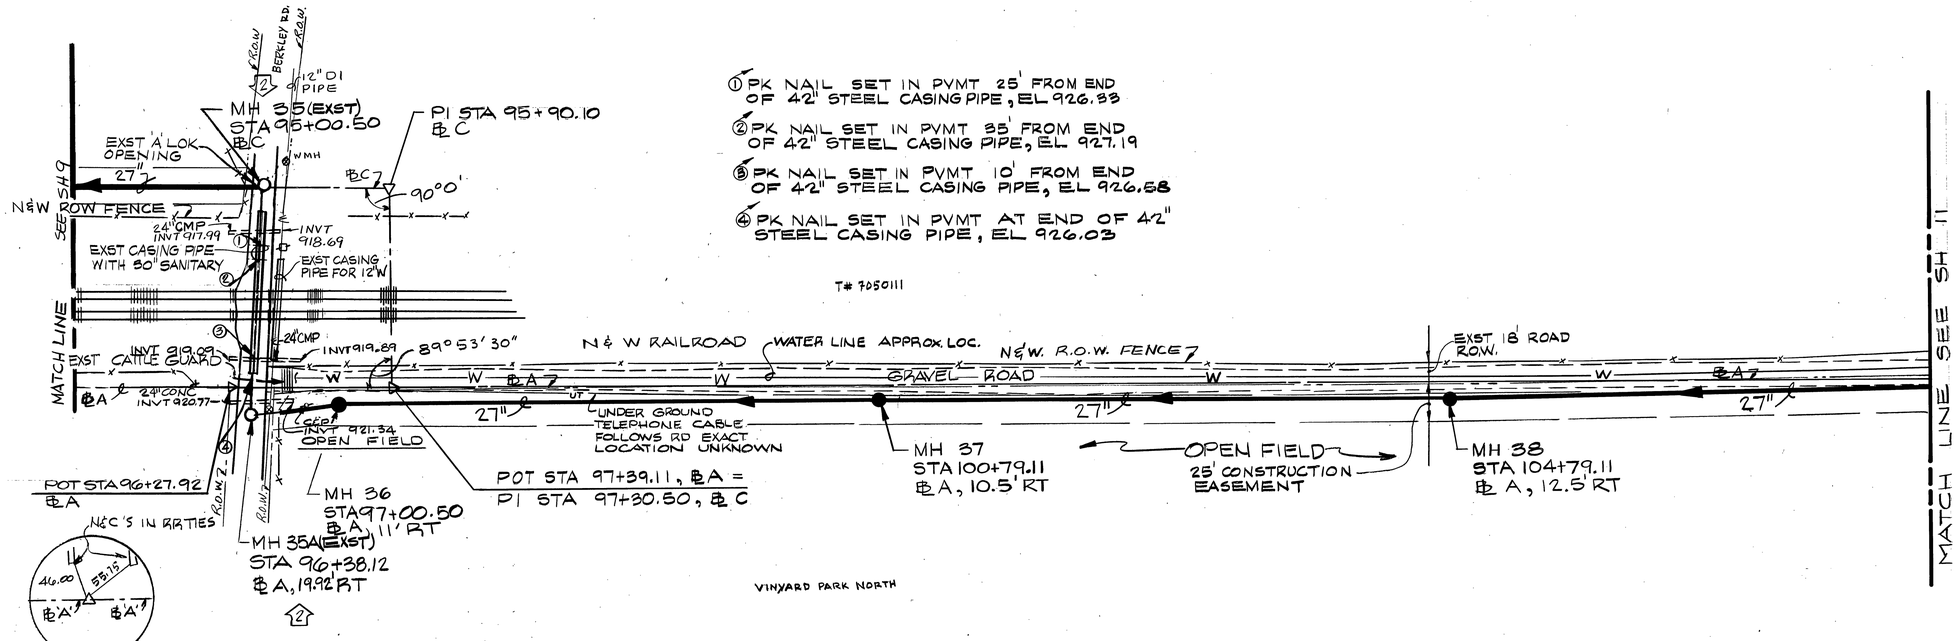

VINYARD PARK NORTH

MH NO.	STD. DET. NO.	FRAME & COVER
36	8	STD
37	6	STD
38	6	STD

POT STA 96+27.92

STA 93+06 (℄ C') - STA 108+14

SCALE: 1" = 50'

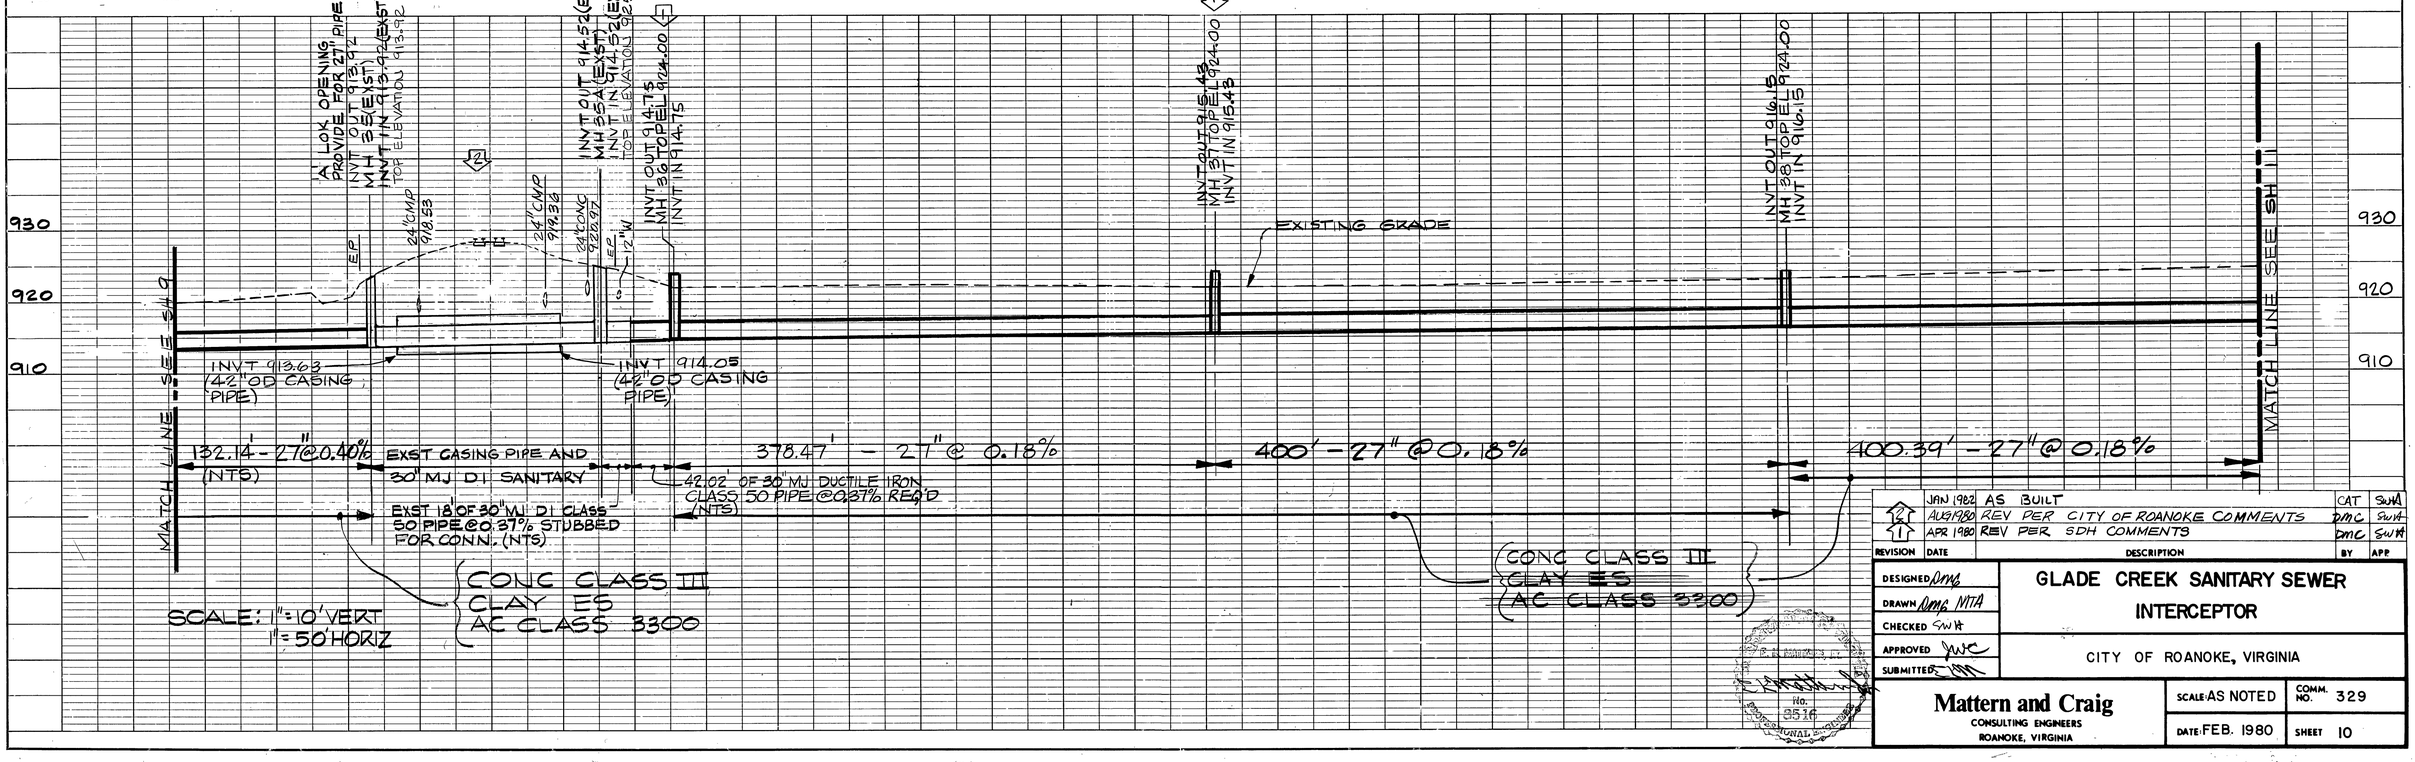

SCALE: 1" = 10' VERT
1" = 50' HORIZ

REVISION	DATE	DESCRIPTION	BY	APP
2	JAN 1982	AS BUILT	CAT	SWH
1	AUG 1980	REV PER CITY OF ROANOKE COMMENTS	DMC	SWH
	APR 1980	REV PER SDH COMMENTS	DMC	SWH

DESIGNED DMC
DRAWN DMC MTA
CHECKED SWH
APPROVED JWC
SUBMITTED

GLADE CREEK SANITARY SEWER INTERCEPTOR

CITY OF ROANOKE, VIRGINIA

Mattern and Craig
CONSULTING ENGINEERS
ROANOKE, VIRGINIA

SCALE: AS NOTED
COMM. NO. 329
DATE: FEB. 1980
SHEET 10

No. 3516

#5670