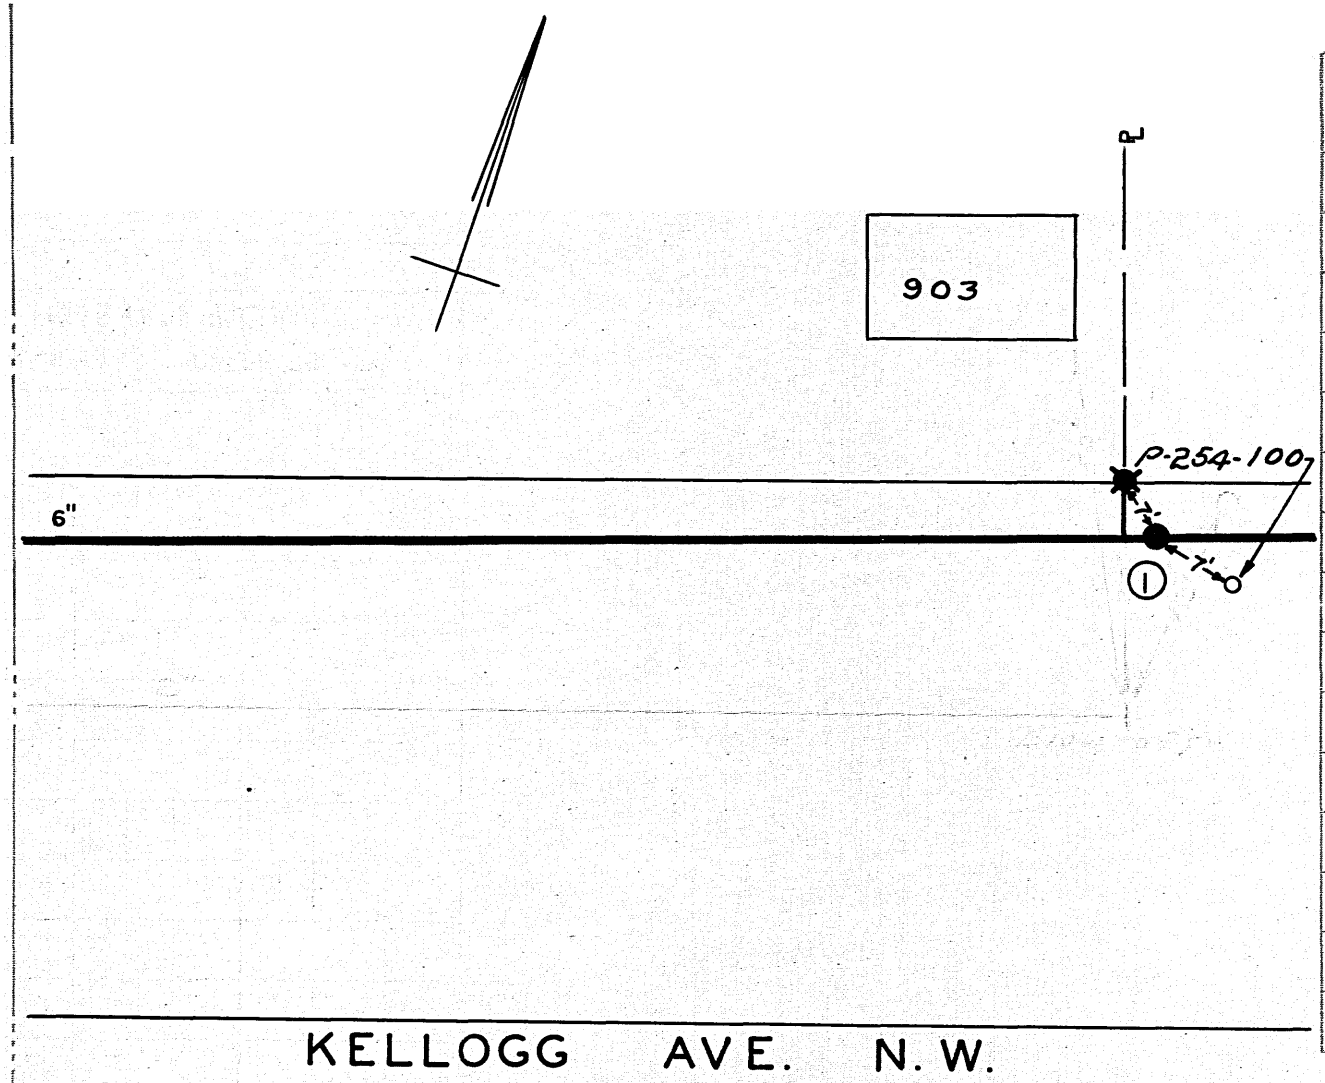

DATE	NO.	SIZE	MAKE	OPEN	TURNS
9/93	1	6"	DARLING	R	7½
	1	2-B	LOCKS. E. OF 10TH.		

CITY OF ROANOKE—WATER DEPT.

VALVE DIAGRAM

KELLOGG AVE. N.W. AT

903 KELLOGG AVE.

SEC. MAP 205

DATE PAGE NO.

8/94NP

"IMPERIAL" TRACING CLOTH
K & E CO., N. Y.