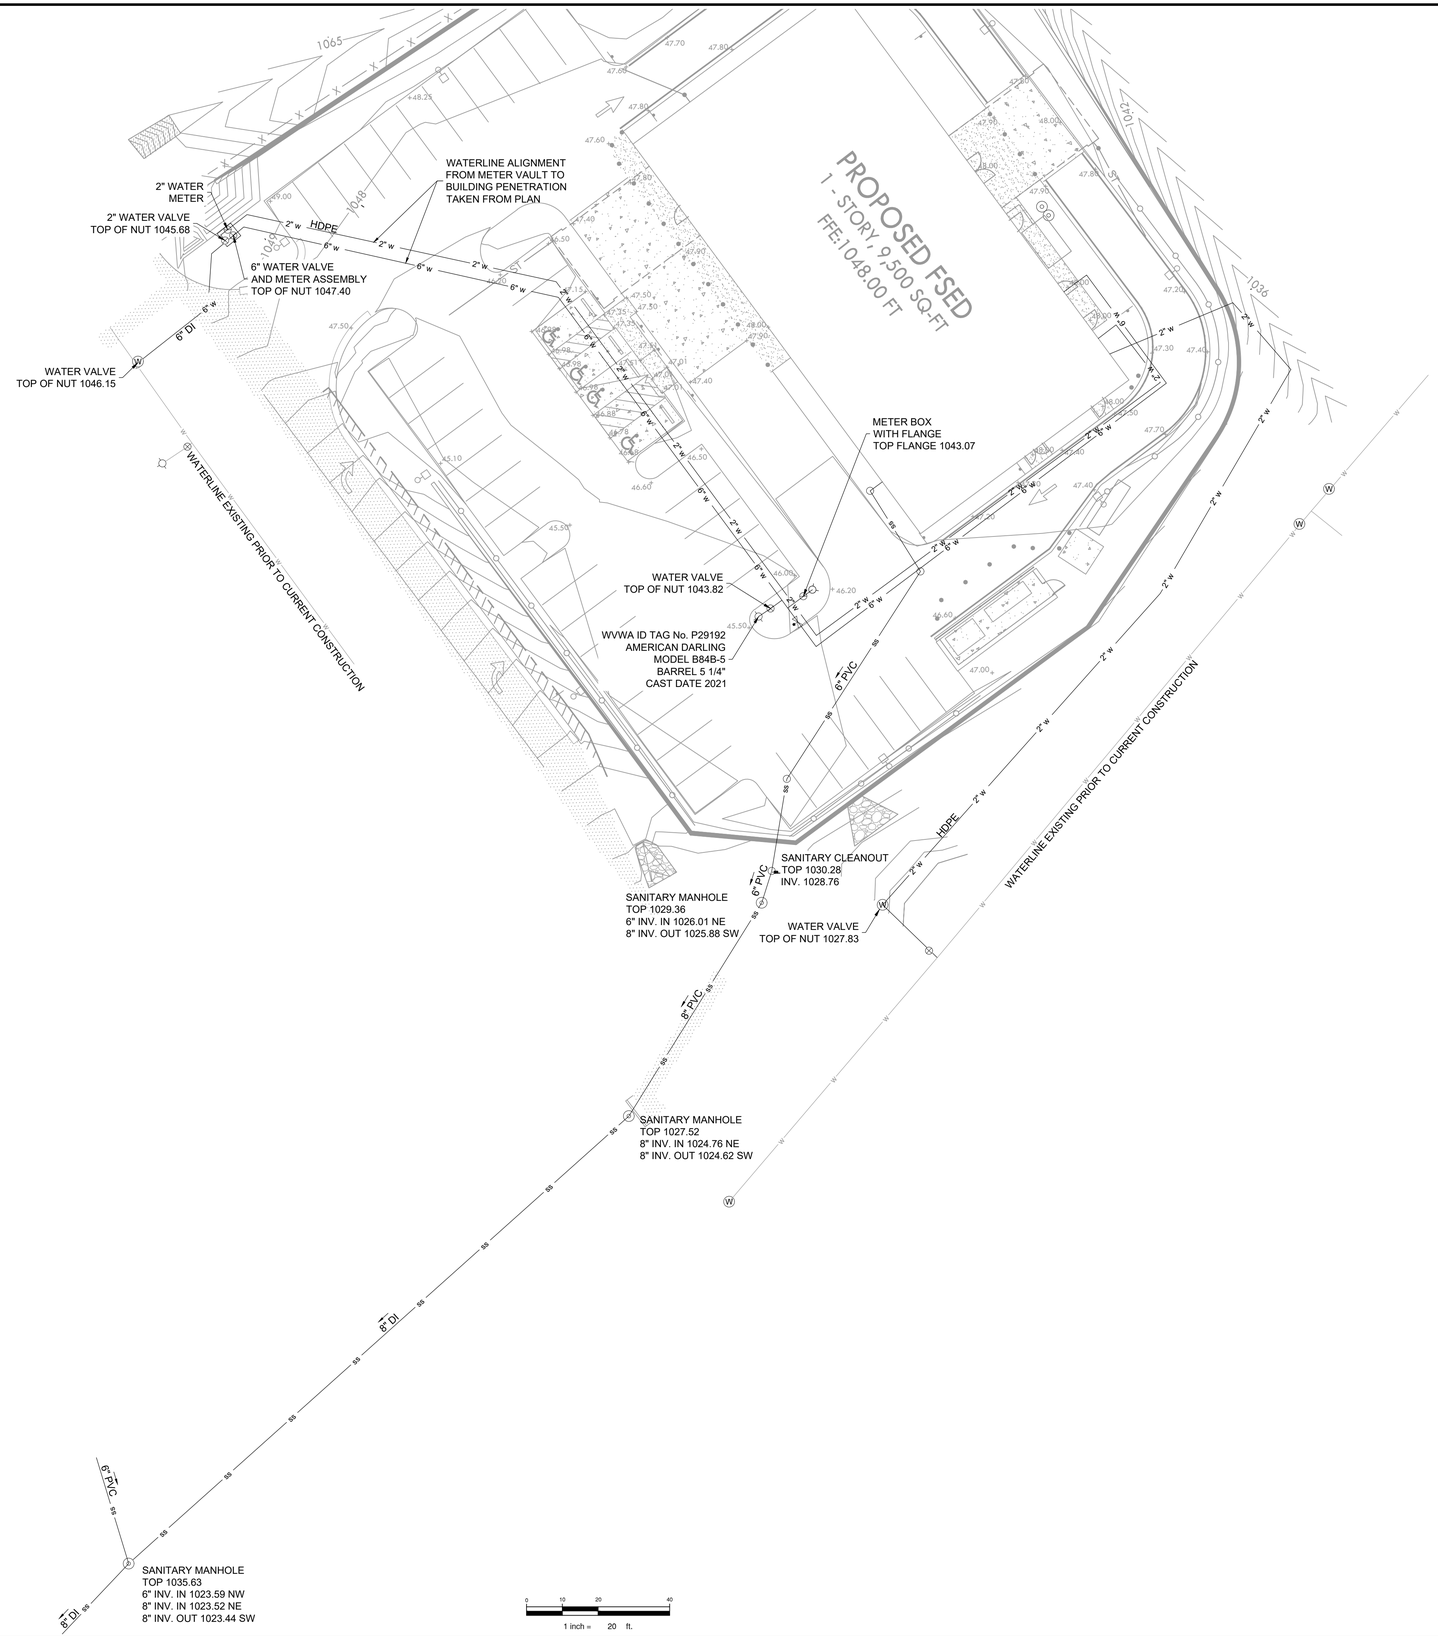

VIRGINIA STATE PLANE, SOUTH ZONE (NAD 83)

COMMONWEALTH OF VIRGINIA
L. W. KNIGHTING
Lic. No. 1460
01/28/22
LAND SURVEYOR

Draper Aden Associates
Engineering • Surveying • Environmental Services
2206 South Main Street
Blacksburg, VA 24060
540-552-0444 Fax: 540-552-0291
www.daa.com
• Richmond, VA
• Charlottesville, VA
• Hampton Roads, VA
• Raleigh, NC
• Fayetteville, NC
• Northern Virginia
• Virginia Beach, VA

RECORD DRAWING
WATER AND SANITARY SEWER SYSTEMS
LEWIS GALE
BLUE HILLS FREE STANDING EMERGENCY ROOM

ROANOKE COUNTY, VIRGINIA

REVISIONS

1 01/27/22
WVWA COMMENTS

DESIGNED BY:	N/A
DRAWN BY:	JFF
CHECKED BY:	LWK
SCALE:	1" = 20'
DATE:	01/27/22
PROJECT NUMBER:	2100632

SHEET
1 OF 1

P:\2021\2000\21000\21000632\5-SVY\CAD\21000632-VWP-BE-C.DWG.dwg January 28, 2022 11:06:25 AM