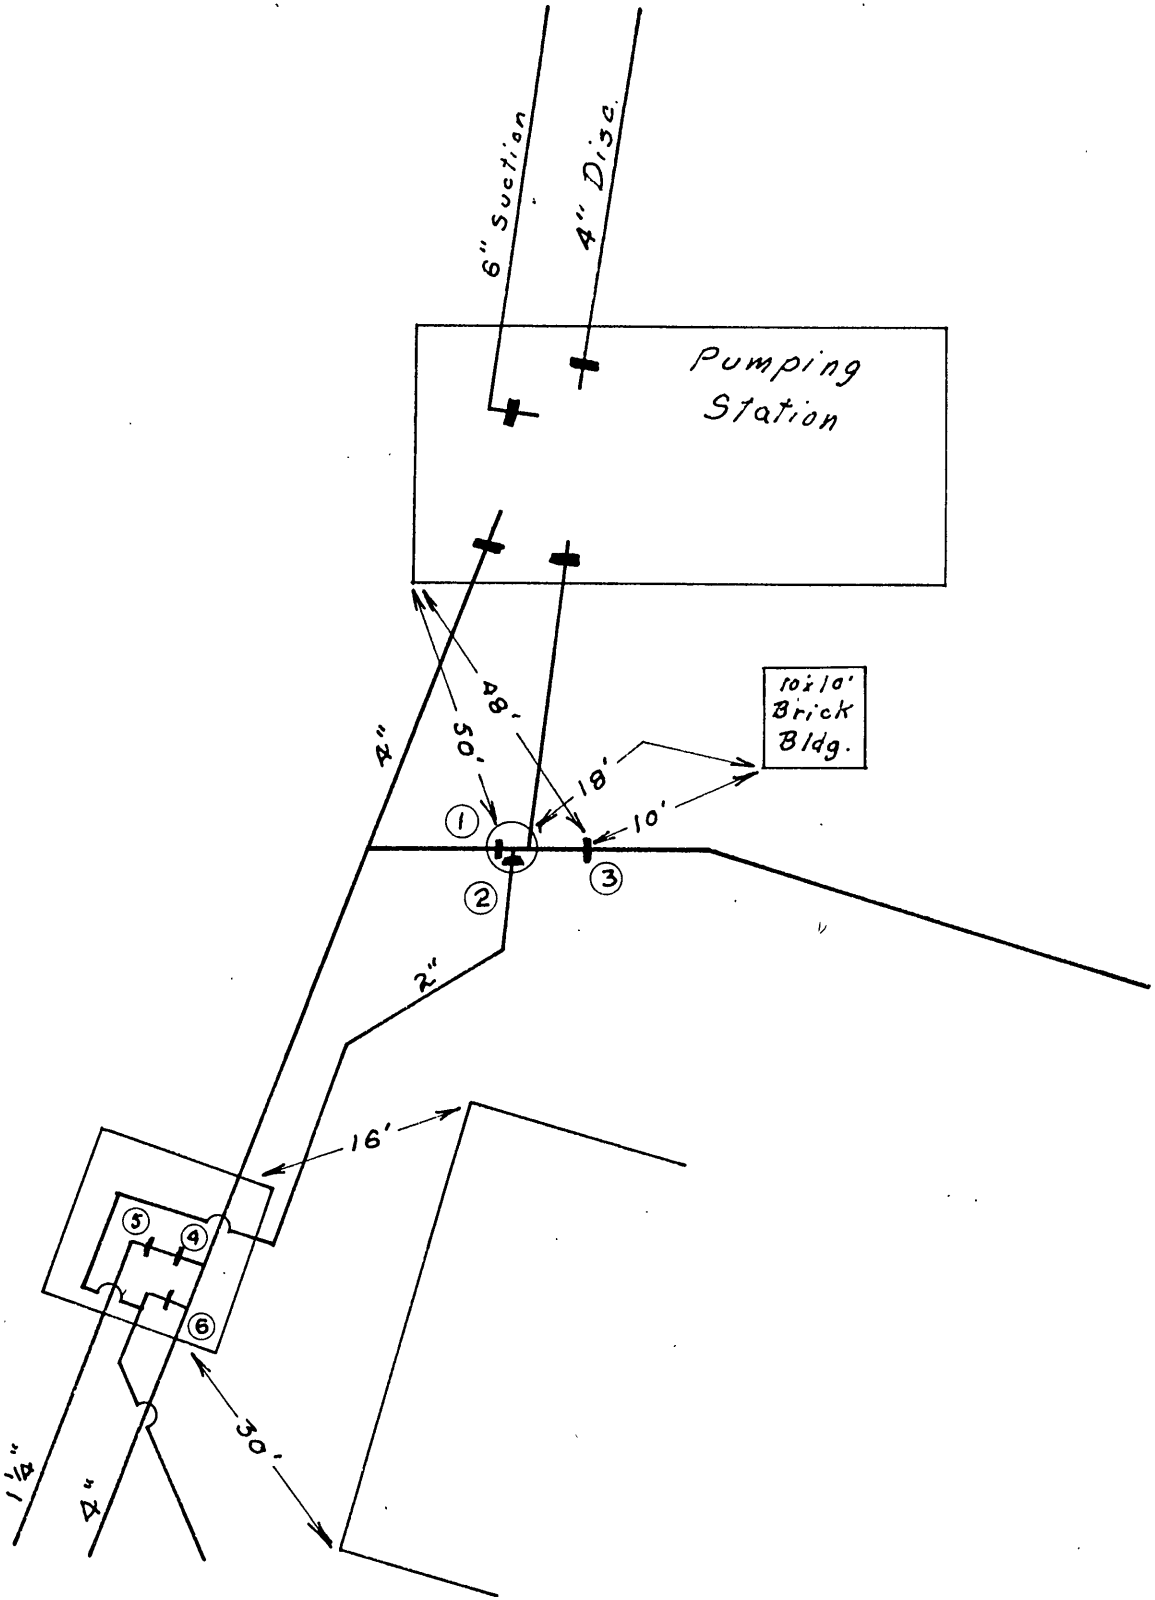

DATE	NO.	SIZE	MAKE	OPEN	TURNS
	1	2"			
	2	2"			
	3	2"			
	4	3"			
	5	2"			
	6	6"			

A Abandoned

(updated info 6/2005)

CITY OF ROANOKE — WATER DEPT.

VALVE DIAGRAM

MASON MILL PUMPING STATION

SEC. MAP 324

DATE PAGE NO.

"IMPERIAL" TRACING CLOTH K & E CO., N. Y.