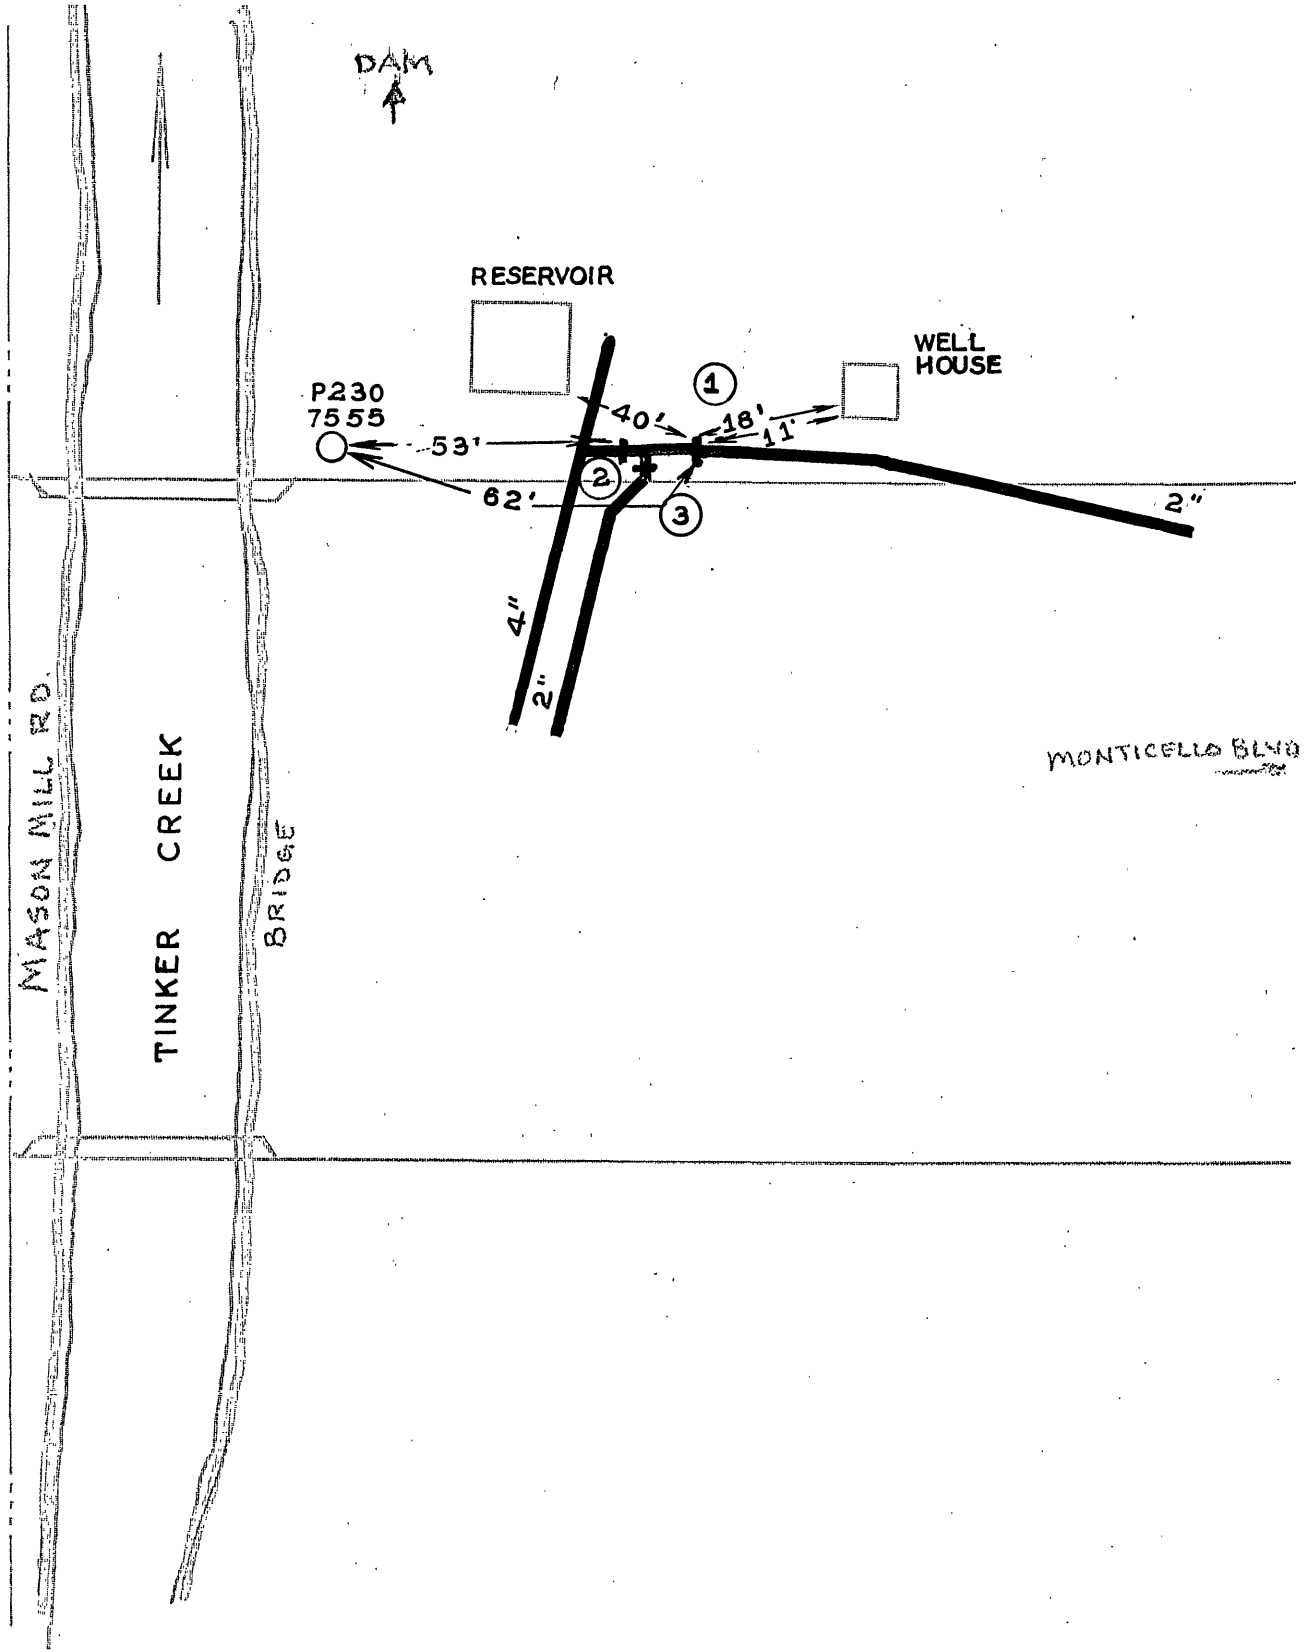

DATE	NO.	SIZE	MAKE	OPEN	TURNS
	1	2"			
	2	2"			
	3	2"			

CITY OF ROANOKE — WATER DEPT.

VALVE DIAGRAM

MASON MILL PUMPING

STATION N. E.

SEC. MAP 324

DATE WR PAGE NO. NE161

"IMPERIAL" TRACING CLOTH
K & E CO., N. Y.