08039pr01-02.pr01.plt

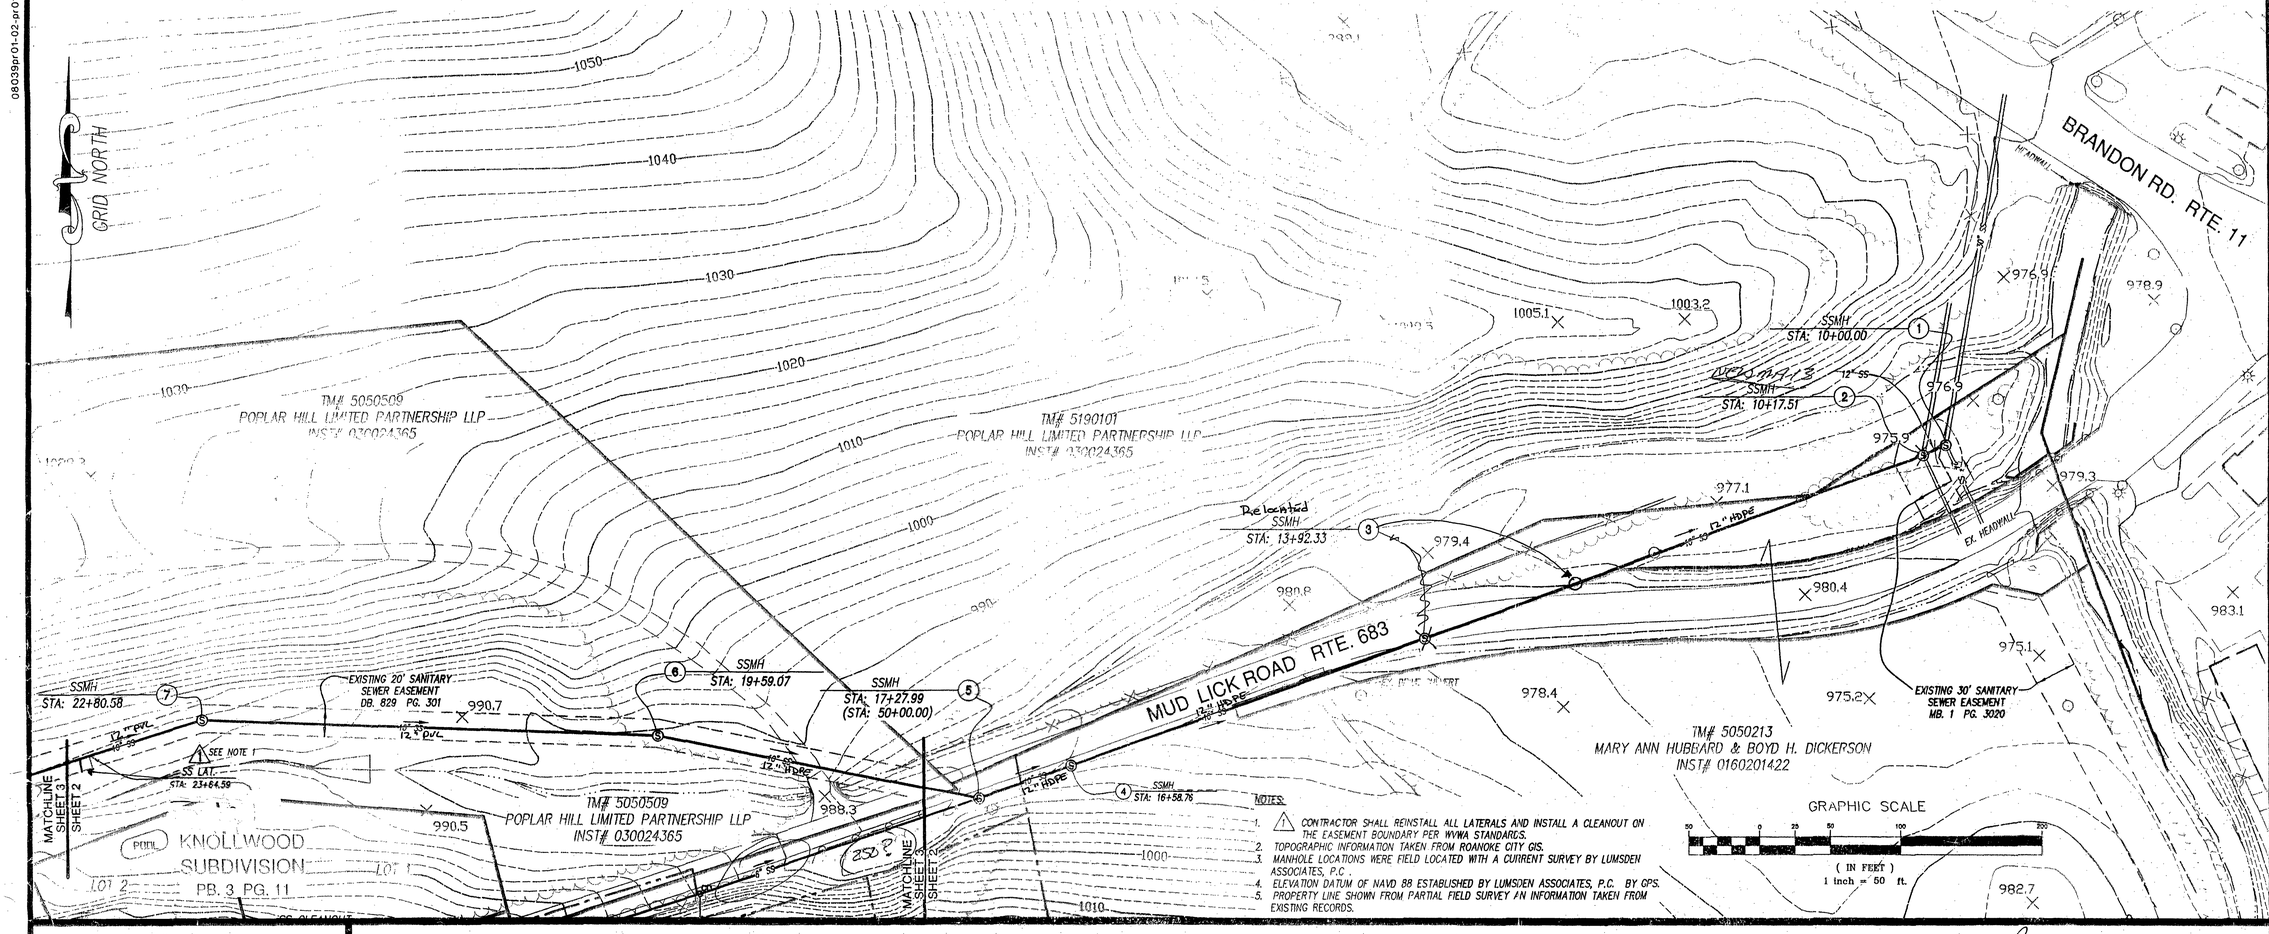


NOTES:

1. ⚠ CONTRACTOR SHALL REINSTALL ALL LATERALS AND INSTALL A CLEANOUT ON THE EASEMENT BOUNDARY PER WVWA STANDARDS.
2. TOPOGRAPHIC INFORMATION TAKEN FROM ROANOKE CITY GIS.
3. MANHOLE LOCATIONS WERE FIELD LOCATED WITH A CURRENT SURVEY BY LUMSDEN ASSOCIATES, P.C .
4. ELEVATION DATUM OF NAVD 88 ESTABLISHED BY LUMSDEN ASSOCIATES, P.C. BY GPS.
5. PROPERTY LINE SHOWN FROM PARTIAL FIELD SURVEY AN INFORMATION TAKEN FROM EXISTING RECORDS.

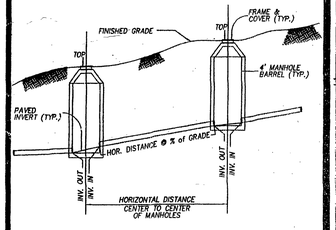


SANITARY SEWER
HORIZONTAL AND SLOPE DISTANCE DETAIL

NO SCALE

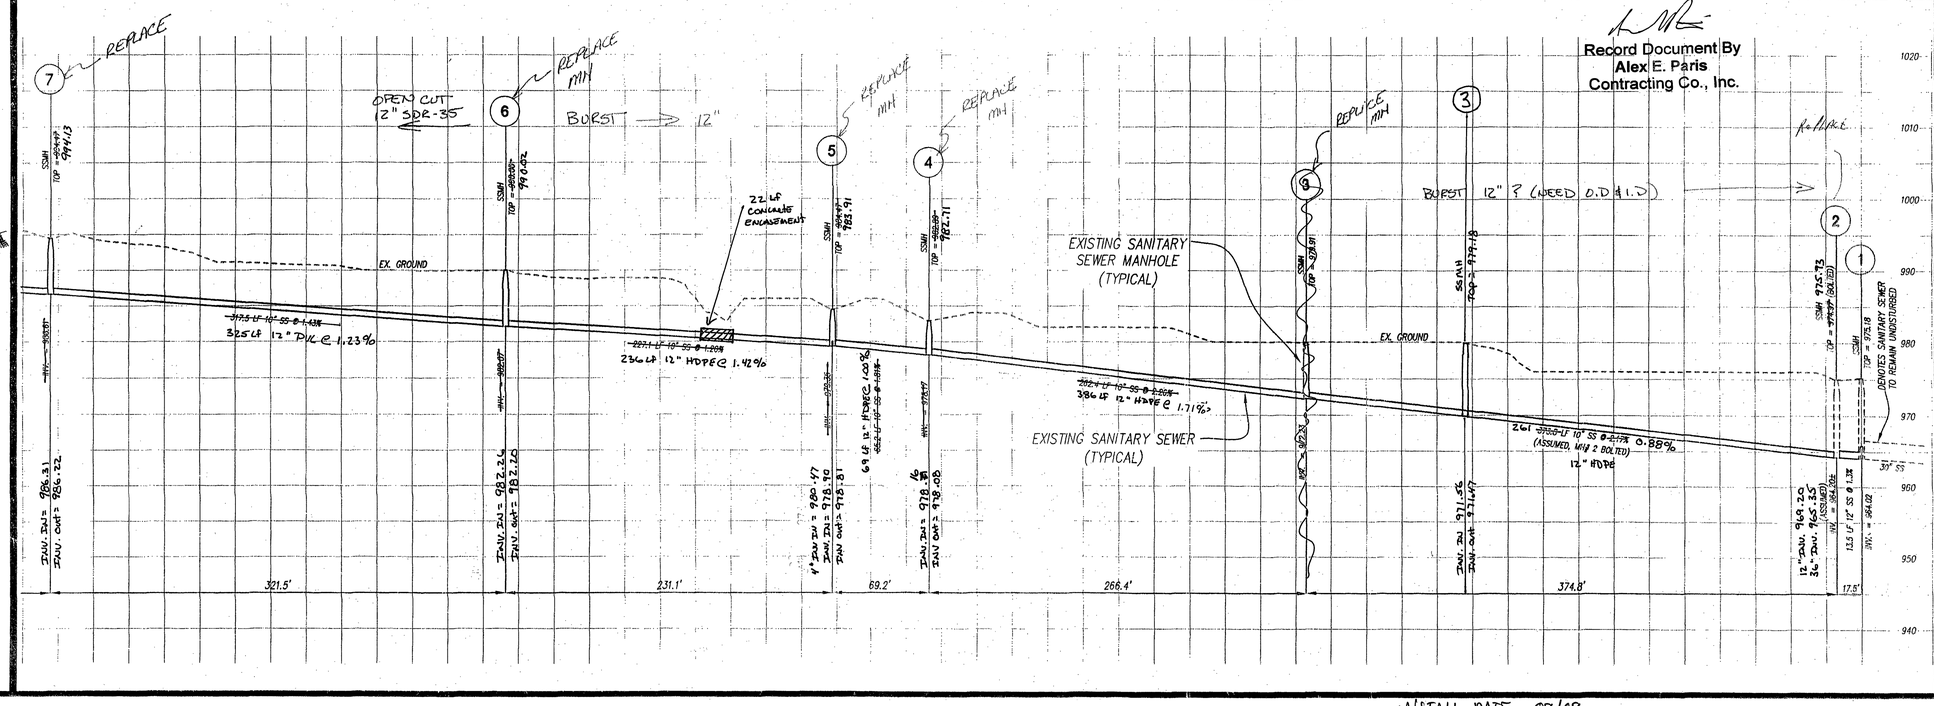


Record Document By
Alex E. Paris
Contracting Co., Inc.

INSTALL DATE 08/08

LUMSDEN ASSOCIATES, P.C.
ENGINEERS-SURVEYORS-PLANNERS
ROANOKE, VIRGINIA
4664 BRAMBLETON AVENUE
P.O. BOX 20669
ROANOKE, VIRGINIA 24018
PHONE: (540) 774-4411
FAX: (540) 772-9445
E-MAIL: MAIL@LUMSDENPC.COM

PART OF THE MUDLICK CREEK INTERCEPTOR PROJECT

# SANITARY SEWER PLAN & PROFILE WORKING DRAWING

# CLARA AVENUE PHASE 3

PREPARED FOR

WESTERN VIRGINIA WATER AUTHORITY

SITUATED IN THE CITY OF ROANOKE, VIRGINIA

| REVISIONS | | |
|---|---|---|
| NO. | DATE | DESCRIPTION |
| 1 | | |
| 2 | | |
| 3 | | |
| 4 | | |
| 5 | | |

DATE: April 9, 2008
SCALE: 1" = 50' H 1"=10' V
COMMISSION NO: 2008-039
SHEET 1 OF 2

AS-BUILTS

w:\drawings\2008\08039\eng\08039pr01.dwg